

Chem-Tech® Consultants, Inc.

Environmental Engineering & Safety Compliance



March 4, 2017

Ohio EPA
Northeast District Office
2110 East Aurora Road
Twinsburg, Ohio 44087

RE: **Lead Mapping**

Enclosed is the lead map and sample site list for Kidron, Inc. in Wayne County. If you have any questions or concerns, please don't hesitate to call.

Sincerely,
Chem-Tech Consultants, Inc.

Nathaniel D. Hoam
EHS Compliance Officer

Entity: Kidron
Doc Type: REPORT
Doc Subtype: _____
Program: _____
County: Wayne
Secondary ID: OH 8539912 - Kidron Well 1
OH 8540012 - Kidron Well #2
OH 8540112 - Kidron Well #3

RECEIVED

MAR 07 2017

OHIO EPA NEDO


eDOC → 3 times

Well 1: PWS OH8539912
 Well 2: PWS OH8540012
 Well 3: PWS OH8540112

P0.2

KIDRON, INC.
 1349 EMERSON ROAD
 KIDRON, OHIO 44656
 216-837-3011
 1-800-321-5421

PLOT LAYOUT
 KIDRON OHIO PLANT LAYOUT
 REVISED DATE: 12-6-99

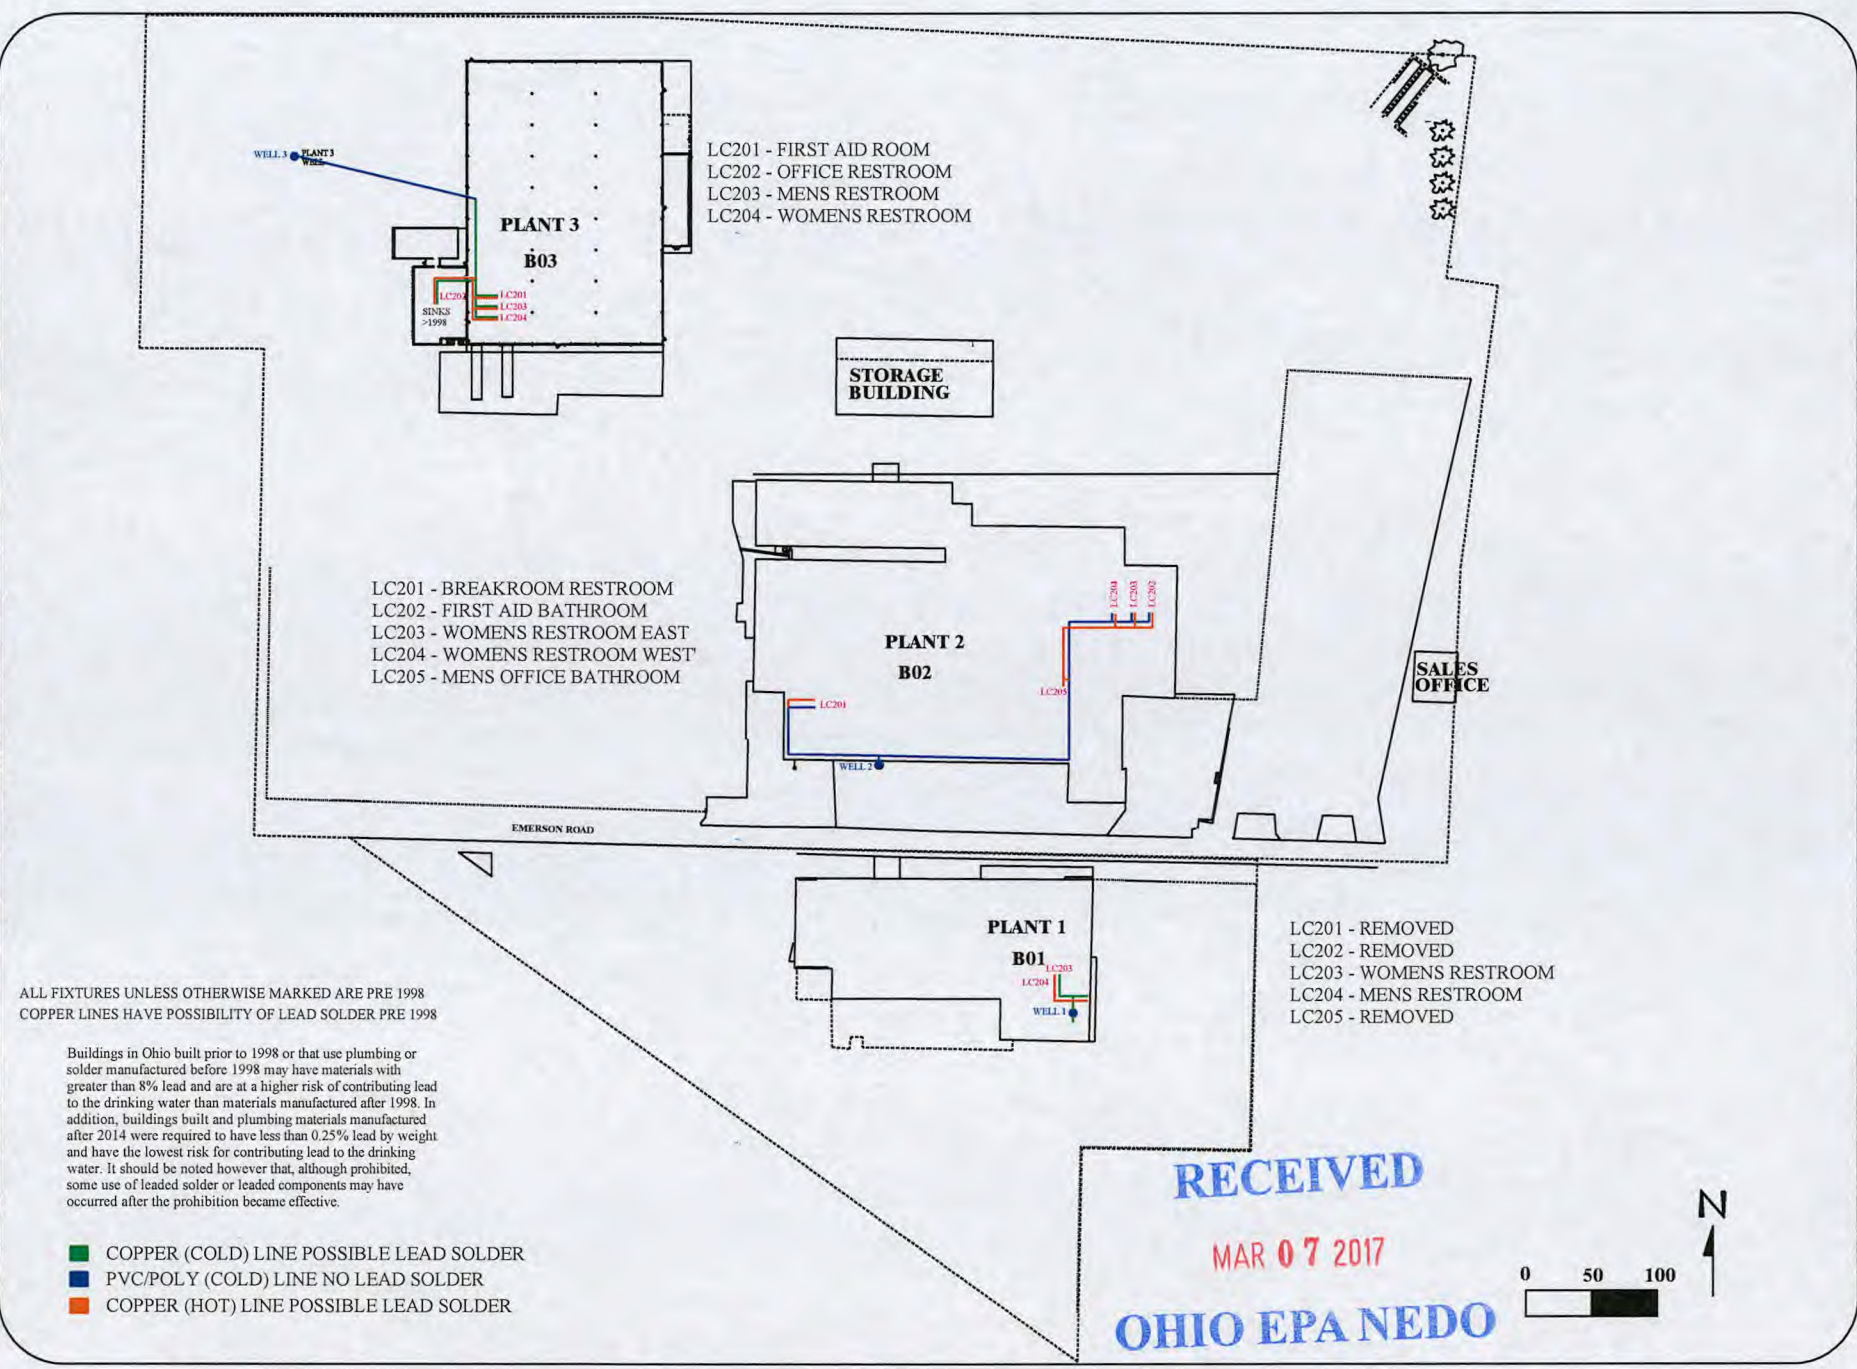

LC201 - FIRST AID ROOM
 LC202 - OFFICE RESTROOM
 LC203 - MENS RESTROOM
 LC204 - WOMENS RESTROOM

LC201 - BREAKROOM RESTROOM
 LC202 - FIRST AID BATHROOM
 LC203 - WOMENS RESTROOM EAST
 LC204 - WOMENS RESTROOM WEST
 LC205 - MENS OFFICE BATHROOM

LC201 - REMOVED
 LC202 - REMOVED
 LC203 - WOMENS RESTROOM
 LC204 - MENS RESTROOM
 LC205 - REMOVED

ALL FIXTURES UNLESS OTHERWISE MARKED ARE PRE 1998
 COPPER LINES HAVE POSSIBILITY OF LEAD SOLDER PRE 1998

Buildings in Ohio built prior to 1998 or that use plumbing or solder manufactured before 1998 may have materials with greater than 8% lead and are at a higher risk of contributing lead to the drinking water than materials manufactured after 1998. In addition, buildings built and plumbing materials manufactured after 2014 were required to have less than 0.25% lead by weight and have the lowest risk for contributing lead to the drinking water. It should be noted however that, although prohibited, some use of leaded solder or leaded components may have occurred after the prohibition became effective.

- COPPER (COLD) LINE POSSIBLE LEAD SOLDER
- PVC/POLY (COLD) LINE NO LEAD SOLDER
- COPPER (HOT) LINE POSSIBLE LEAD SOLDER

RECEIVED
 MAR 07 2017
OHIO EPA NEDO

