

Blue - Cold  
Red - Hot

SOUTH


RECEIVED

MAR 07 2017

OHIO EPA NEDO

Built in 1994

Copper water lines

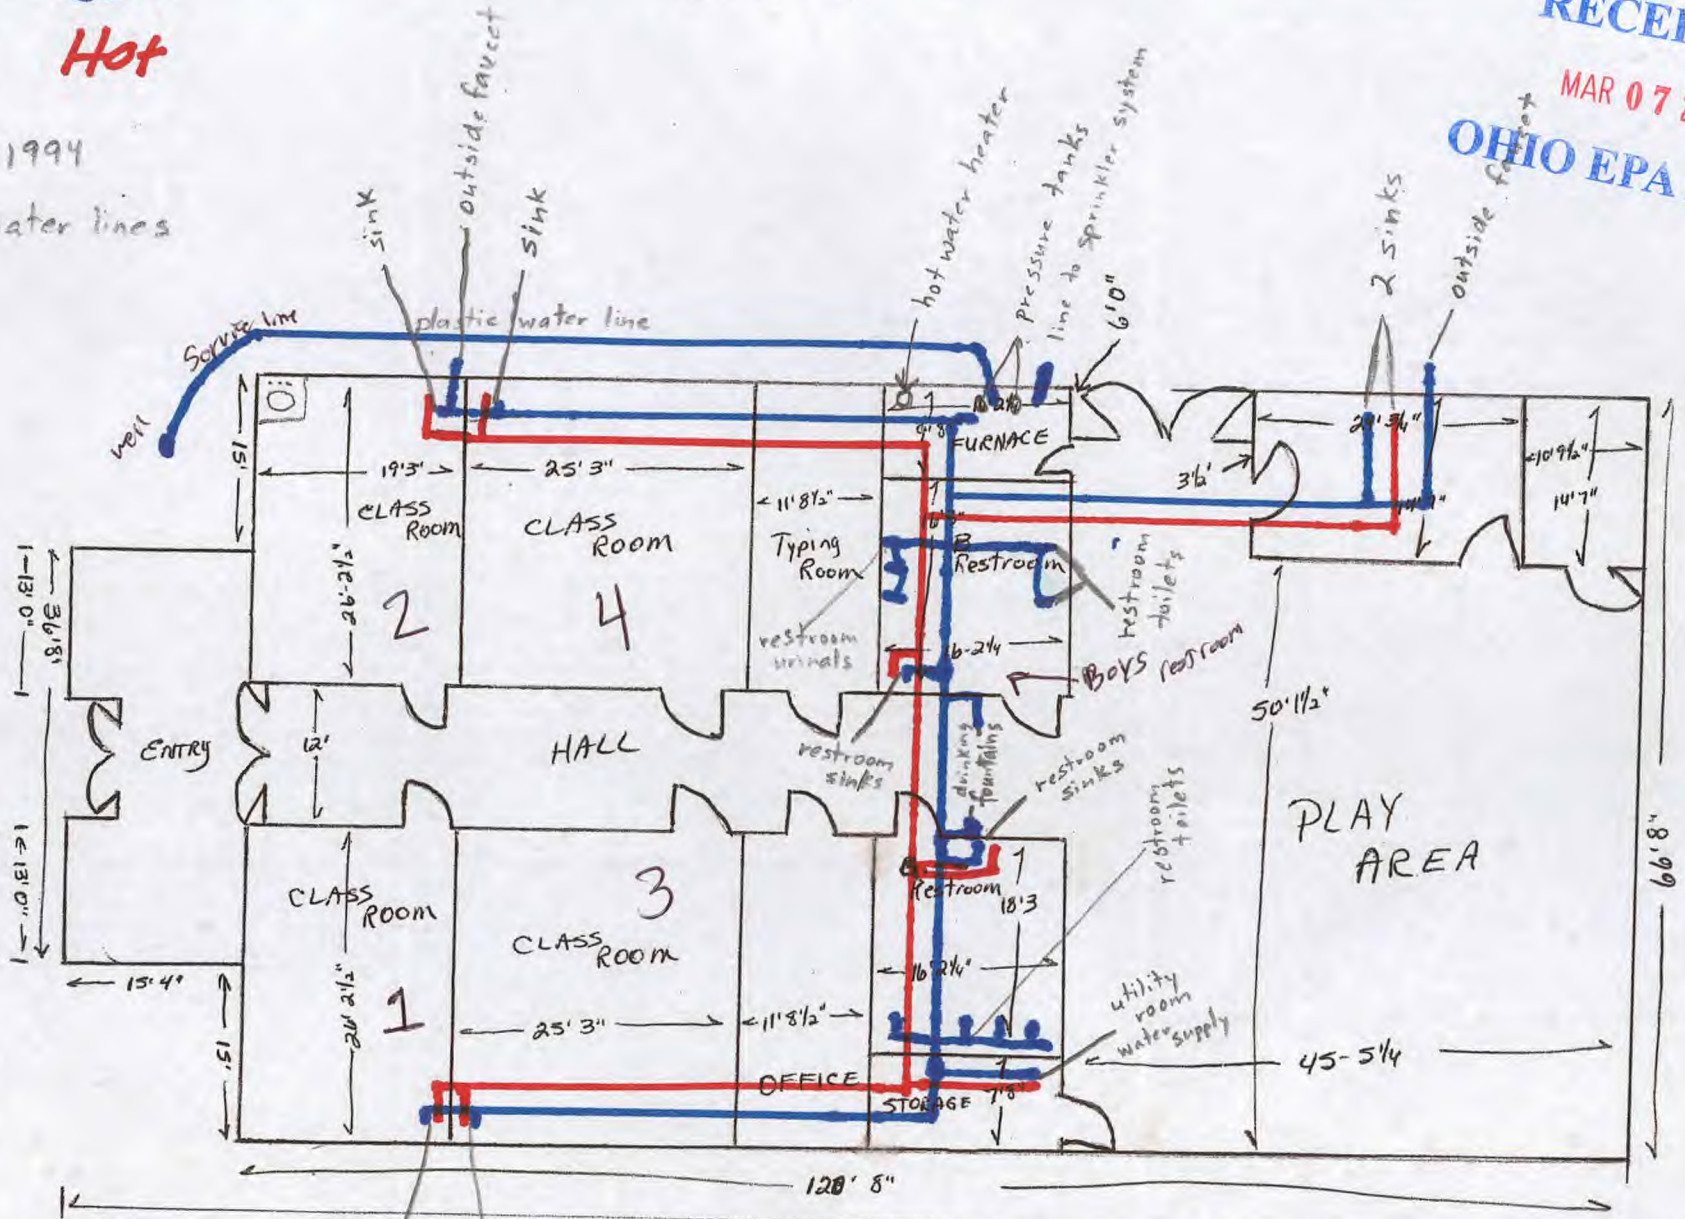

EAST

WEST

Drive

Road

Entity: Valley View Mennonite  
 Doc Type: RRPM  
 Doc Subtype: \_\_\_\_\_  
 Program: DDAGW  
 County: Wayne  
 Secondary ID: OH8556312

Valley View Mennonite School  
 15723 Hackbert Rd  
 Dalton OH 44618  
 330 857 0612

NORTH

OH8556312