

Chem-Tech[®] Consultants, Inc.

Environmental Engineering & Safety Compliance



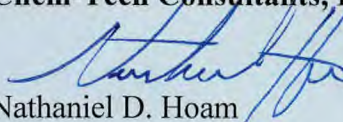
March 4, 2017

Ohio EPA
Northeast District Office
2110 East Aurora Road
Twinsburg, Ohio 44087

RE: *Lead Mapping*

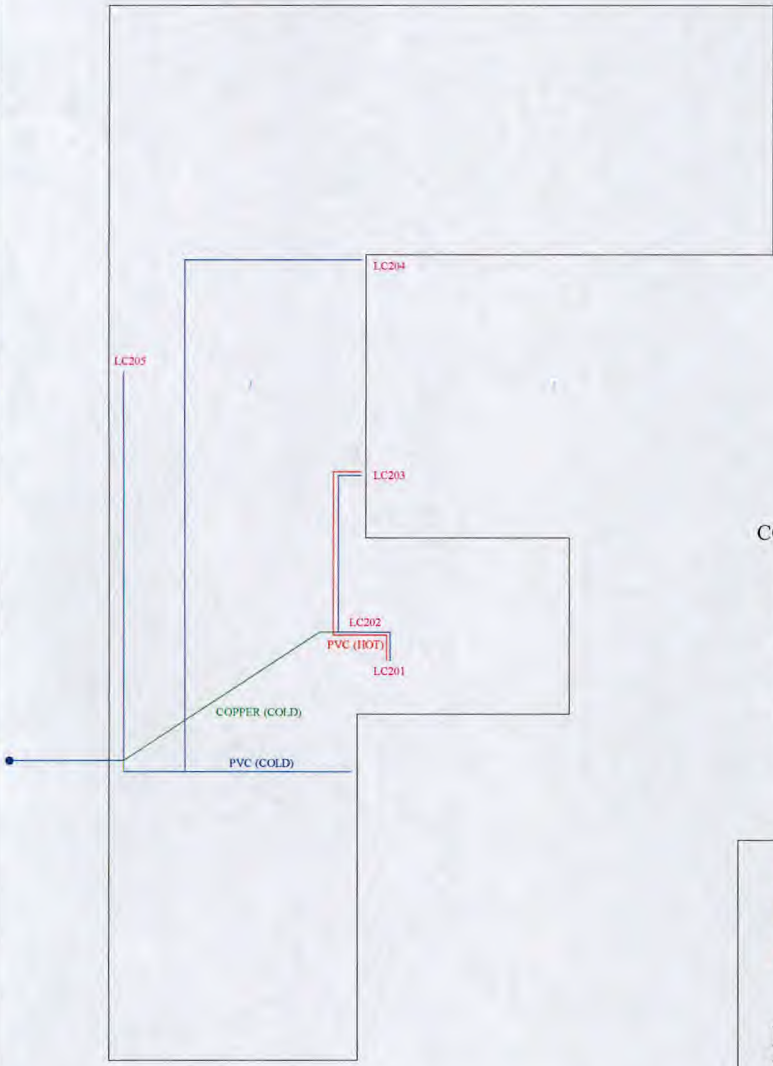
Enclosed is the lead map and sample site list for Advanced Drainage Systems in Wayne County.
If you have any questions or concerns, please don't hesitate to call.

Sincerely,
Chem-Tech Consultants, Inc.


Nathaniel D. Hoam
EHS Compliance Officer




RECEIVED
MAR 07 2017
OHIO EPA NEDO

Entity: Advanced Drainage Systems
Doc Type: REPORT
Doc Subtype: _____
Program: DDAGW
County: Wayne
Secondary ID: 0185101312



COPPER LINES HAVE POSSIBILITY OF LEAD SOLDER PRE 1998

Buildings in Ohio built prior to 1998 or that use plumbing or solder manufactured before 1998 may have materials with greater than 8% lead and are at a higher risk of contributing lead to the drinking water than materials manufactured after 1998. In addition, buildings built and plumbing materials manufactured after 2014 were required to have less than 0.25 % lead by weight and have the lowest risk for contributing lead to the drinking water. It should be noted however that, although prohibited, some use of leaded solder or leaded components may have occurred after the prohibition became effective.

	COPPER LINE POSSIBLE LEAD SOLDER
	PVC (COLD) LINE NO LEAD SOLDER
	PVC (HOT) LINE NO LEAD SOLDER

LC201 - OFFICE RESTROOM
LC202 - MENS RESTROOM
LC203 - KITCHEN
LC204 - ICE MACHINE
LC205 - TAP #2

MARCH 4, 2017

ADVANCED DRAINAGE SYSTEMS
3113 OLD LINCOLNWAY WEST
WOOSTER, OHIO 44691
(330) 264-4949

RECEIVED
MAR 07 2017
OHIO EPA NEDO

PWS OH 8561312