



Lead Mapping for the Village of Thornville

*System installed in 1951 with the requirement of all service lines to be copper. Copy of Notice to Contractors enclosed.

*Main water lines are of Asbestos Cement class 150 and C900 PVC pipe.

*Lead sampling sites are marked on map with red dot. A list of addresses with their sample id designation is enclosed.

RECEIVED
MAR 7 2017
Ohio Environmental
Protection Agency
Southeast District

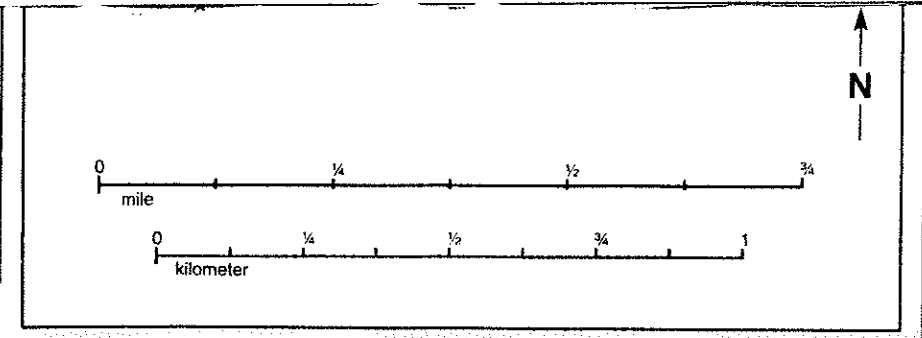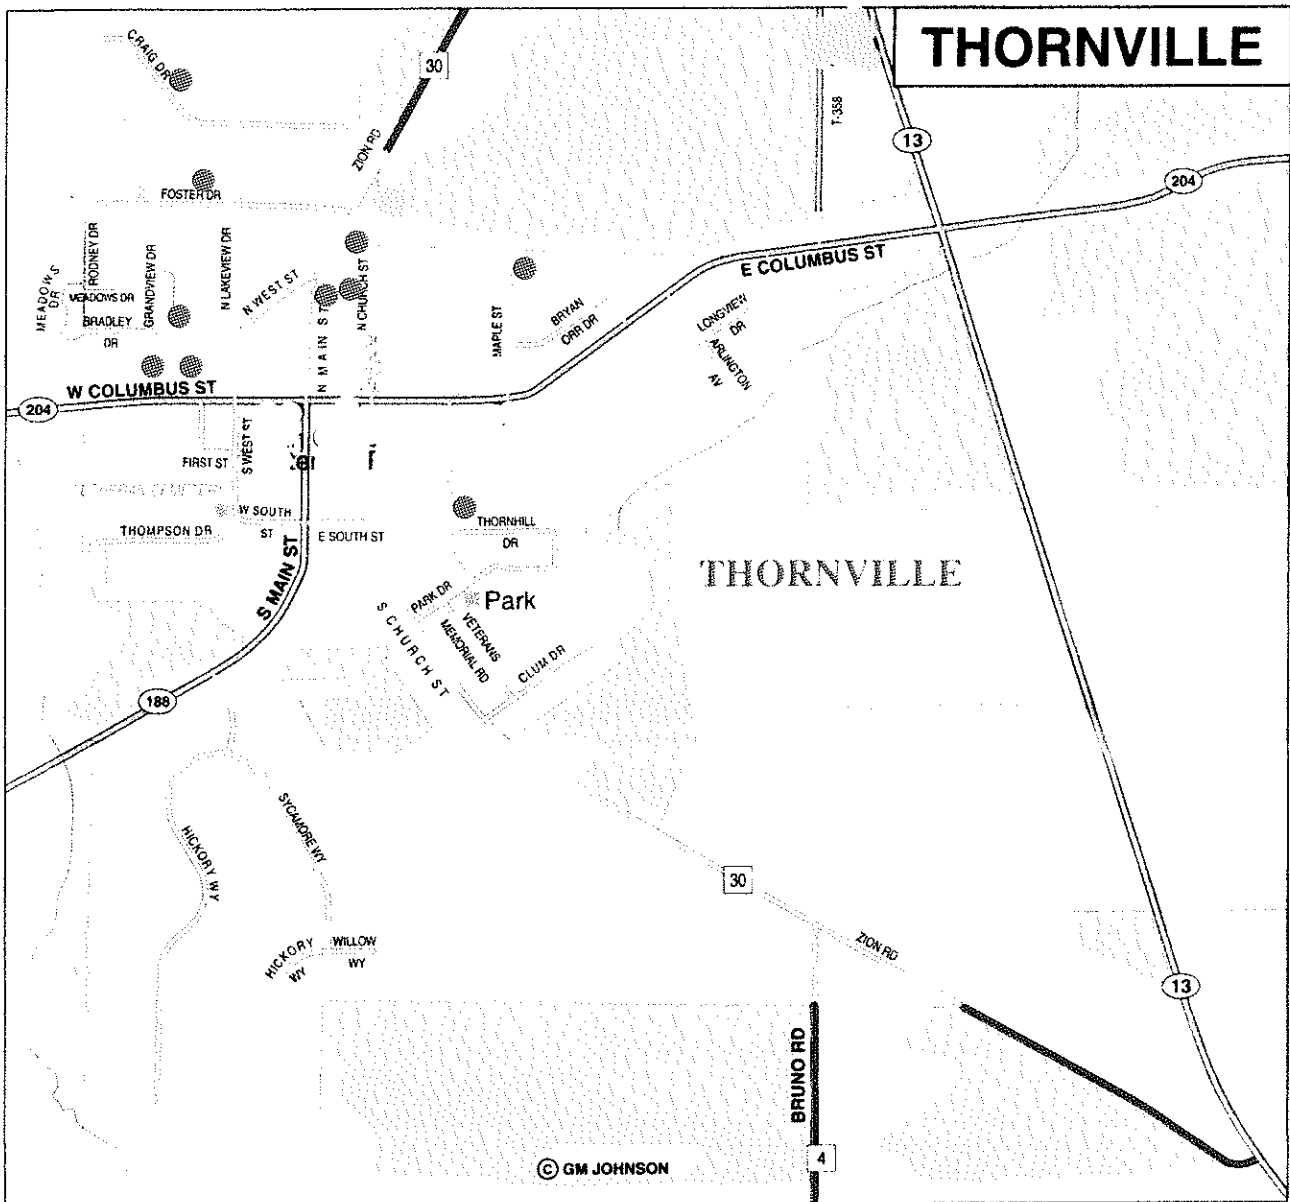

RECEIVED
 MAR 7 2017
 Ohio Environmental
 Protection Agency
 Southeast District

RECEIVED

MAR 7 2017

Ohio Environmental
Protection Agency
Southeast District

NOTICE TO CONTRACTORS

Notice is hereby given that the Village Council of the Village of Thornville, Perry County, Ohio, will receive sealed bids or proposals for materials installed and complete construction of its waterworks system in accordance with the drawings and specifications now on file in the office of the Clerk of said Village, until 12:00 o'clock noon E.S.T., on the 3/12 day of March, 1957. At said time, at the office of the Clerk said bids will be opened by said Council.

THE ITEMS TO BE BID ON ARE AS FOLLOWS:

1. 75,000 Gallon Elevated Tank.
2. Tank Foundations.
3. Approximately 14,700 lineal feet of pipe and fittings installed.
4. Approximately 6,400 lineal feet of Copper Service Pipe.
5. Water Supply, Pumping Equipment and Controls.
6. Approximately 5 Meters, Yokes, Boxes and Covers.
7. Approximately 185 Curb Stops and Boxes.
8. Approximately 180 Corporation Cocks.
9. 19 Fire Hydrants.
10. 29 Gate Valves and Boxes.
11. 1 Hypochlorinator,
12. 1 - 3 inch Master Meter.
13. Pump House.
14. Treatment Plant.

Each bidder shall file with his bid a certified or cashier's check or bidding bond made payable to the Treasurer, Village of Thornville, Ohio, in an amount equal to ten (10%) per cent of the total sum of his bid, as a guarantee that the contract will be accepted by him and that he will execute a surety bond for the total amount of contract, insuring the performance of his work, material and equipment according to the specifications and contract. The bonds shall meet the approval of the Village Council of Thornville, Ohio.

The checks or bonds of the unsuccessful bidders will be returned to them within thirty (30) days after the date the bids are accepted or rejected.

Payment for the materials, equipment and labor will be made in cash as shown under "Method of Payment" shown on page 4 of said specifications, from funds for said purpose from the sale of revenue bonds.

The Village Council of Thornville, Ohio, reserves the right to reject any and all proposals and to waive formalities.

The Council also reserves the right to hold any and all proposals for a period of not more than thirty (30) days, which proposals shall remain valid and in full force and effect during this period.

Bidder shall fill in the proposal blanks attached to the specifications and no bid shall be made in any other manner.

Each bidder shall be prepared to properly enter into the construction contract and begin work within five (5) days from the date of notice by the Village Council. The Contractor shall, then, continuously and diligently prosecute the work to completion.

Three (3) days prior to the time and date set for receiving bids, each construction bidder shall submit an experience and pre-qualification record, prepared on a form which has been prepared and approved by the Village Council of the Village of Thornville, Ohio, which form will be furnished free upon request or application to the Clerk of the Village of Thornville, Ohio, or Snyder, McLellan, Rhoads and Watson, Hillsboro, Indiana.

Wage rates shall conform to the wage scale set for Thornville, Ohio.

Complete specifications, plans, material sheets, proposal blanks and noncollusion affidavit for this project may be obtained from Snyder, McLellan, Rhoads and Watson, P. O. Box 138, Hillsboro, Indiana, for the sum of \$15.00. A refund of \$7.50 will be made upon return of the plans and specifications to the office of said company, in good condition, not later than thirty (30) days after the date of receiving proposals. They may also be inspected at the office of the Clerk.

Dated this 9th day of July, 19 57

Village of Thornville, Ohio

Attest:

Mayor

H. C. Clark
Clerk

