


MHEBY INC.
OH 4943512

4439 S+R+ 29. WEST JEFFERSON OH MADISON CO.
614-879-6901 OP OF REC- PAT HICKMAN-614-578-6203

MHEBY WAS IN BUSINESS PRIOR THE OUTER BLDG AND
PLUMBING WAS RECONSTRUCTED IN 1995. ● - GREEN HOT WATER LINES
● - RED COLD WATER LINES

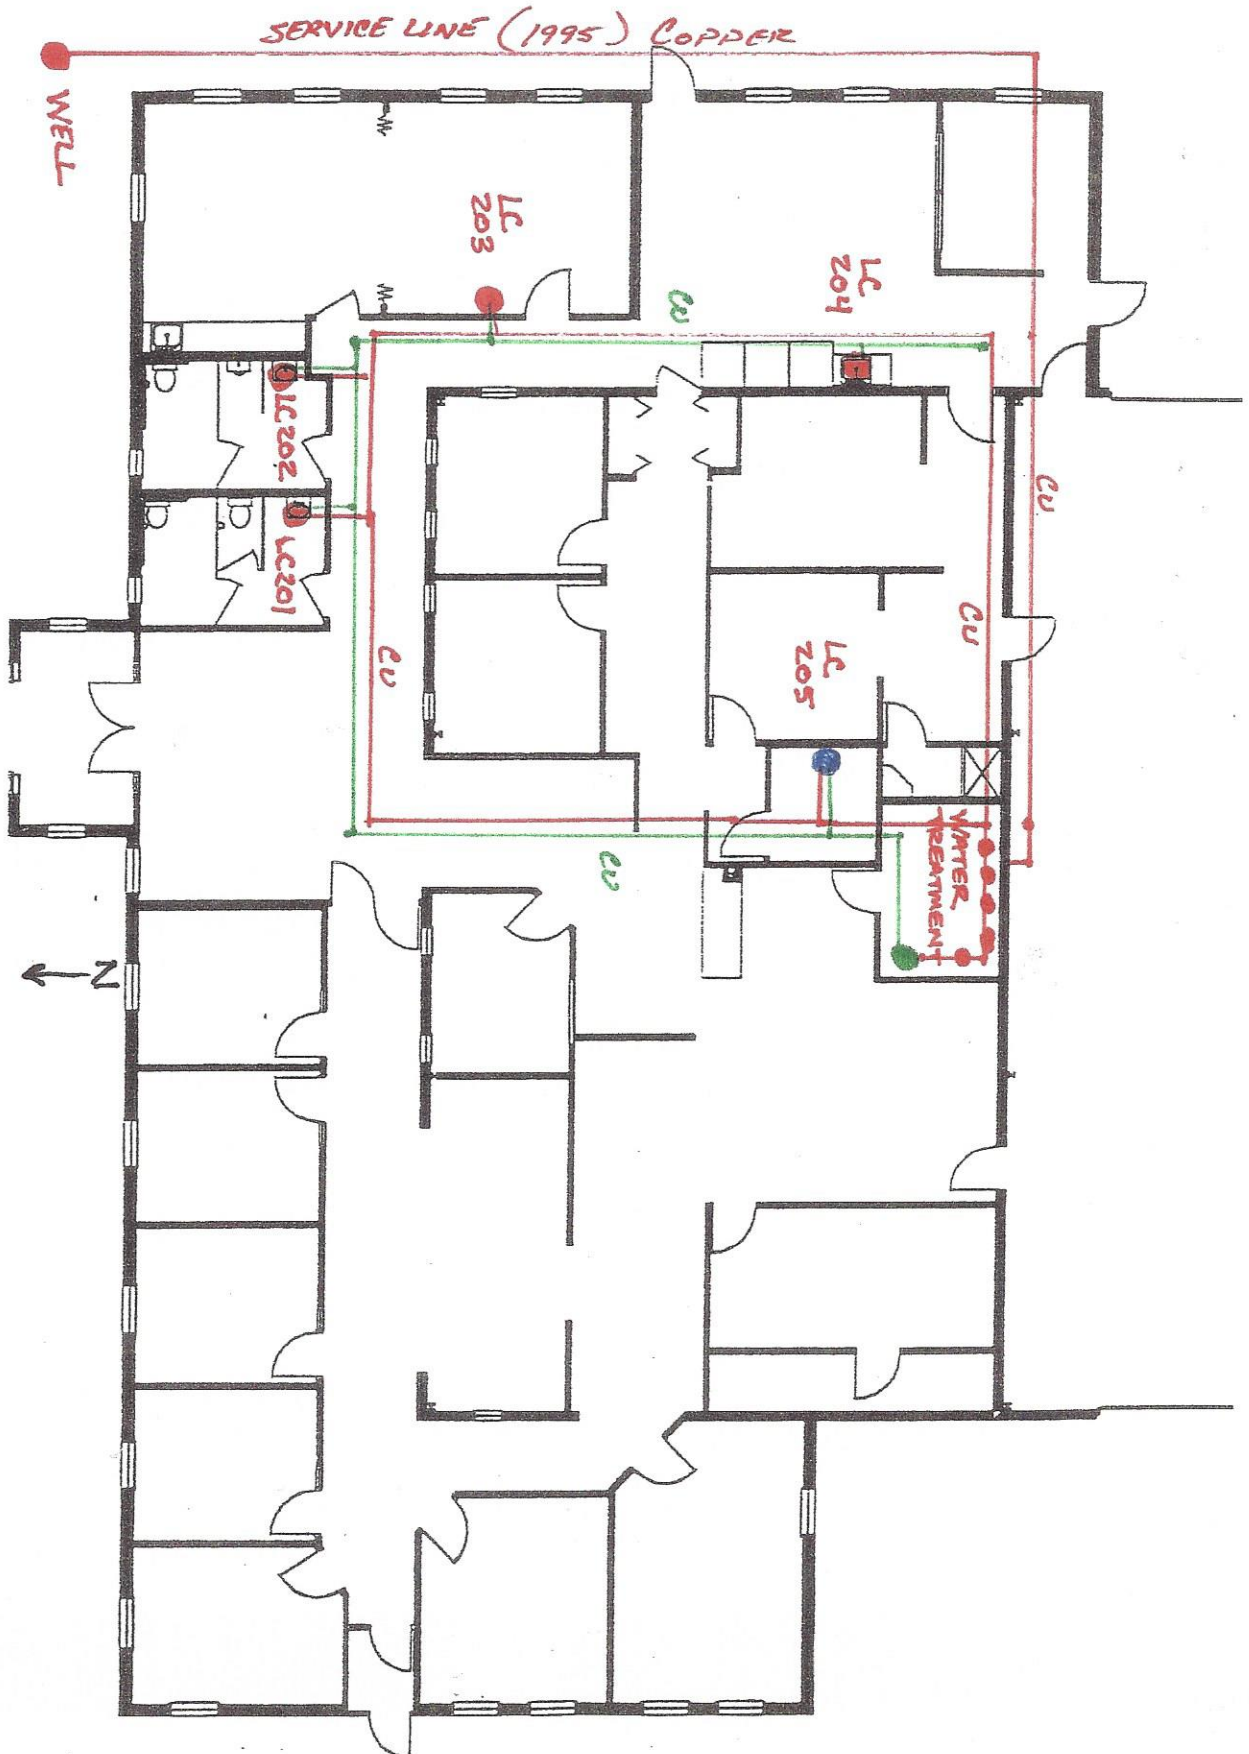

“Buildings in Ohio built prior to 1998 or that use plumbing material or solder manufactured before 1998 may have materials with greater than 8% lead and are at a higher risk of contributing lead to the drinking water than materials manufactured after 1998. In addition, buildings built and plumbing materials manufactured after 2014 were required to have less than 0.25% lead by weight and have the lowest risk for contributing lead to the drinking water. It should be noted however that, although prohibited, some use of leaded solder or leaded components may have occurred after the prohibitions became effective.”