


North

SOUTH APPLE CREEK ROAD

SOUTH APPLE CREEK ROAD

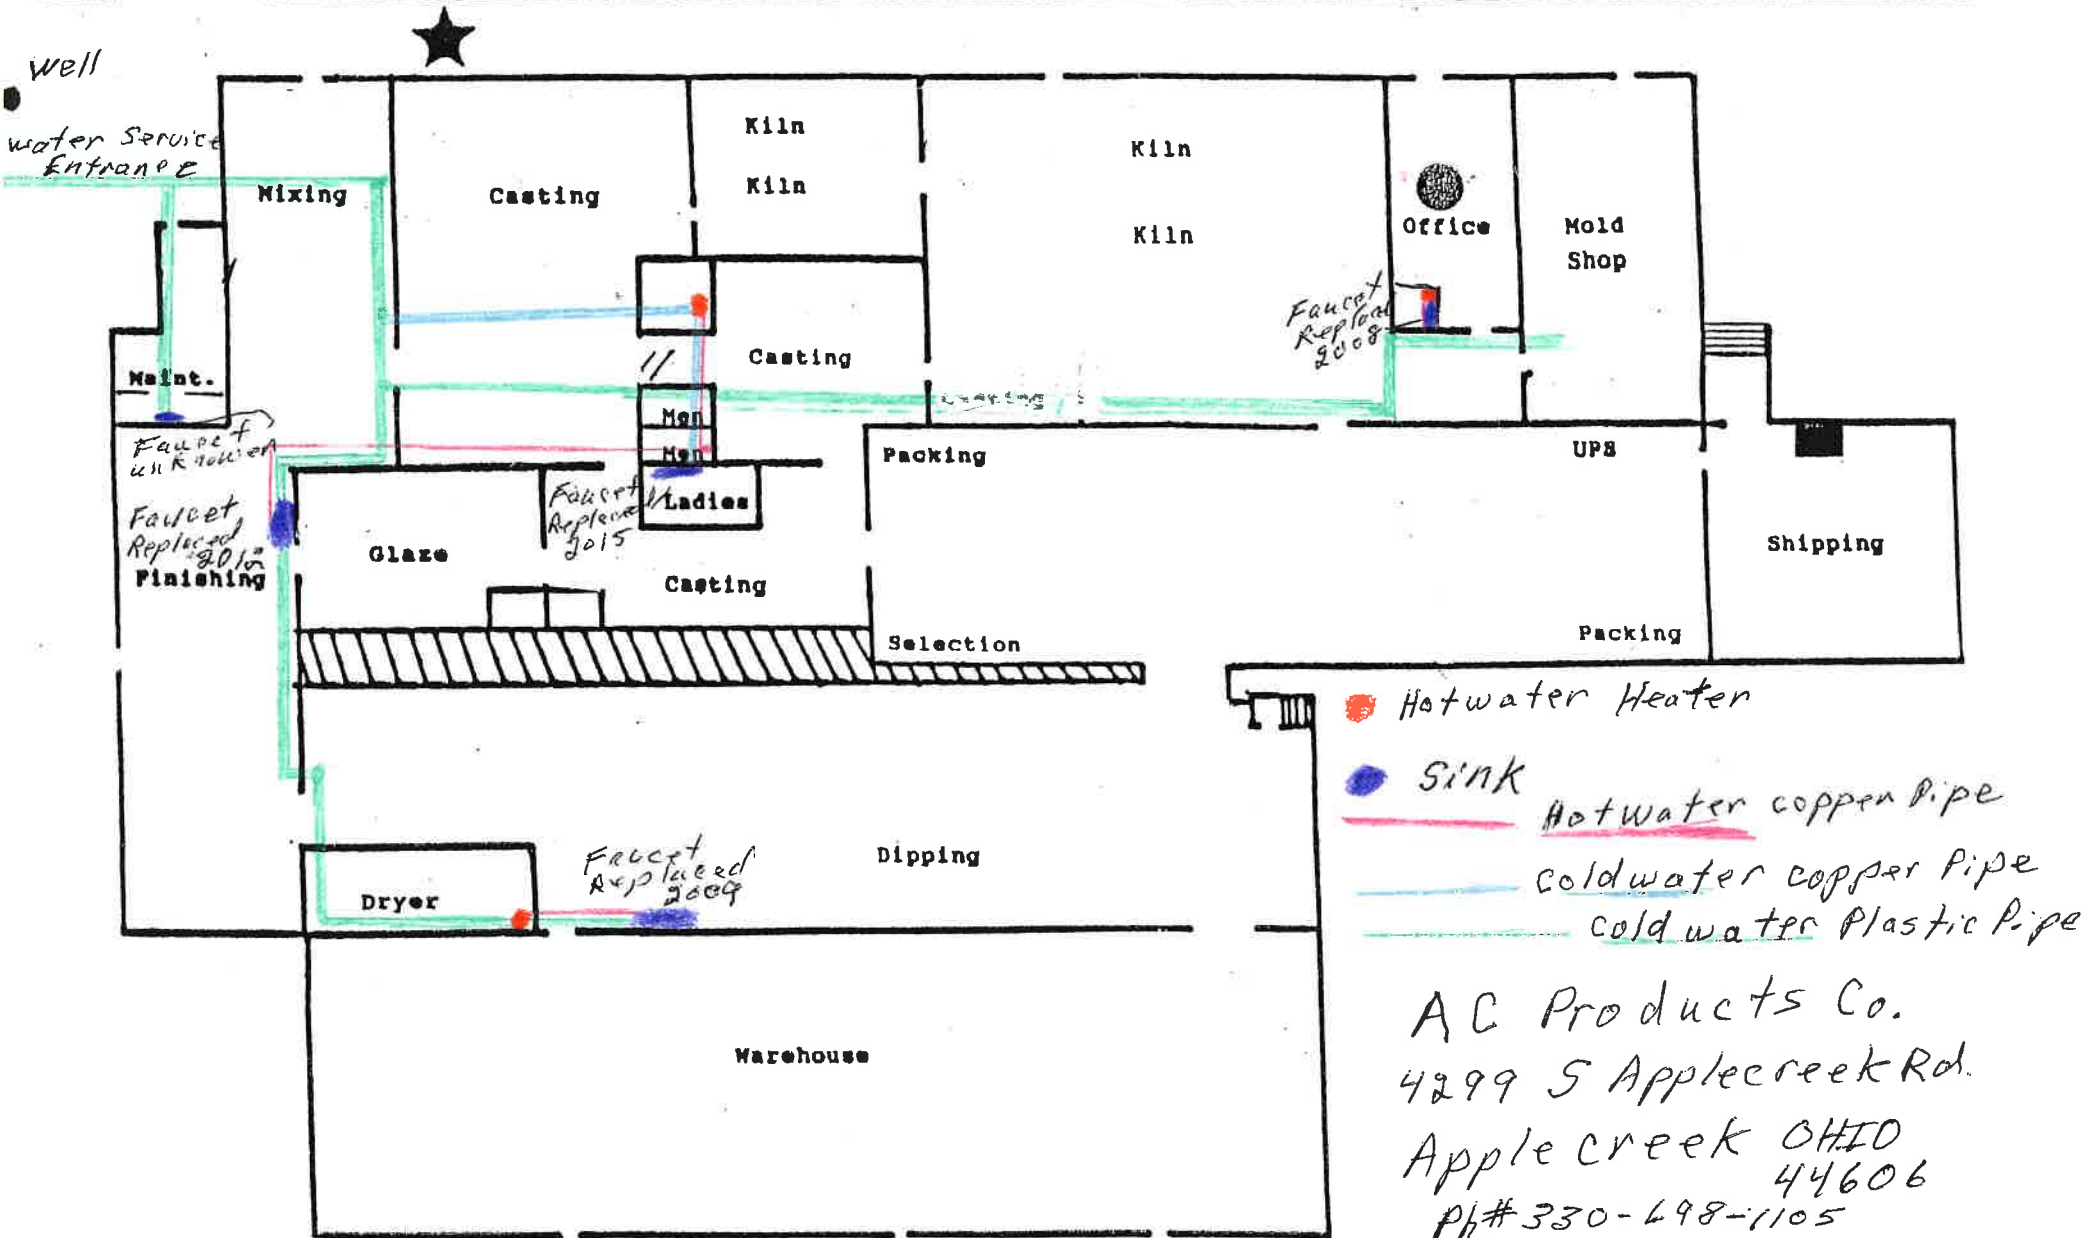

- Hotwater Heater
- Sink
- Hotwater copper Pipe
- Coldwater copper Pipe
- Coldwater Plastic Pipe

AC Products Co.
 4299 S Applecreek Rd.
 Apple Creek OHIO 44606
 Ph# 330-698-1105
 PWS ID: OH 8555612