ALL LINES WERE INSTALLED BEFORE 1983

RECEIVED
MAR 0 6 2017
OHIO EPA NEDO

OH3842012

East Holmes Local Schools

Charm Elementary School
4416 SR 557
Charm, OH 44617

IRN: 005991
Phone: 330-893-2300

Emergency contacts:
Casey Travis, Principal
330-440-3069

Troy Phillips, Maintenance
330-432-7940

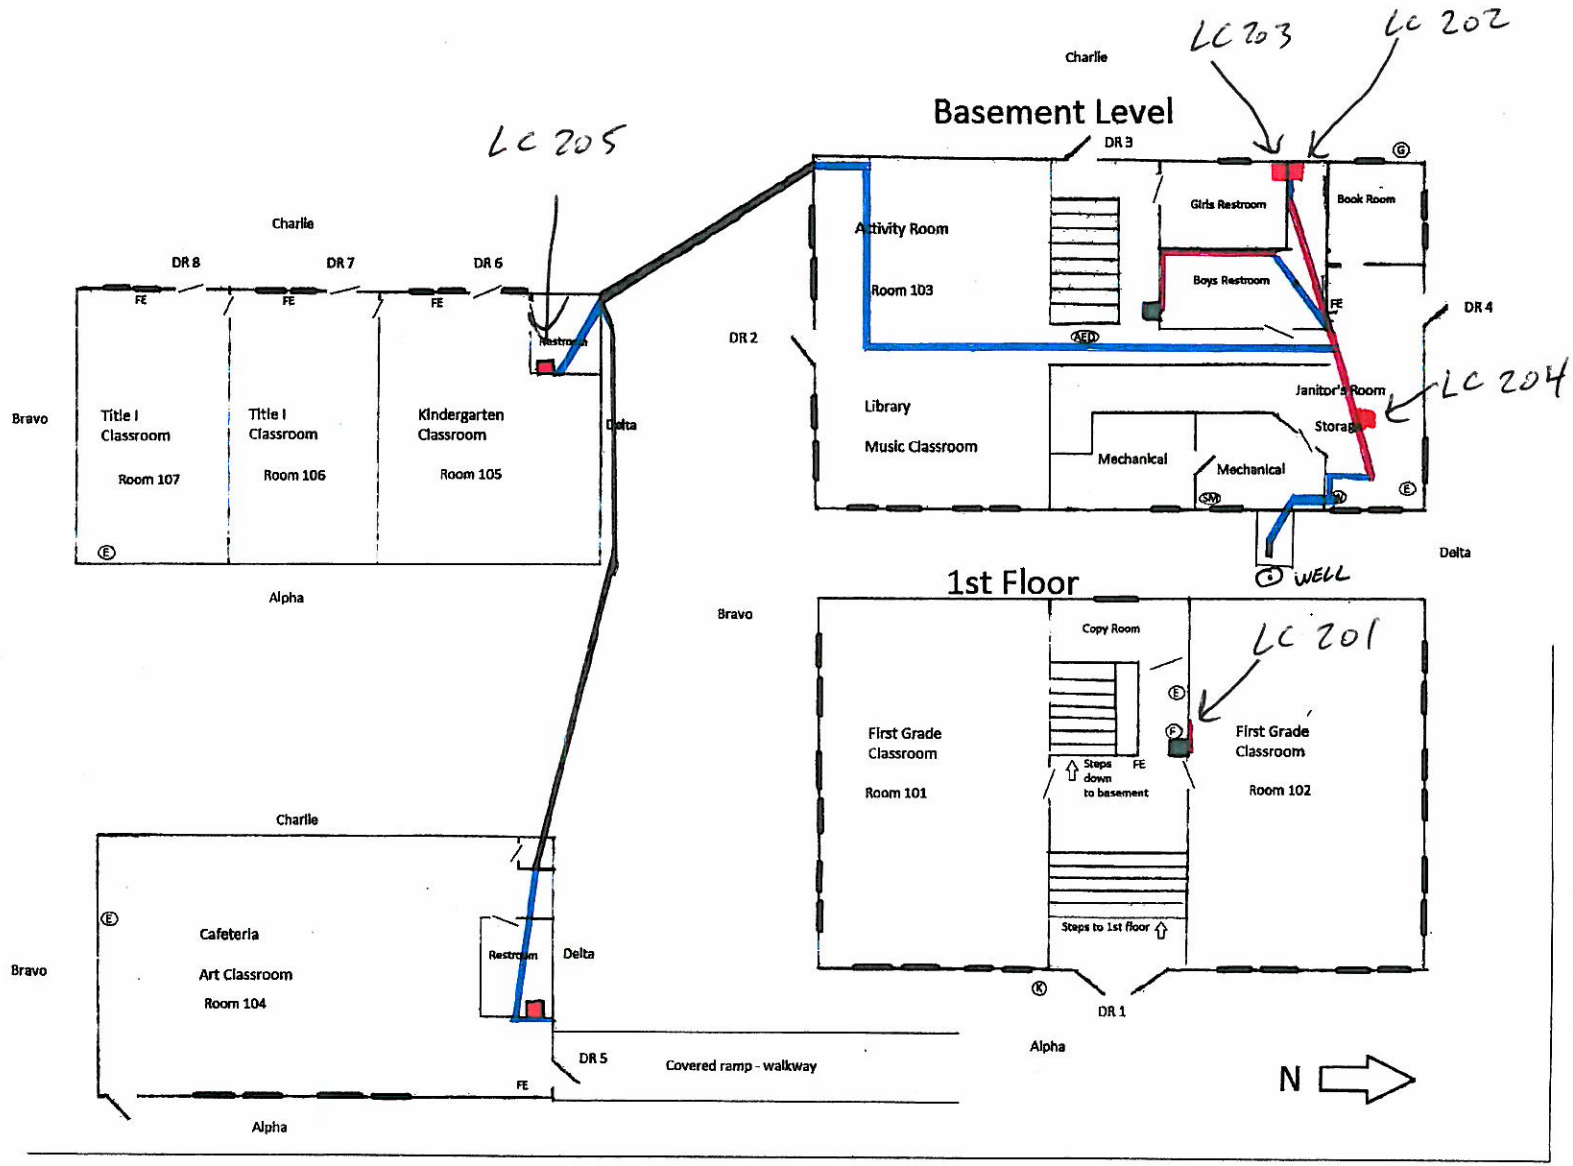

- AED Location of AED
- E Electrical Shutoff
- F Fire Alarm Panel
- G Gas Shutoff
- K Knox Box
- W Water Shutoff
- DR 1 Exterior Doors
- FE Fire Extinguisher
- SM Security Monitoring Control

SINK
DRINKING FOUNTAIN
COPPER
GALV.
PLASTIC