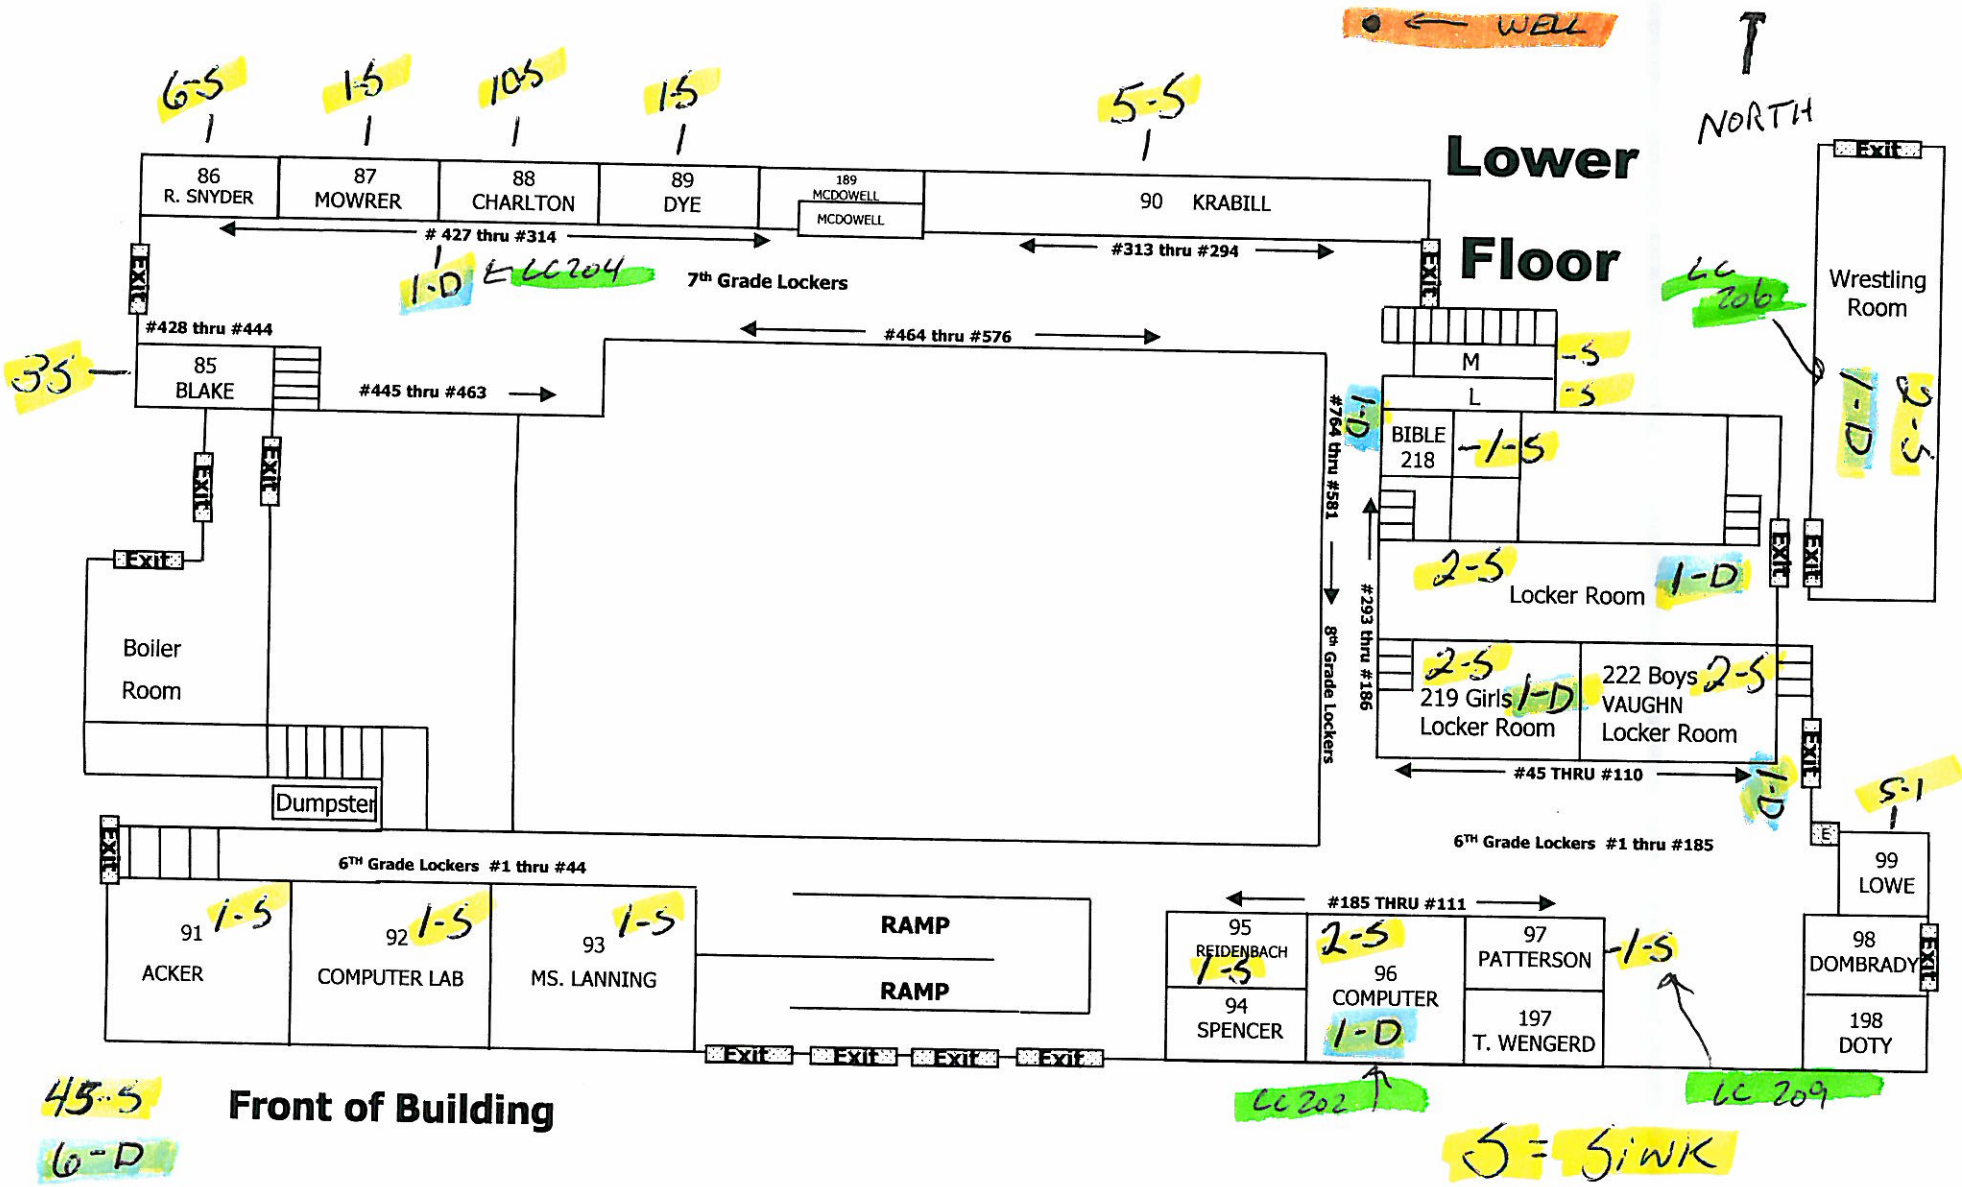

WEST HOLMES MIDDLE SCHOOL
2016-2017

2/2/2017

YEAR BUILT - 1964
PIPING - GALVANIZED

RECEIVED
MAR 06 2017
OHIO EPA NEDO

OH3838712

NORTH

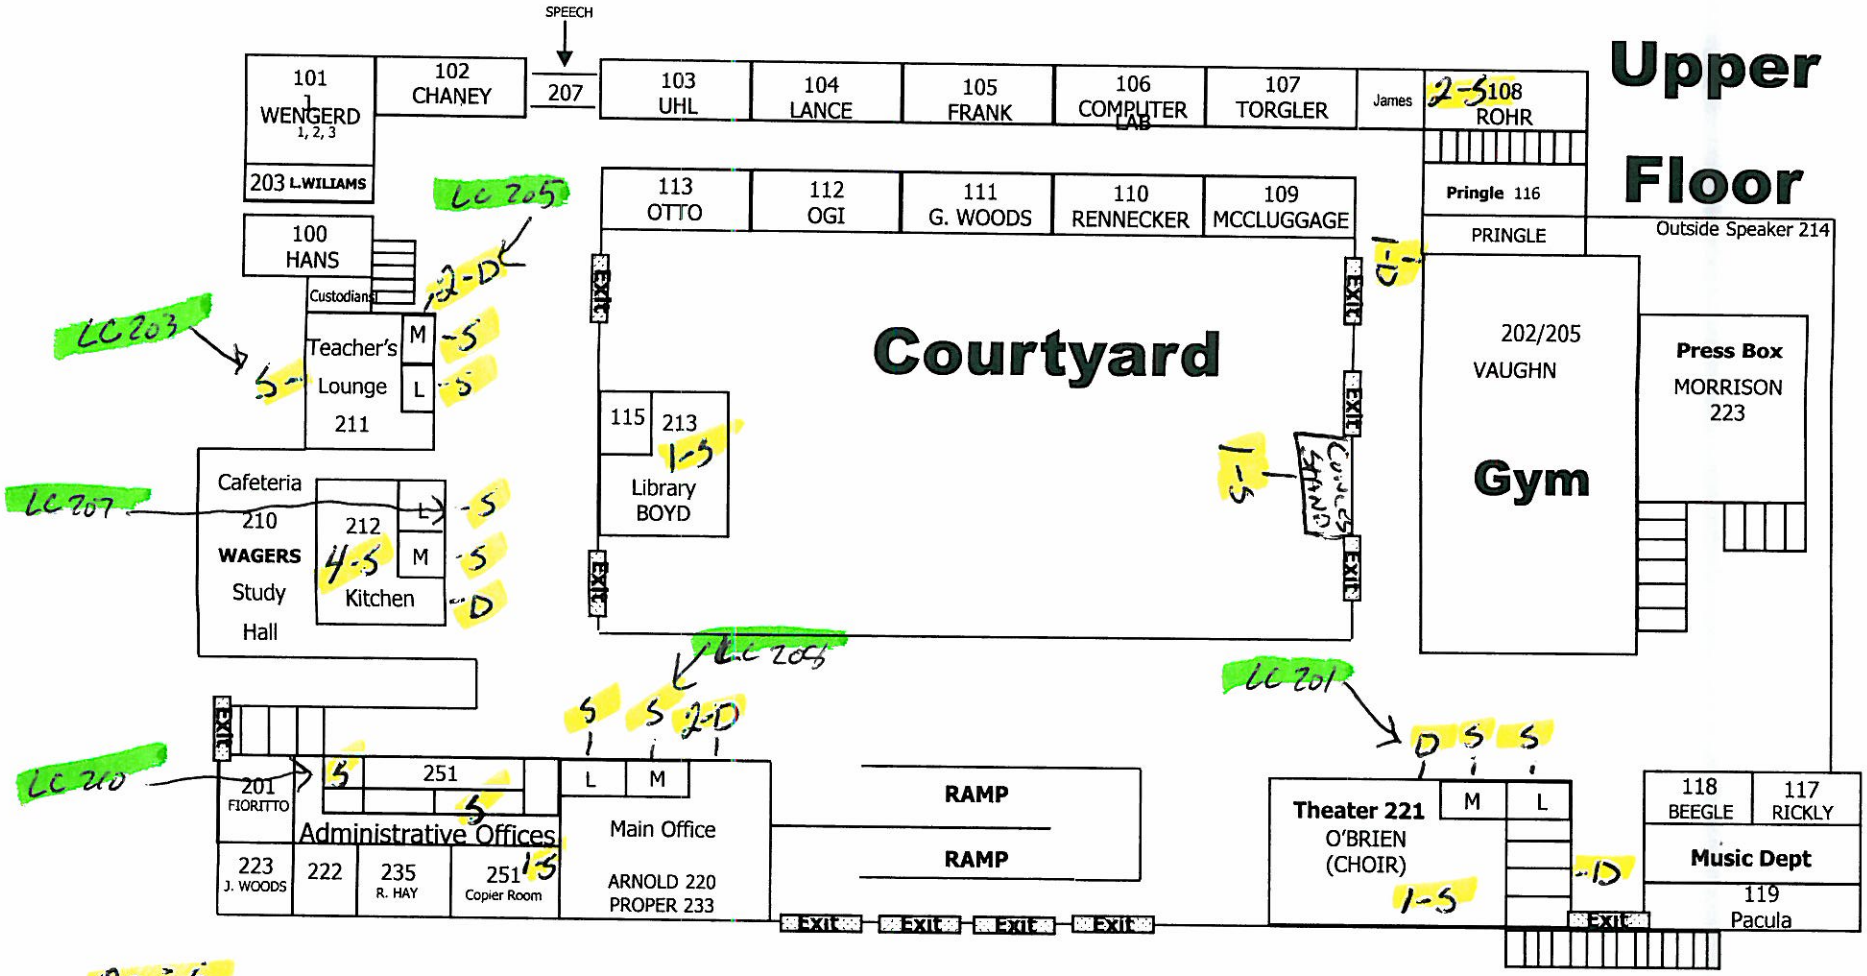

20 : S
7 : D

Front of Building

WEST HOLMES MIDDLE SCHOOL 2016-2017

S - SINK
D - DRINKING FTN.

8/3/16