
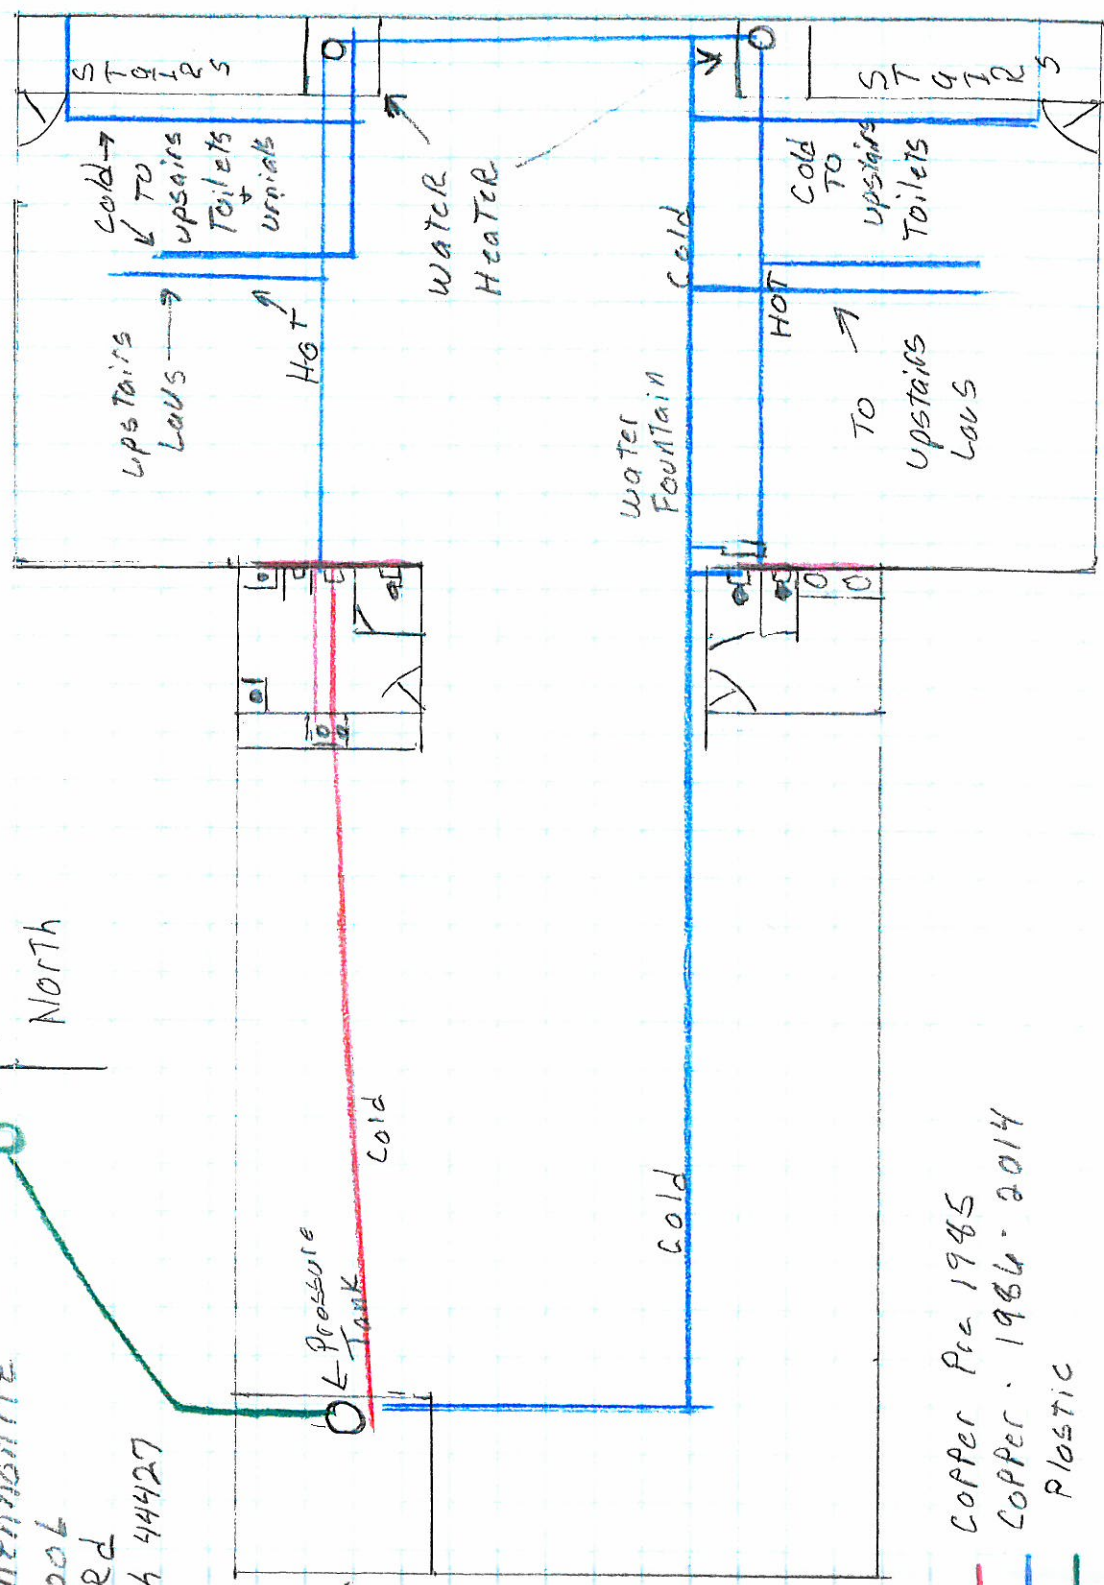


OH 1042212

Glade Run Mennonite Church & School  
7044 Bane Rd  
Kensington OH 44427

Contact  
Don OTTO  
330-853-8012

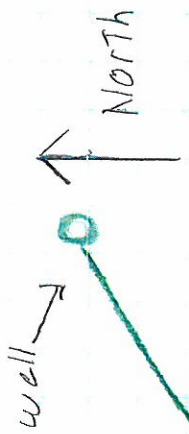

- Copper Pre 1985
- Copper 1986 - 2014
- Plastic

Basement

RECEIVED

MAR 06 2017

OHIO EPA NEDO

Scale 3/32" = 1 foot


Bane  
Rd

NORTH  
↑

Glade Run Mennonite  
Church + School  
7044 Bane Rd  
Kensington Oh 44427

CONTACT  
Dan OTTO  
330-853-8012

Baird  
RC

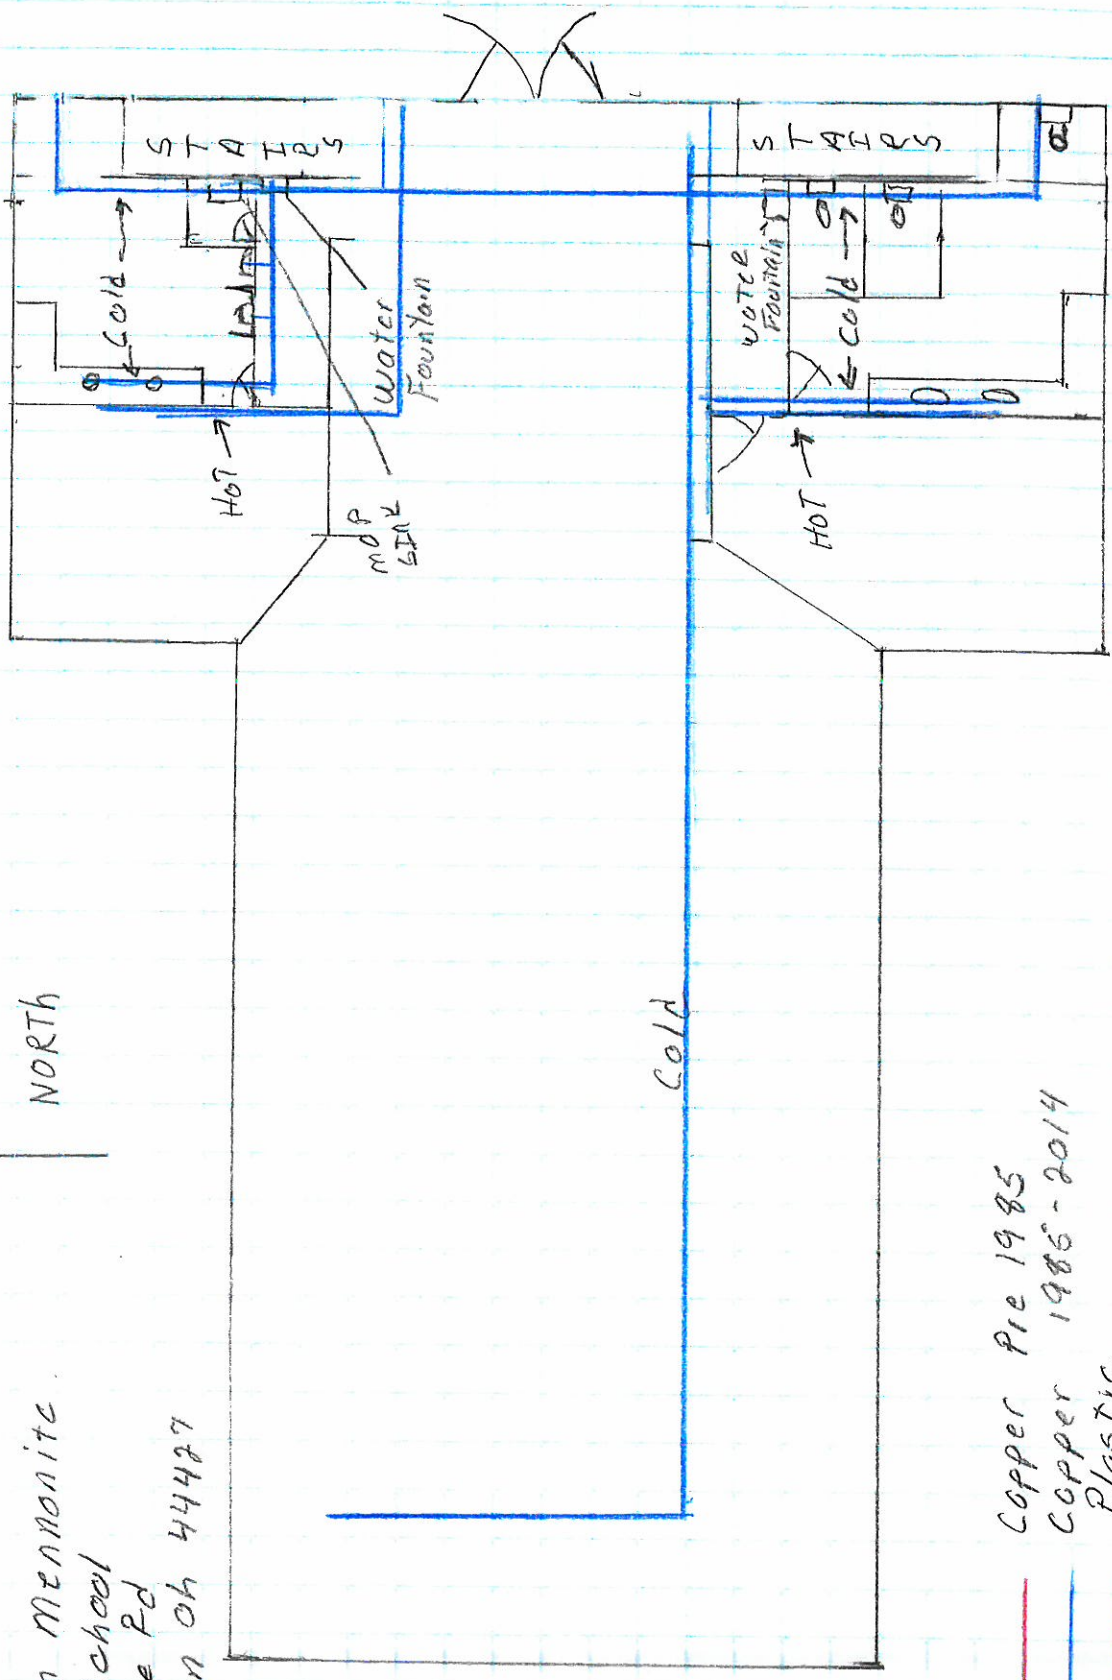

— Copper P/e 1985  
 — Copper 1986-2014  
 — Plastic

RECEIVED

MAR 06 2017

Main Floor

Scale 3/32" = 1 foot

OHIO ELA NEDO