


Breezeway Mobile Manor

LEAD AND COPPER SERVICE LINE MAP
PWS OH1503512
37457 State Route 558
Leetonia OH 44431

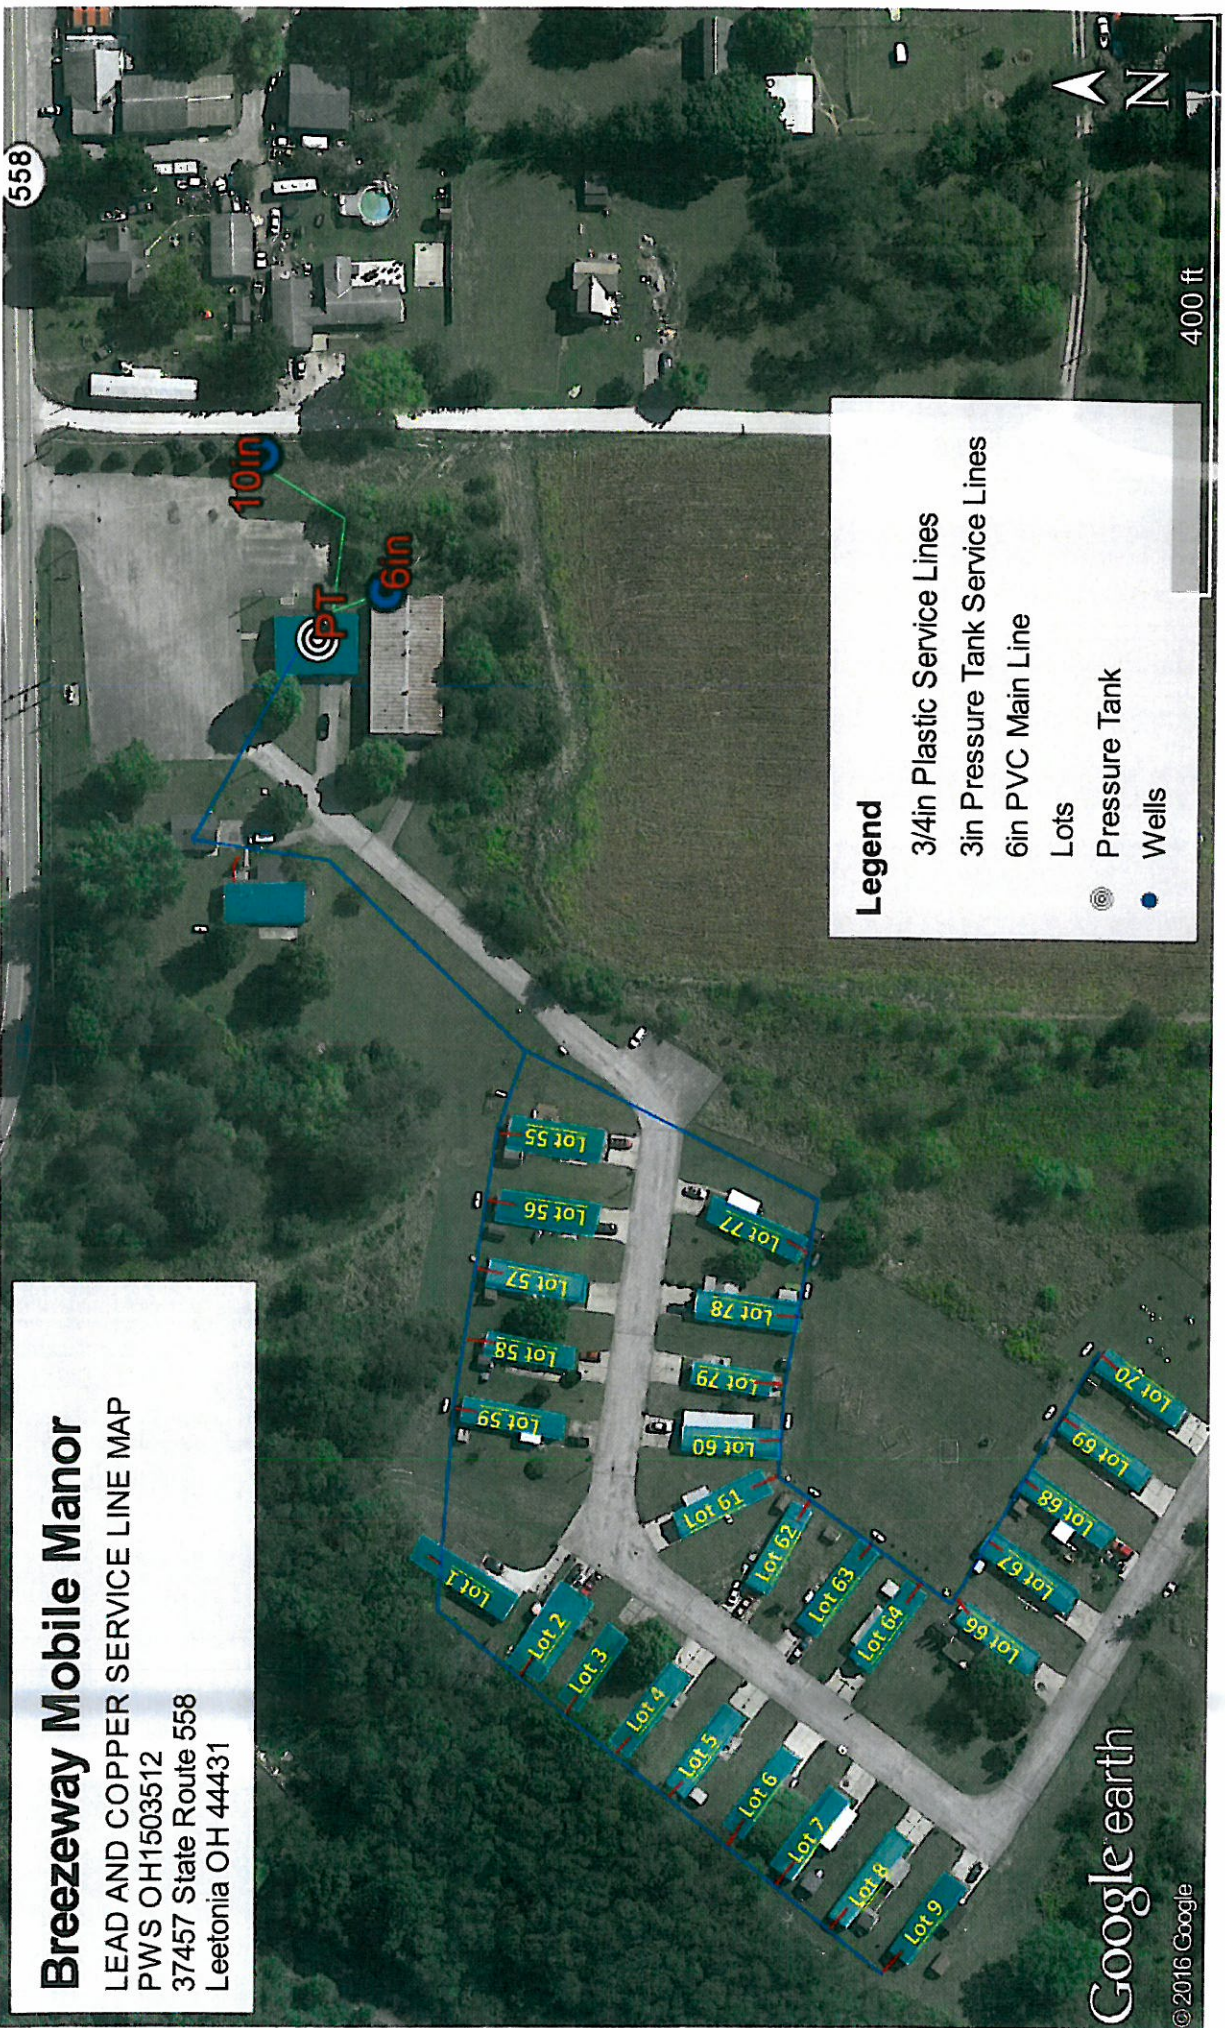

Google earth

© 2016 Google

VERIFICATION FORM FOR COMMUNITY PUBLIC WATER SYSTEMS CLAIMING NO LEAD SERVICE LINES

Systems must also submit a report to the director containing at least both of the following: (1) The applicable map with narrative, and (2) A list of sampling locations used to collect samples as required by Ohio Revised Code (ORC) Section 6109.121 and any rules adopted thereunder, including contact information for the owner and occupant of each sampling site.

Should a water system determine no lead service lines exist in their distribution system, they must provide information stating they reviewed, at the minimum, historical permit records and local ordinances, distribution maintenance records and information pertaining to installation dates or materials for all services lines. This information must be verified below.

I HEREBY CERTIFY THAT THE FOLLOWING METHOD(S) WERE USED TO DETERMINE NO LEAD SERVICE LINES EXIST IN THIS WATER SYSTEM'S DISTRIBUTION SYSTEM, AS REQUIRED BY ORC 6109.121(F):

LEAD SERVICE LINE VERIFICATION

This PWS states they have no lead service lines and has reviewed the following information (select one or more of the following):

- ☐ Historical permit records and/or local ordinances
- ☒ Distribution maintenance records (i.e. meter replacement, waterline break repairs)
- ☐ Information pertaining to installation dates for all service lines (i.e. after 1986 when lead services lines were banned)
- ☐ Service line material of all service lines is known (i.e. all service lines are known to be PVC)



Signature of Responsible Person

Date

3-2-17

John A. Flaster Operator of Record

Printed Name and Title of Responsible Person

PWS NAME:

Breezeway Mobile Menu

PWS ID:

OH/503512

COUNTY:

Columbiana

For Ohio EPA use only:

Date Verification Rec'd: _____

Breezeway Mobile Manor
37457 State Route 558
Leetonia OH 44431
PWS OH1503512

To whom it may concern,

RE: Lead and Copper Service Lines

Since September 2005 maintenance records at Breezeway indicate leaks where the main line was exposed for repair at 7 locations. Service lines have been replaced at lot numbers 2,4,9,57,59,64 and 77 and in each case PVC main line with plastic fittings and plastic service lines were exposed and replaced with the same type of materials.

Maintenance records also indicate an absence of any copper water lines within individual mobile homes during repairs. Most commonly noted is the presence of grey plastic quest water lines with compression fittings and pex with brass fittings and crimp rings.

John A Flask Jr
WSA-1113509-16