

048500312

# Village of Creston

RECEIVED

MAR 06 2017

OHIO EPA NEDO

100 N. Main Street

P. O. Box 194

Creston, Ohio 44217

330-435-6021 Option 2 Fax 330-435-6149

---

March 1, 2017

## Village of Creston, OWDA Service Line Report


The Village of Creston has approximately 900 water service taps. Of these approximately 60% are supplied by new water mains, installed after 1990, that we are sure do not have lead service lines. In the installation of our new water lines, most of which were in the original or oldest section of the village, we have never come across a lead service line. We have come across two lead service lines while repairing water lines due to water breaks. One was replaced and the other is shown in yellow on the enclosed map of the distribution system. These lead service lines, again, were discovered due to excavation in water line repair due to water breaks.

The Village of Creston just completed a water line replacement, from 4 inch to 8 inch, in one of the older sections of the distribution system. No lead service lines we found as they were all copper. We will continue to replace any lead service lines should any be found during water line repair or replacement.

Village of Creston  
Water Department



POGGEMEYER  
DESIGN GROUP

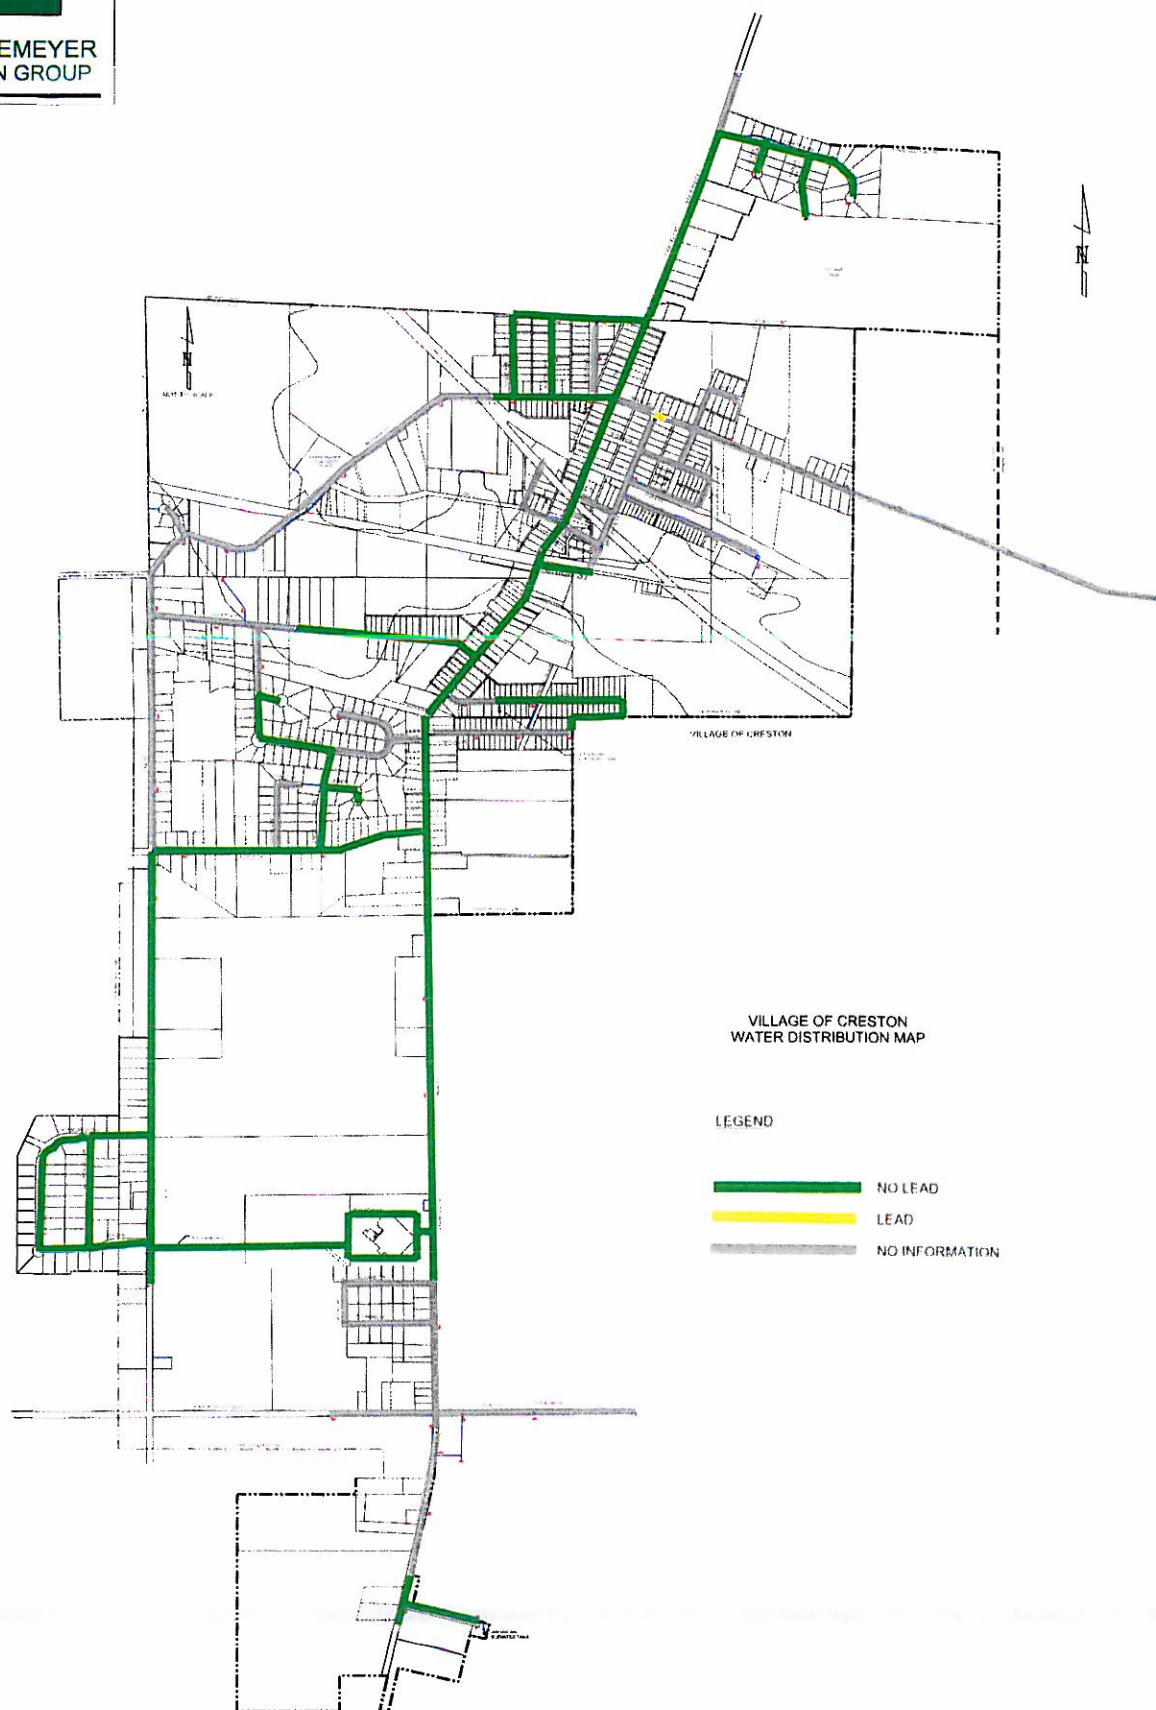

VILLAGE OF CRESTON  
WATER DISTRIBUTION MAP

LEGEND

- NO LEAD
- LEAD
- NO INFORMATION

BASEMAP PREPARED BY:  
ENVIRONMENTAL DESIGN GROUP

PRINTED BY:  
**POGGEMEYER DESIGN GROUP, INC.**  
ENGINEERS + ARCHITECTS + PLANNERS

MAR 06 2017


RECEIVED

OHIO PLANNING






POGGEMEYER  
DESIGN GROUP

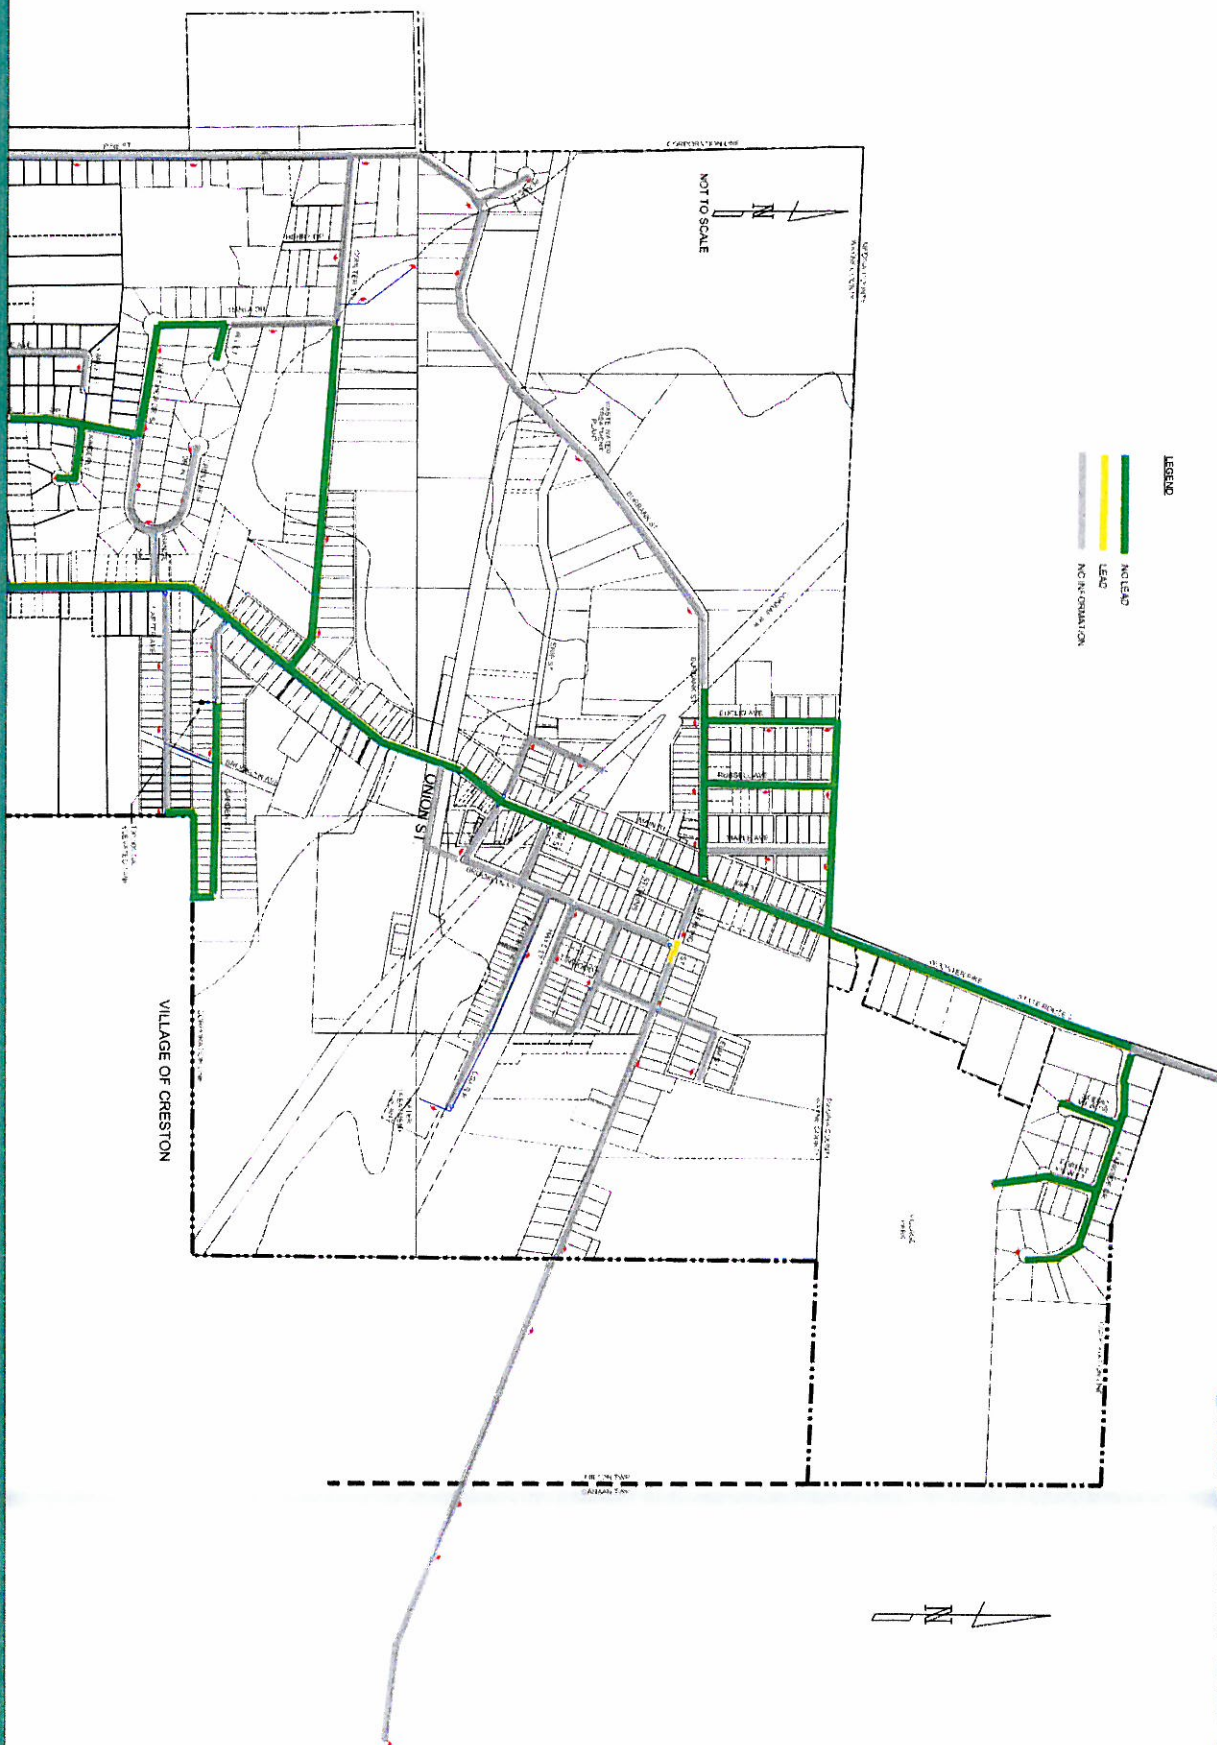

RECEIVED

MAR 06 2017

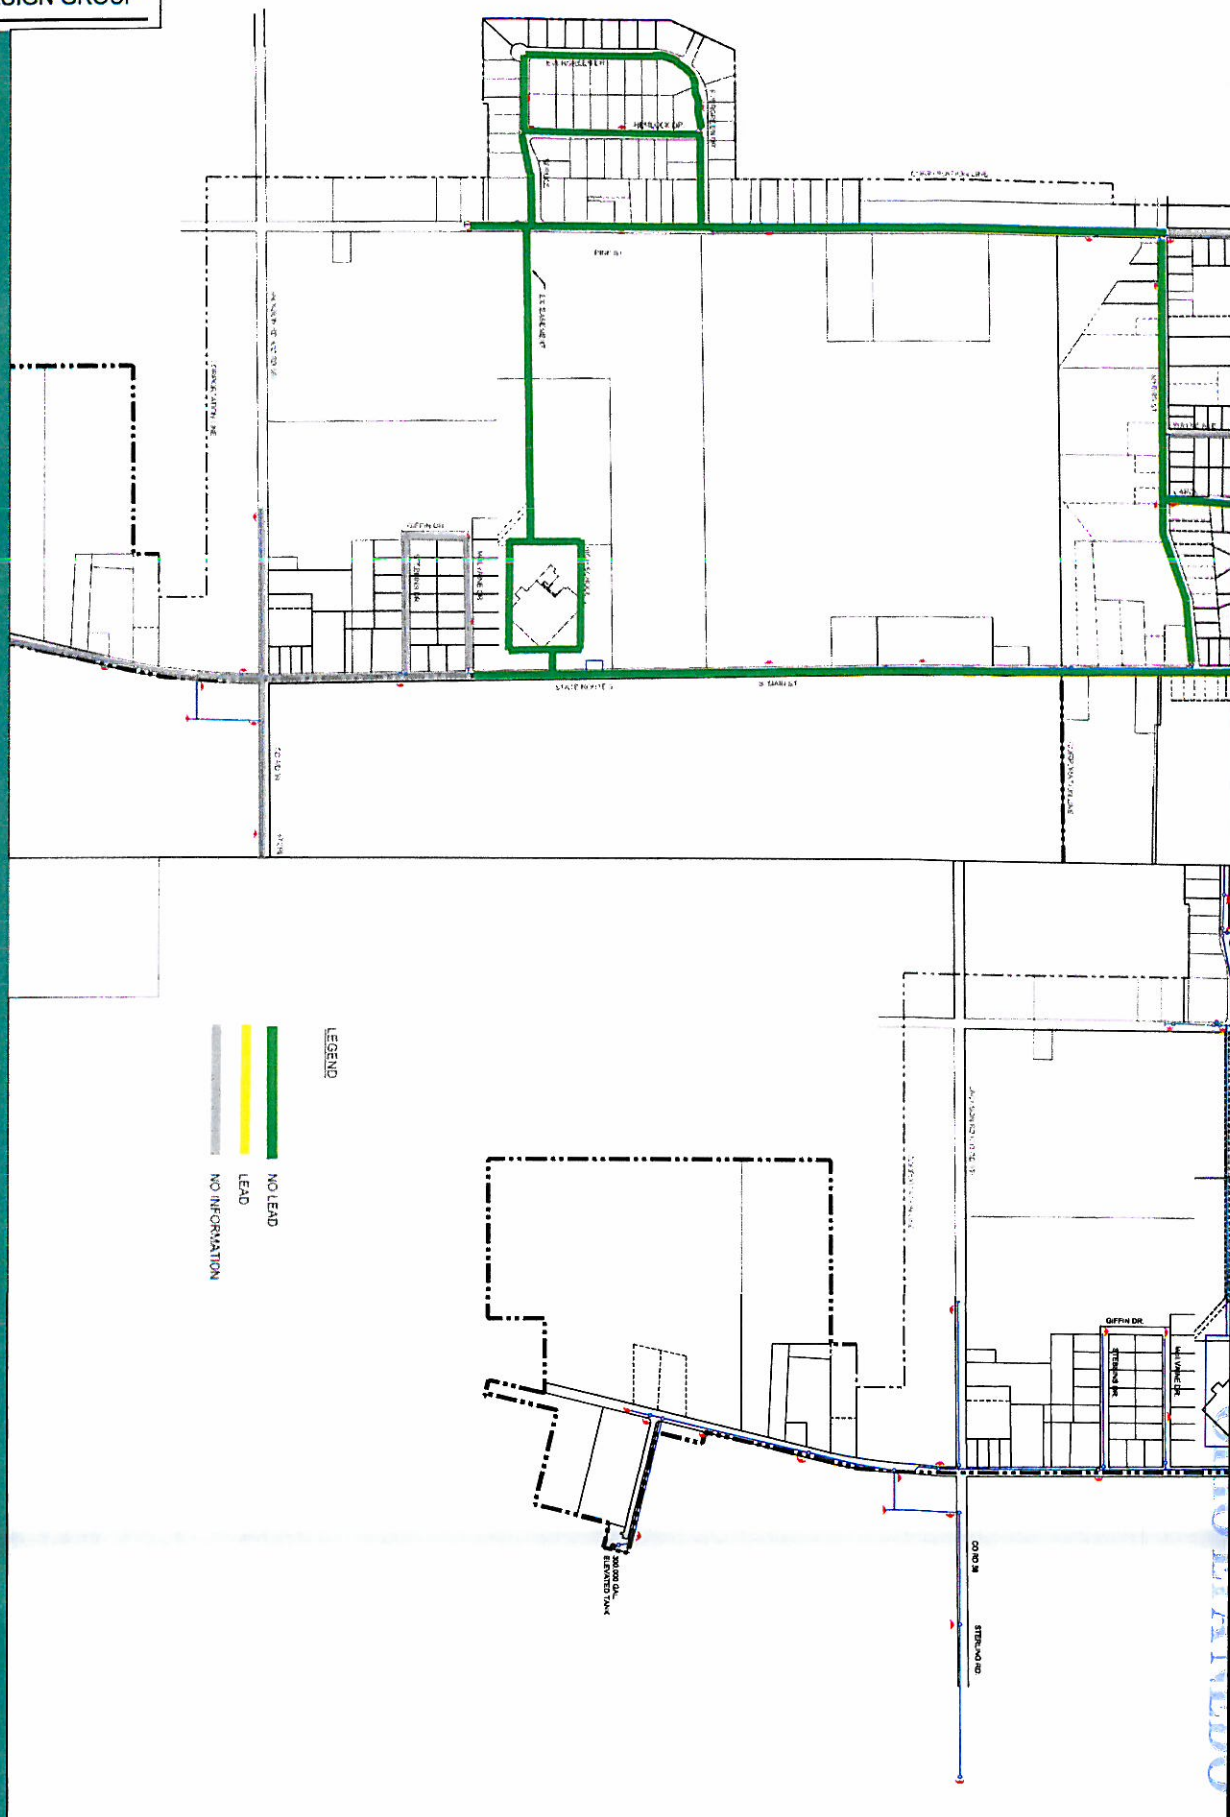

RECEIVED

MAR 06 2017