


Lead Mapping for HTM Drinking Water Piping and Fixtures Floor 1



- A - Main Plant
- B - Waste Water Treatment
- C - Gate 2 (Security)
- D - Potable Water Building
- E - Recycling Building
- F - Industrial Water Building
- G - Associate Entrance
- H - Tech Center
- I - Gate 1 (Security)
- S - Hot / Cold Systems 1st Floor (slides)
- S - Hot / Cold Systems 2nd Floor (slides)

- Non Lead
- Lead
- No Information

PW Entrance Point to the building

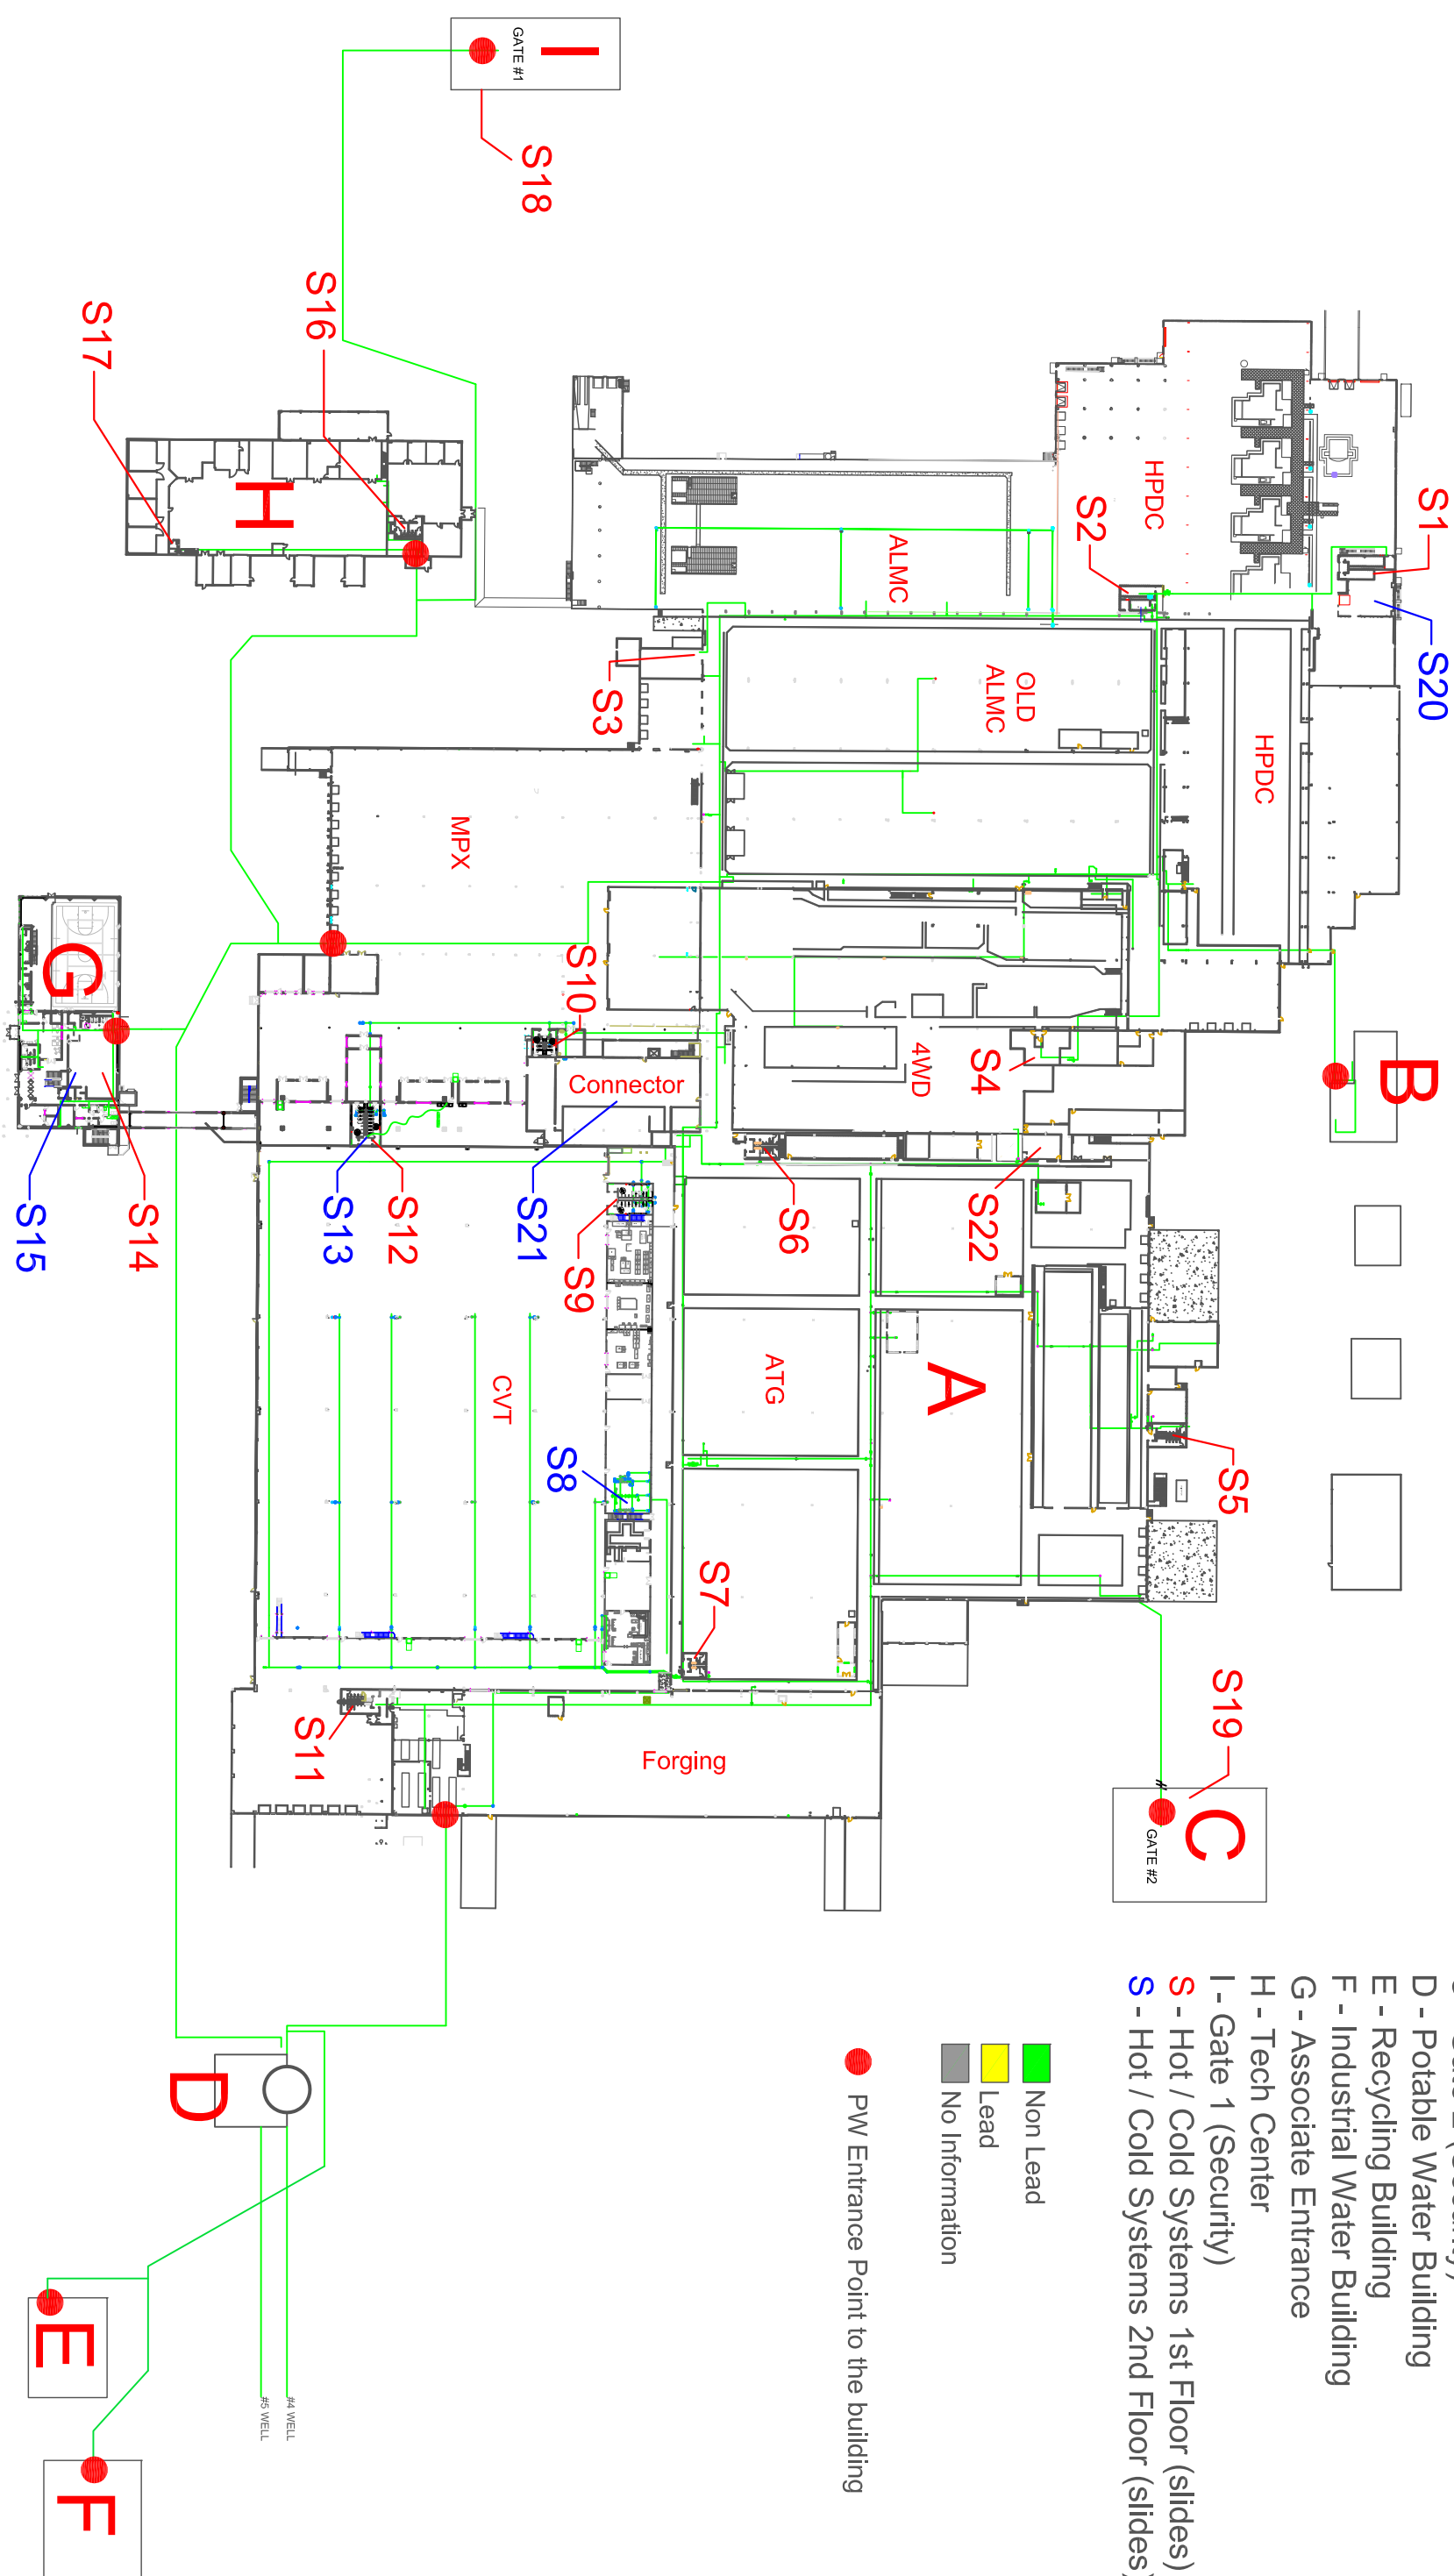

<p>REV. DATE MARK</p> <p> </p> <p> </p> <p> </p> <p> </p> <p> </p> <p> </p> <p> </p> <p> </p> <p> </p>	<p>HONDA</p> <p>Honda Transmission Mfg. of America, Inc. 6964 State Route 235 North Russells Point, Ohio 43348 Phone(937) 843-5555 Fax(937) 843-3259</p>	<p>PROJECT NAME: LEAD MAPPING FOR HTM DRINKING WATER PIPING FIRST FLOOR</p> <p>DEPARTMENT: Facilities</p> <p>APPROVAL BOX:</p>
<p>FILE NAME: Lead Mapping 1st Floor.dwg</p> <p>DEPARTMENT: Lead Mapping 1st Floor</p> <p>SCALE: N/S</p> <p>DATE: 02/27/17</p> <p>PAGE:</p>		