


# Mosquito Creek OH7806403

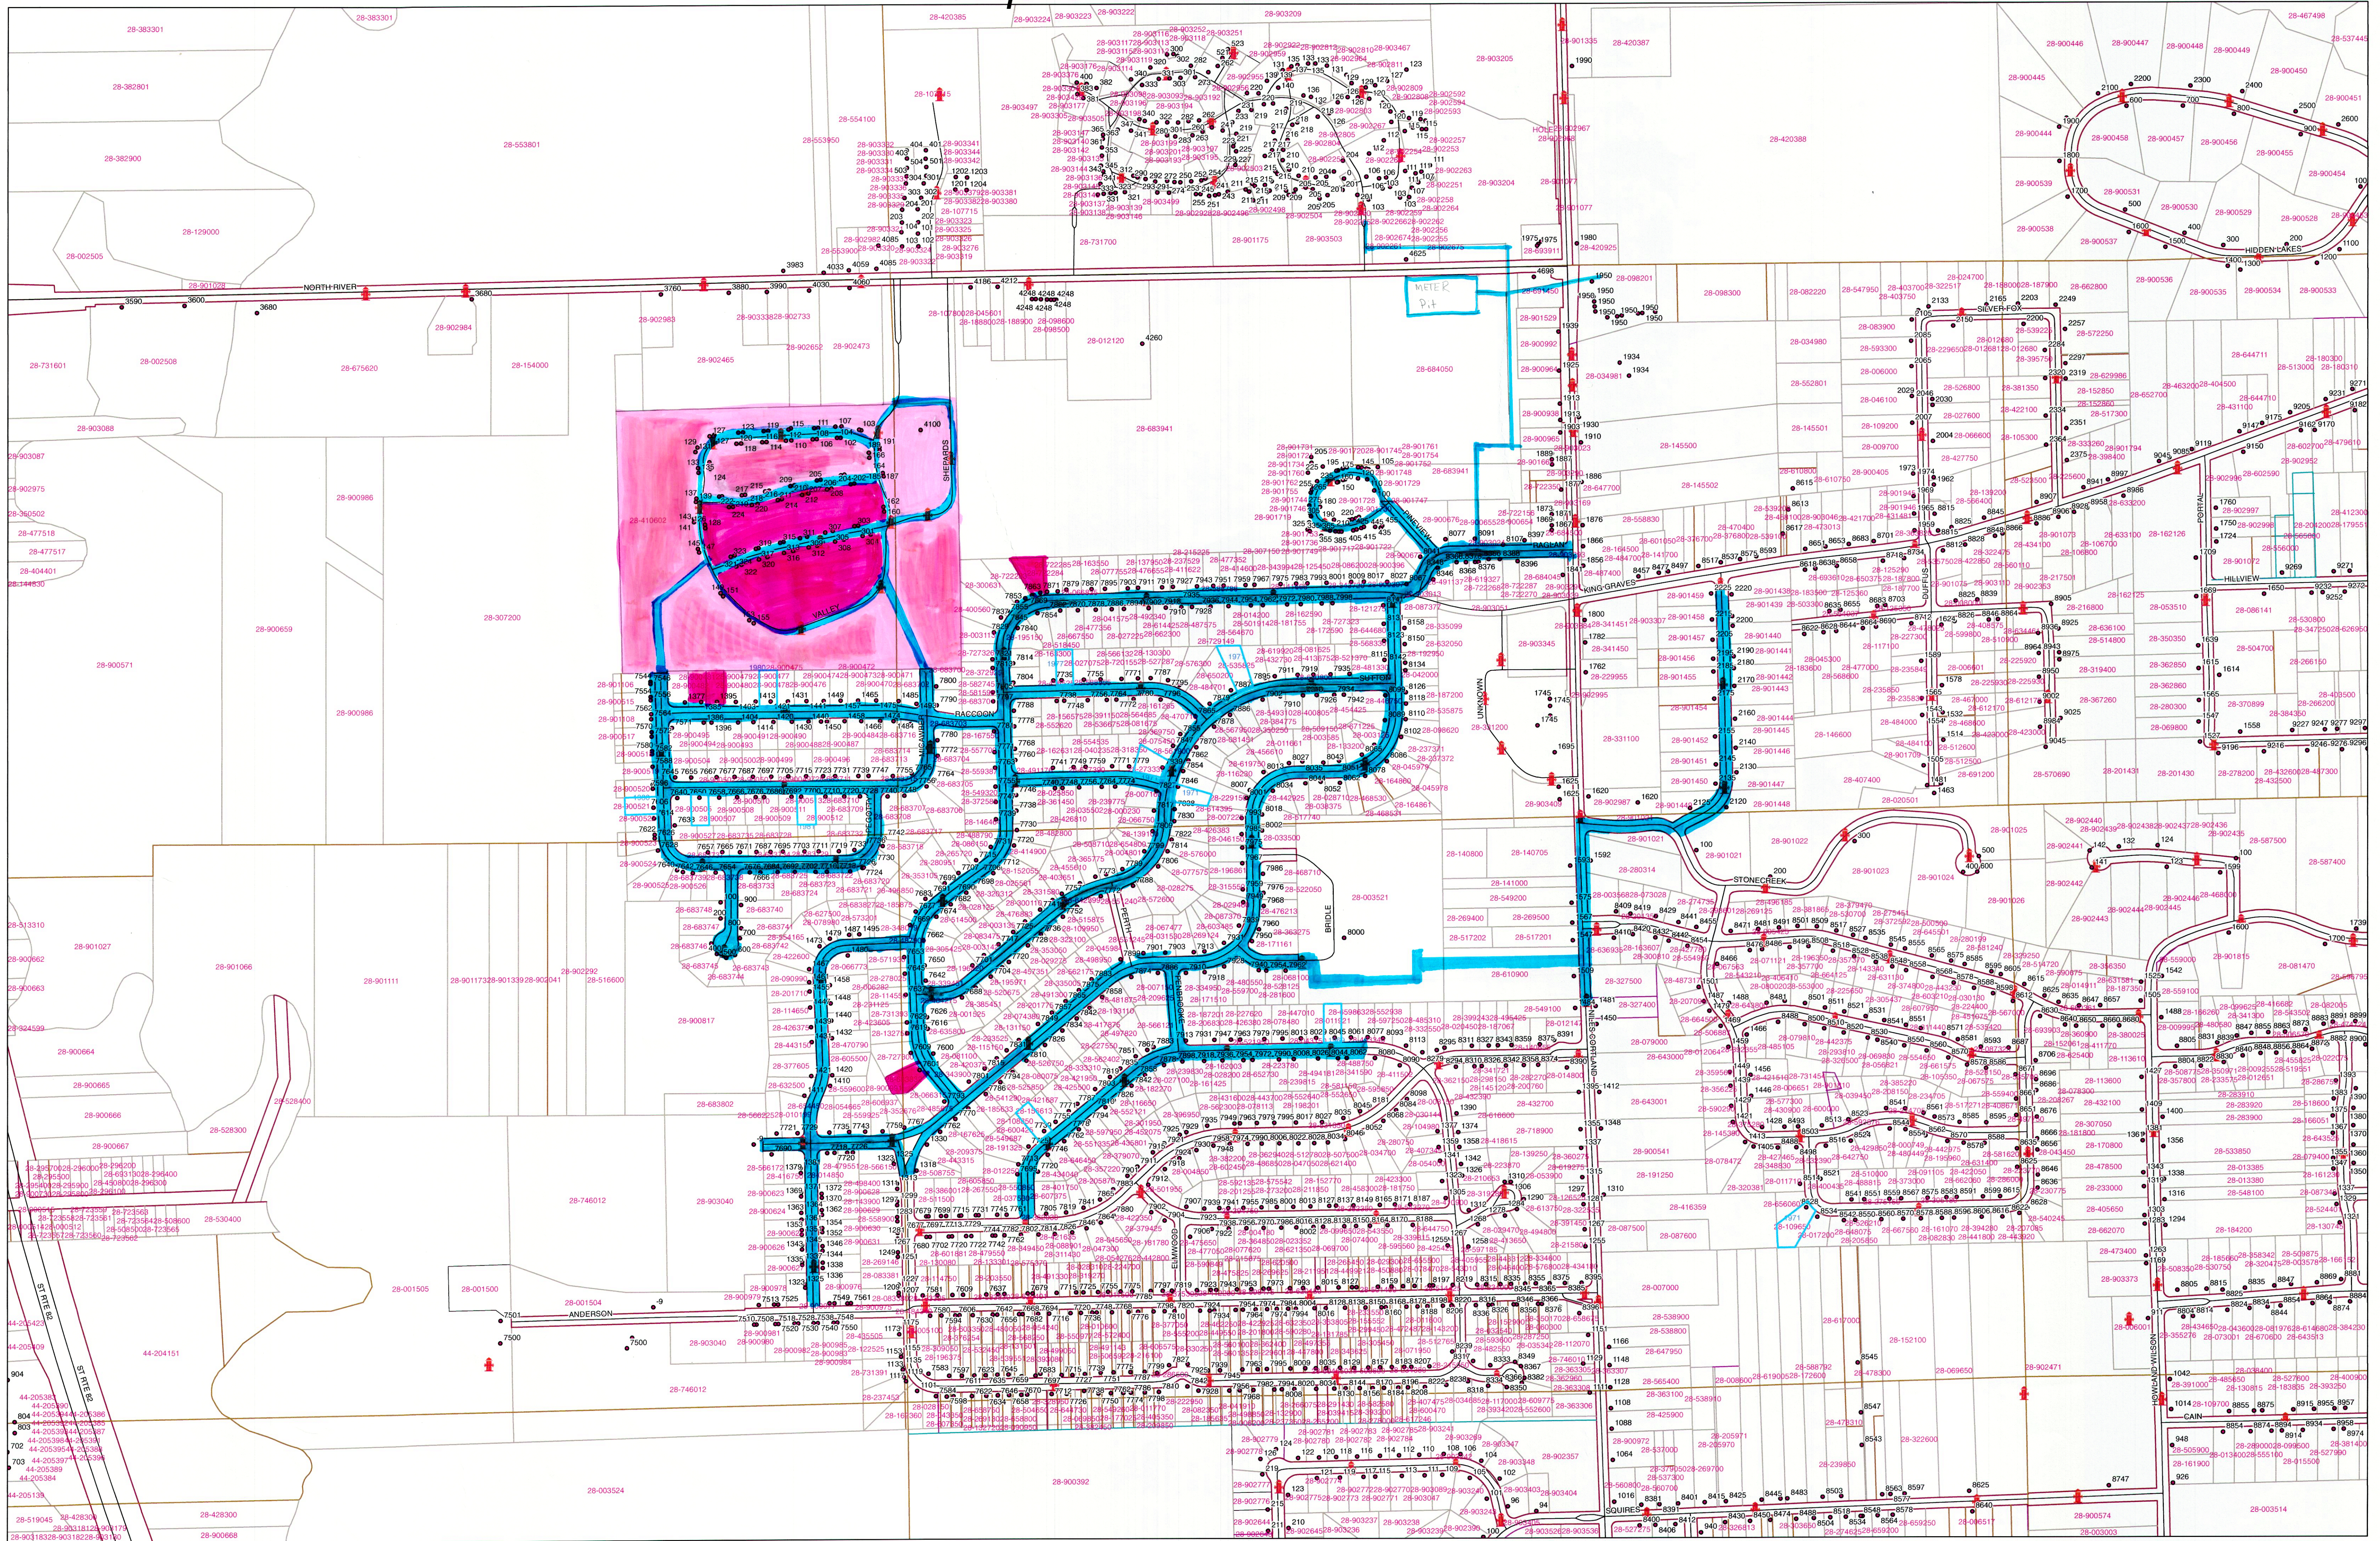

1998-2014  
= WATER LINES



480 240 0 480 Feet





Mosquito Creek PWS OH7806403

According to field personnel, no known lead service lines are in this system.

Age of homes were determined by the Trumbull County Auditors Web Site.

Mosquito Creek Water District consists of 665 service connections as of February 2017.

Customers in this district, not colored with pink highlighter, are pre 1998

Water lines for this district have been marked with blue highlighter.

Sample sites are outlined in blue ink.