


FARMER Boy Restaurant
 1324 Canton Rd
 Akron, Ohio 44312
 330 784-4052
 PWS ID#: 7740412

West

Lead/Copper sampling sites

	AGE
LCR 201: Kitchen Hand sink	> 1988
LCR 202: Kitchen 2 comp. sink	< 1988
LCR 203: Kitchen 3 comp. sink	< 1988
LCR 204: ladies rr sink (R)	> 1988
LCR 205: Mens rr sink (R)	> 1988
LCR 206: South H ₂ O dispenser	?
LCR 207: North H ₂ O dispenser	?

X - sink
 — Hot H₂O line
 — Cold H₂O line
 S = softener
 B = brine tank
 Pt = pressure tank

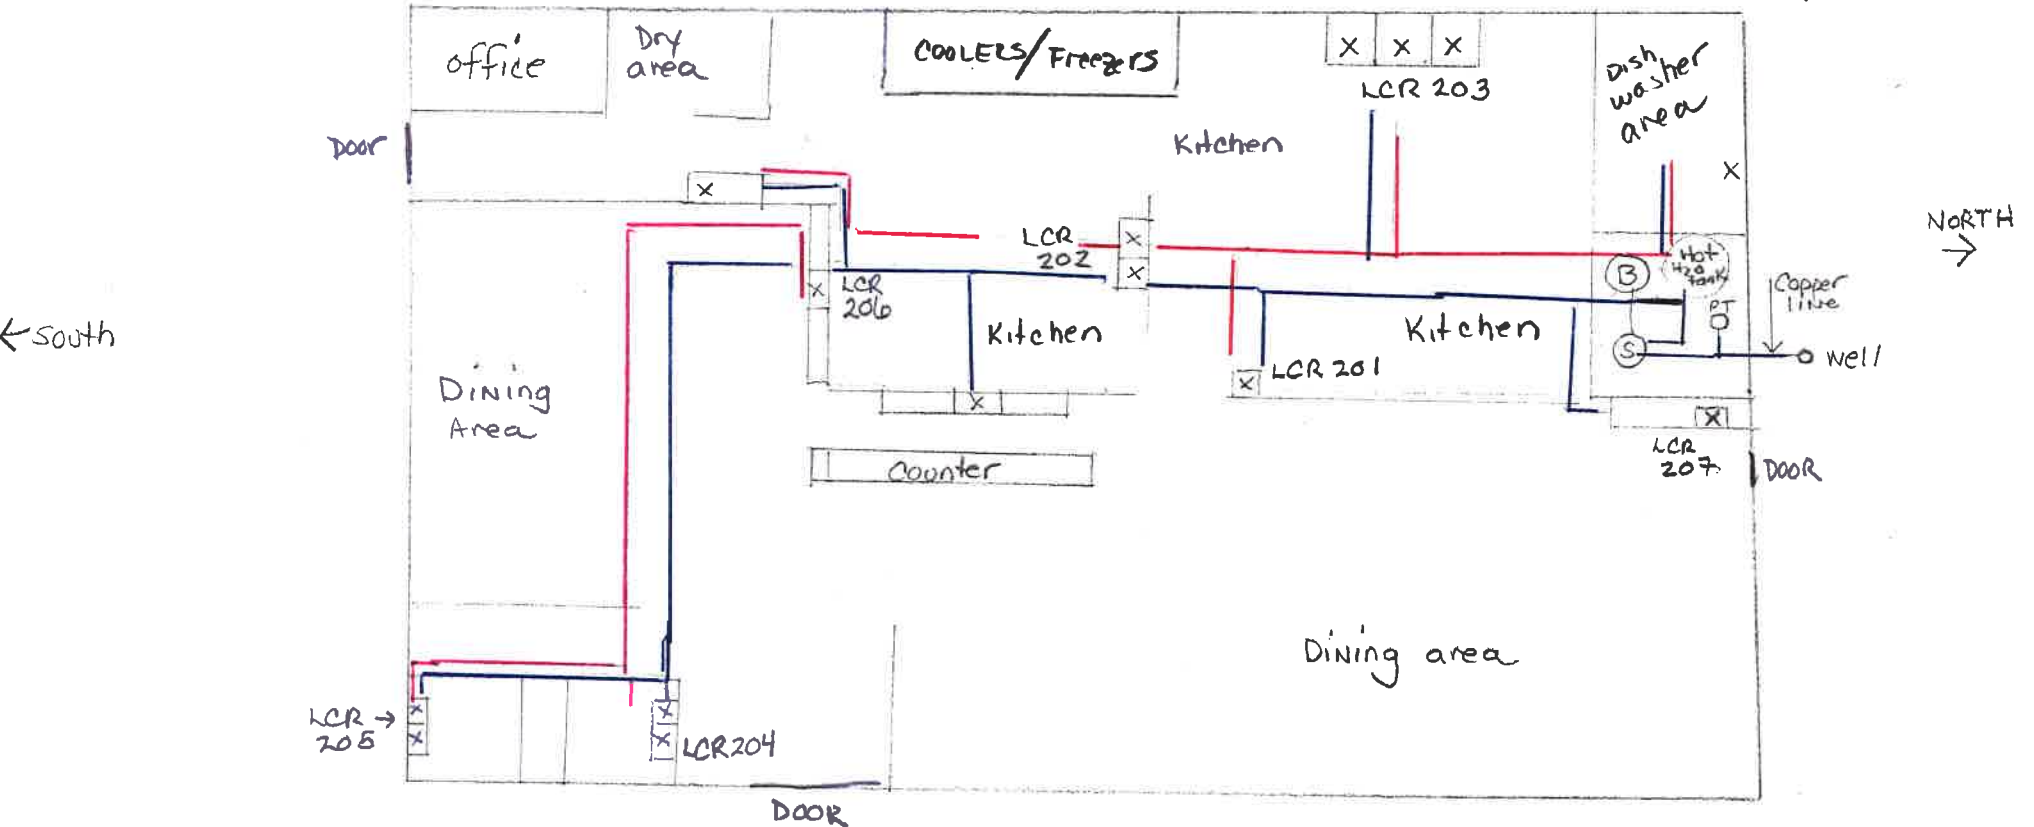

* ALL WATER LINES ARE COPPER + MAIN SERVICE LINES replaced in 2005. (ALL COPPER) Bldg. built < 1982.

east

Route 91