

Village of Matamoras Public Water System: 8400512

3/1/2017

SEDA  
2017 MAR -8 AM 10:23

The Village of Matamoras primarily consists of homes and buildings that were built prior to 1998, with the majority being built prior to the 1950's. Only a handful of homes and buildings have been constructed since 1998 and none have been constructed since 2014. Therefore, it is assumed that all buildings have characteristics of having solder or fixtures that may contain lead.

A water system improvement project began in September of 2016 and is scheduled for completion in the summer of 2017. The project includes some main line replacements as well as adding meters to all service connections. (The Village had been non-metered until this point.) It was unknown if the Village contained any lead service lines prior to this project. However, many lead service lines were in fact located during construction. The vast majority of these were removed or replaced during the project. However, 6 lead service lines still remain. The Village has approved the funds to replace the remaining 6 lines within the next few months. These lead service lines are between the city main and the meter pit. We did not locate any lead service lines on the customer side of the meter. Therefore, once the Village replaces the remaining 6 service lines, we will not have any lead service lines within our water system.

Since the lead service line status was unknown prior to this project, our previous lead and copper tests did not reflect any of the sites that contained the lead lines. An updated sample monitoring point ID is included with this report and contains the 6 lead service line sites. Once these have been eliminated, I will forward an updated one.

If you have any questions or concerns please contact me at your convenience.

Thank you,



Gregory S. Danver, Water / Wastewater Superintendent, Village of Matamoras

Office: 740-865-3862, Cell: 740-516-3400

Email: [matamoraswwtp@sbcglobal.net](mailto:matamoraswwtp@sbcglobal.net)

Village of New Matamoras  
Water Service Improvements  
Index Map


Sheet A  
1"=250'

Sheet A contains 5 locations with lead service lines between the City main and the meter pit. The addresses are: 204, 206, 306, 310, and 400 Second Streets. These are indicated in **YELLOW** on the map.



2017 MAR -8 AM 10:23

MATCH-LINE  
SEE SHEET B

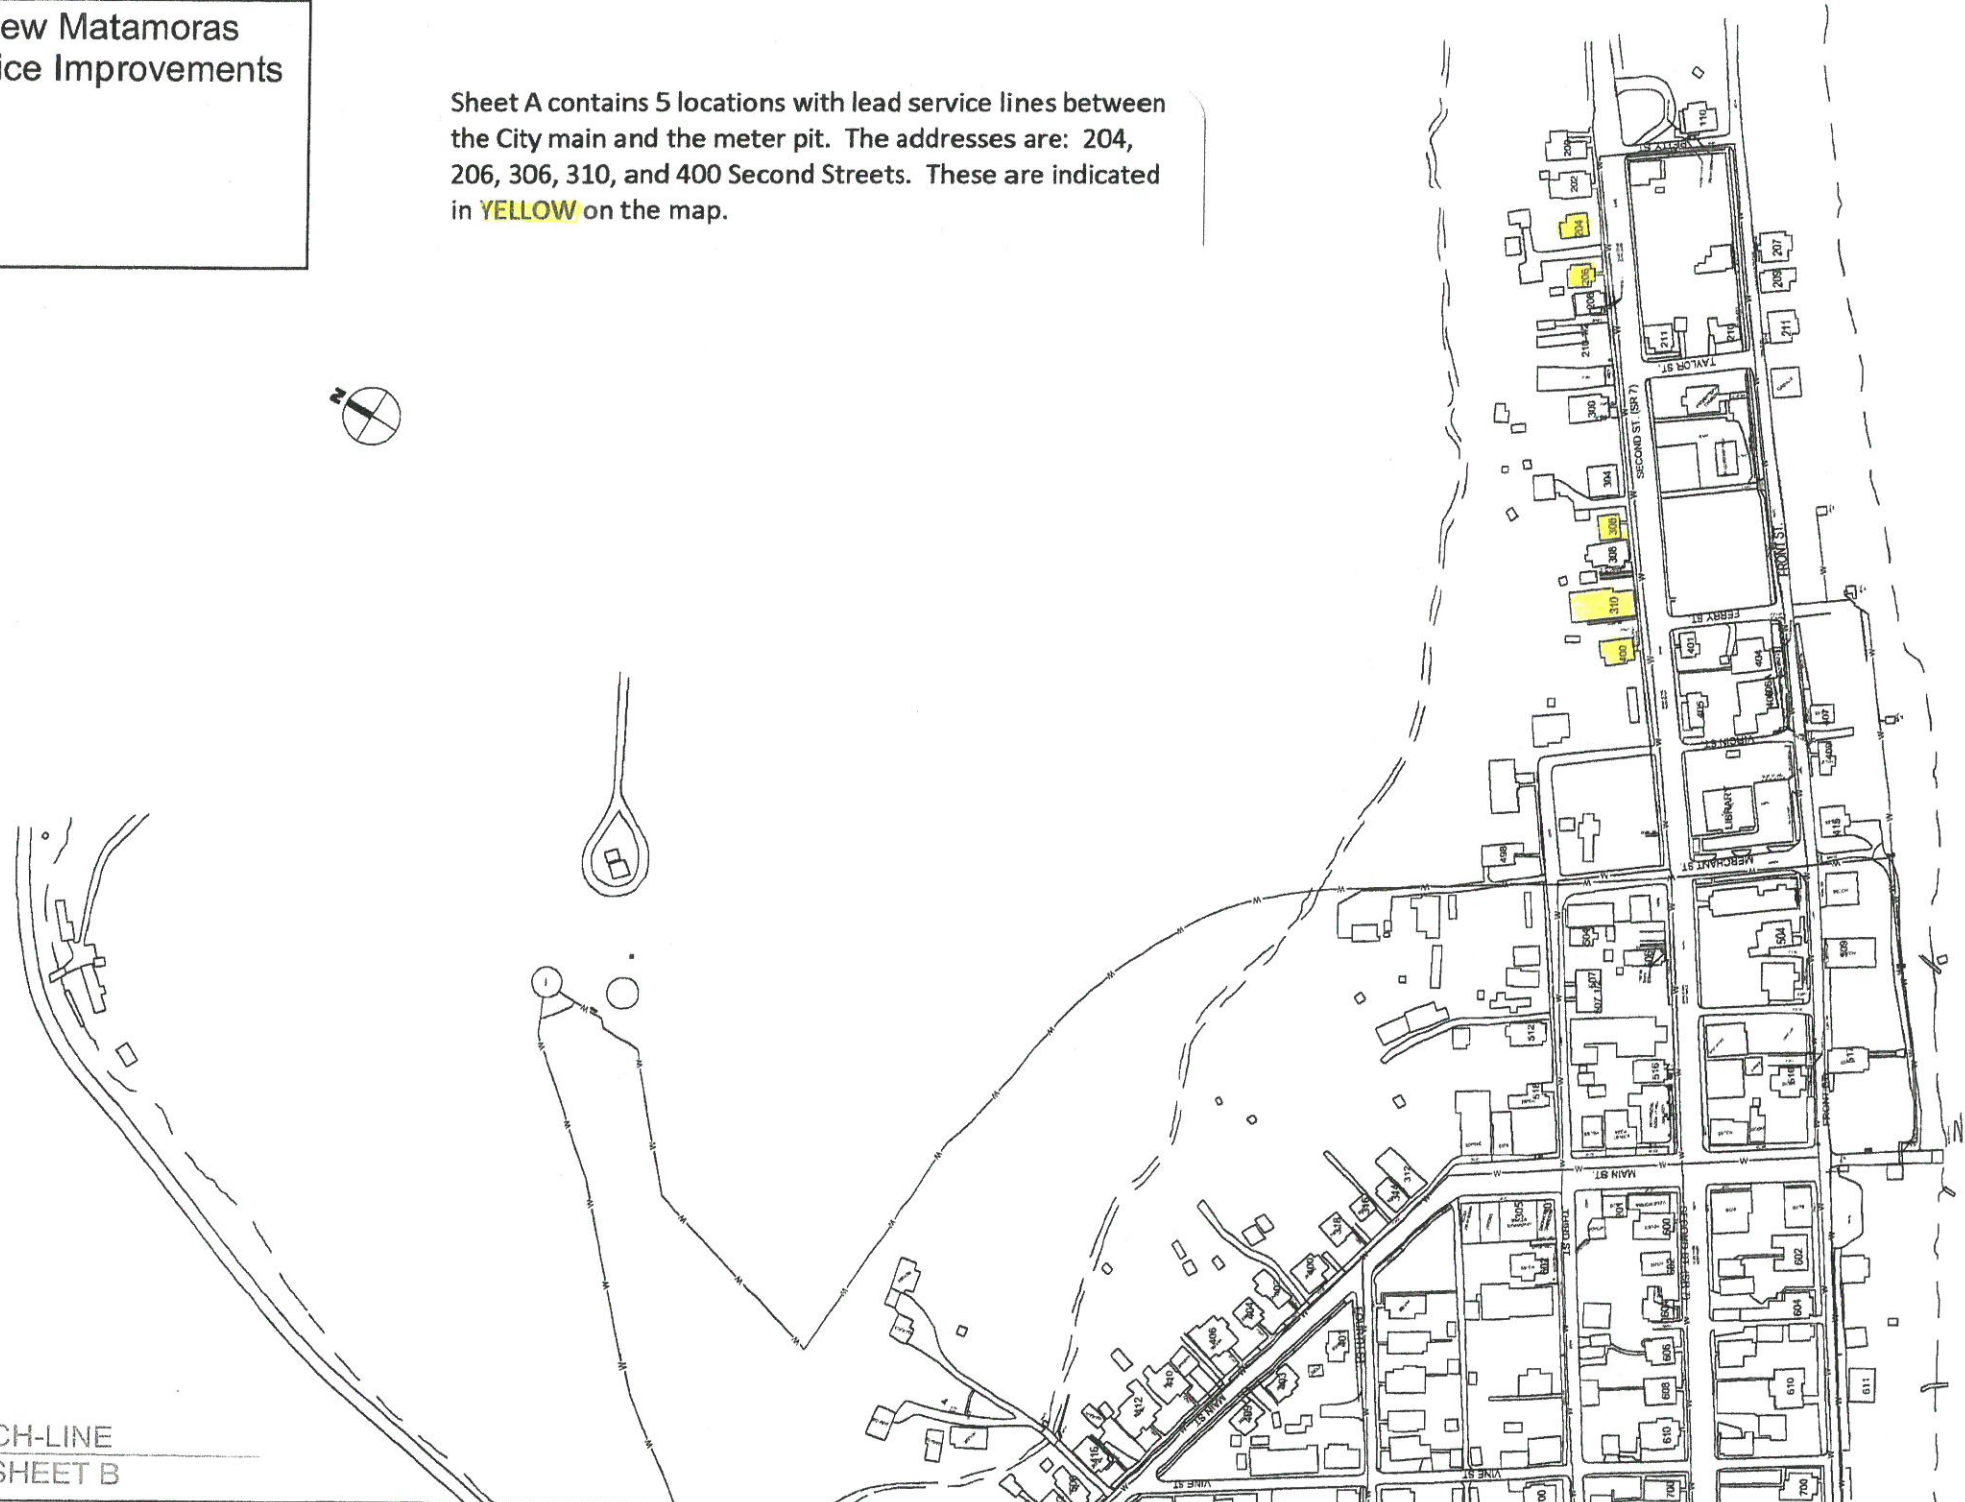



MATCH-LINE  
SEE SHEET A




2017 MAR -8 AM 10:23

Sheet B contains 1 location with a lead service line between the City main and the meter pit. The address is 706 Second street and is indicated in **YELLOW** on the map.

Village of New Matamoras  
Water Service Improvements  
Index Map

Sheet B  
1"=250'

MATCH-LINE  
SEE SHEET C

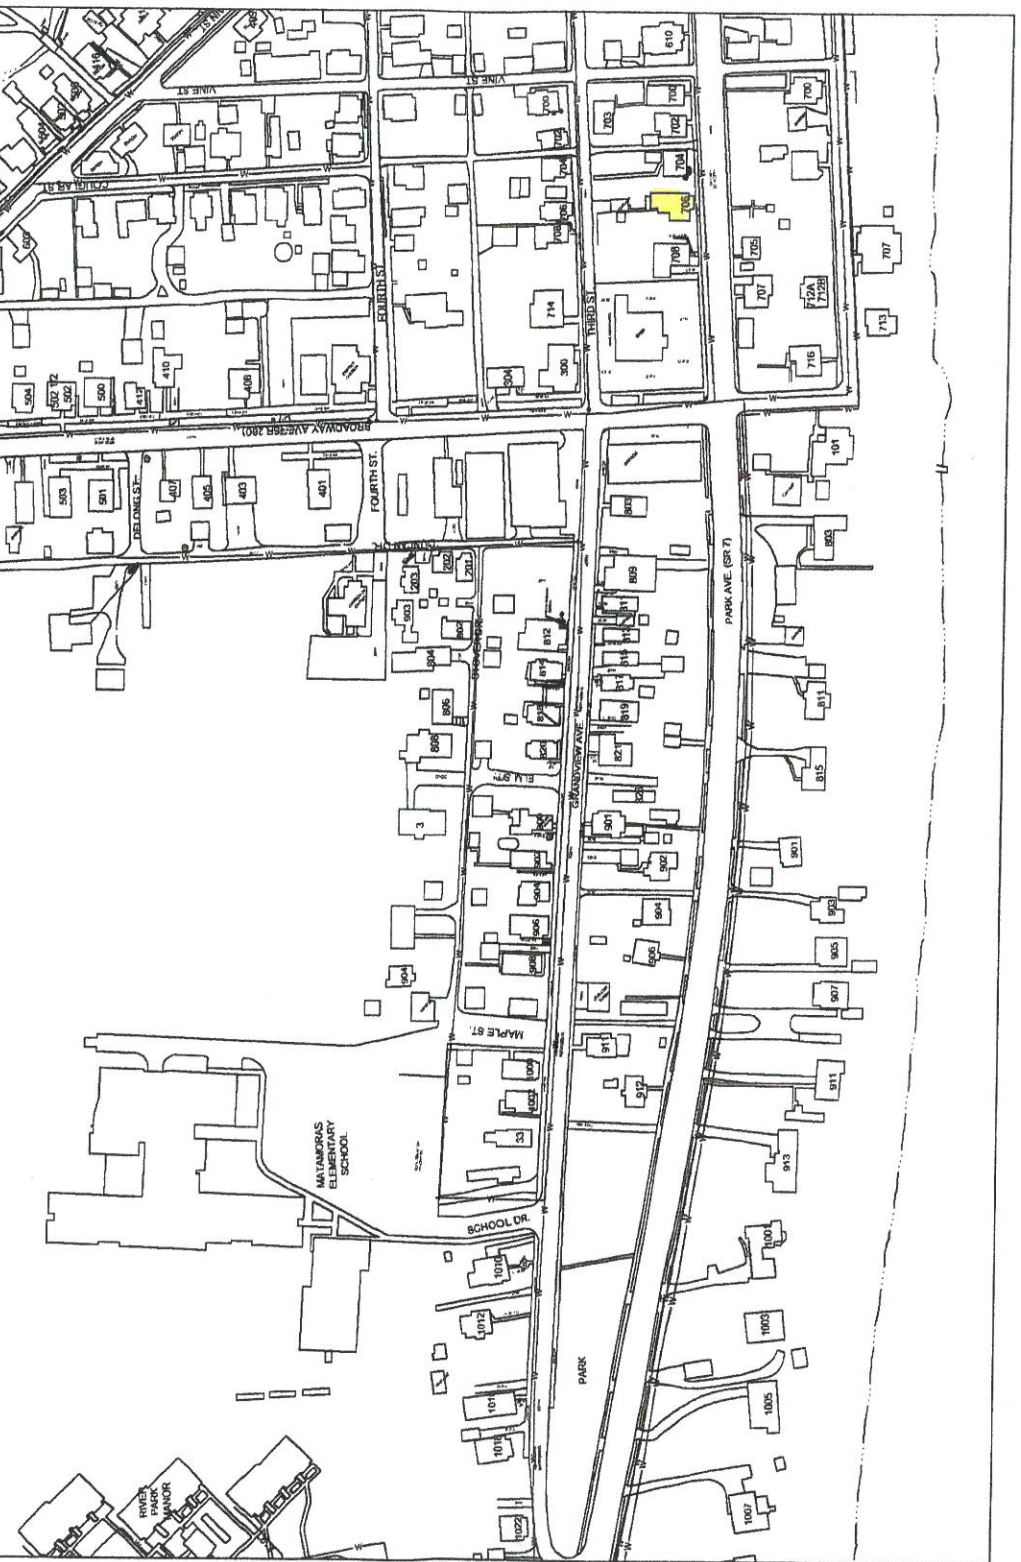

MATCH-LINE  
SEE SHEET B


2017 MAR -8 AM 10:23

Village of New Matamoras  
Water Service Improvements  
Index Map

Sheet C  
1"=250'

Sheet C does not contain any locations  
with lead service lines.

MATCH-LINE  
SEE SHEET D

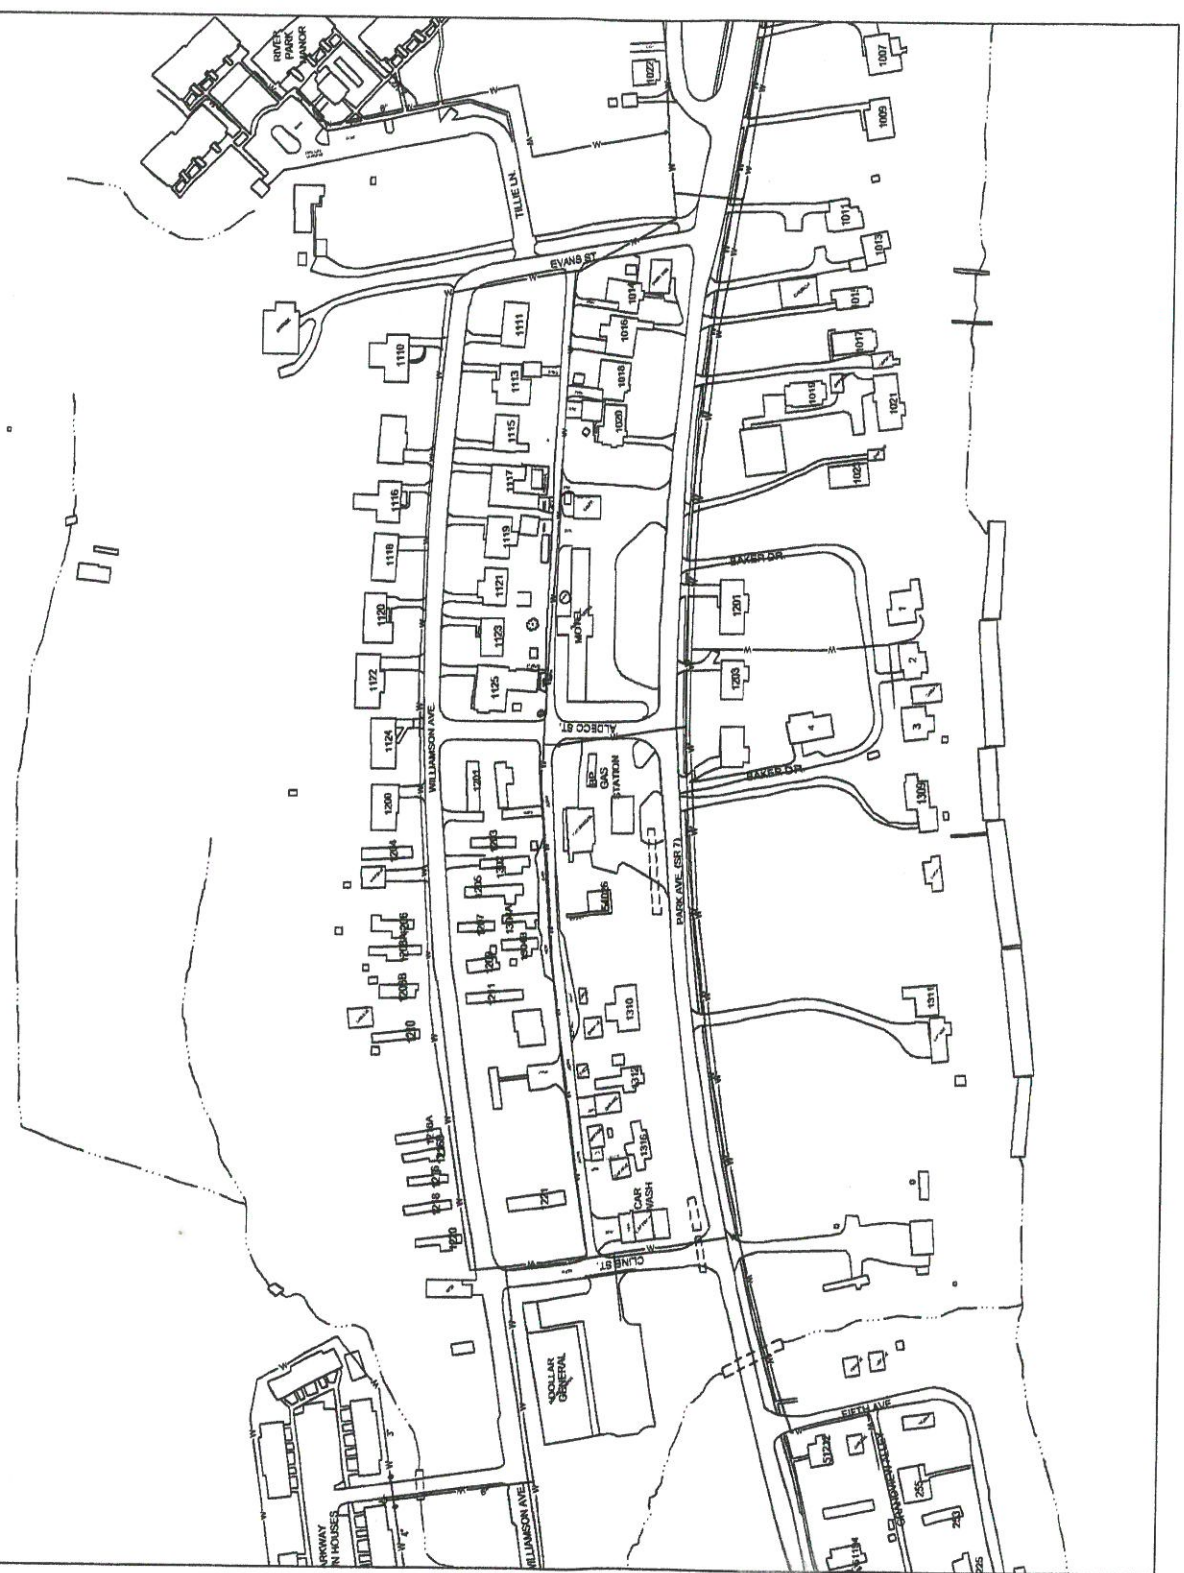



MATCH-LINE  
SEE SHEET C

2017 MAR -8 AM 10:23

Sheet D does not contain any locations  
with lead service lines.

Village of New Matamoras  
Water Service Improvements  
Index Map

Sheet D  
1"=250'

MATCH-LINE  
SEE SHEET E



MATCH-LINE  
SEE SHEET D

2017 MAR -8 AM 10:23



Sheet E does not contain any locations  
with lead service lines.

Village of New Matamoras  
Water Service Improvements  
Index Map

Sheet E  
1"=250'

153

NEWLEN RD.

HOLDREN LN.

HOLDREN LN.

STATE RT. 7

MORNINGSIDES DR.

50009

50076

50077

