

Arrowhead Primary School

1600 Raleigh Boulevard, Copley, Ohio 44321 • 330-664-4885 • FAX 330-664-4927

RECEIVED

MAR 07 2017

OHIO EPA NEDO

FEB. 28, 2017

Copley-Fairlawn City Schools
"Learning Today, Leading Tomorrow"


Entity: Arrowhead Elementary
Doc Type: REPORT
Doc Subtype:
Program: DPANW
County: SUMMIT
Secondary ID: JA 7773212

Raleigh Blvd

NORTH

WEST

EAST

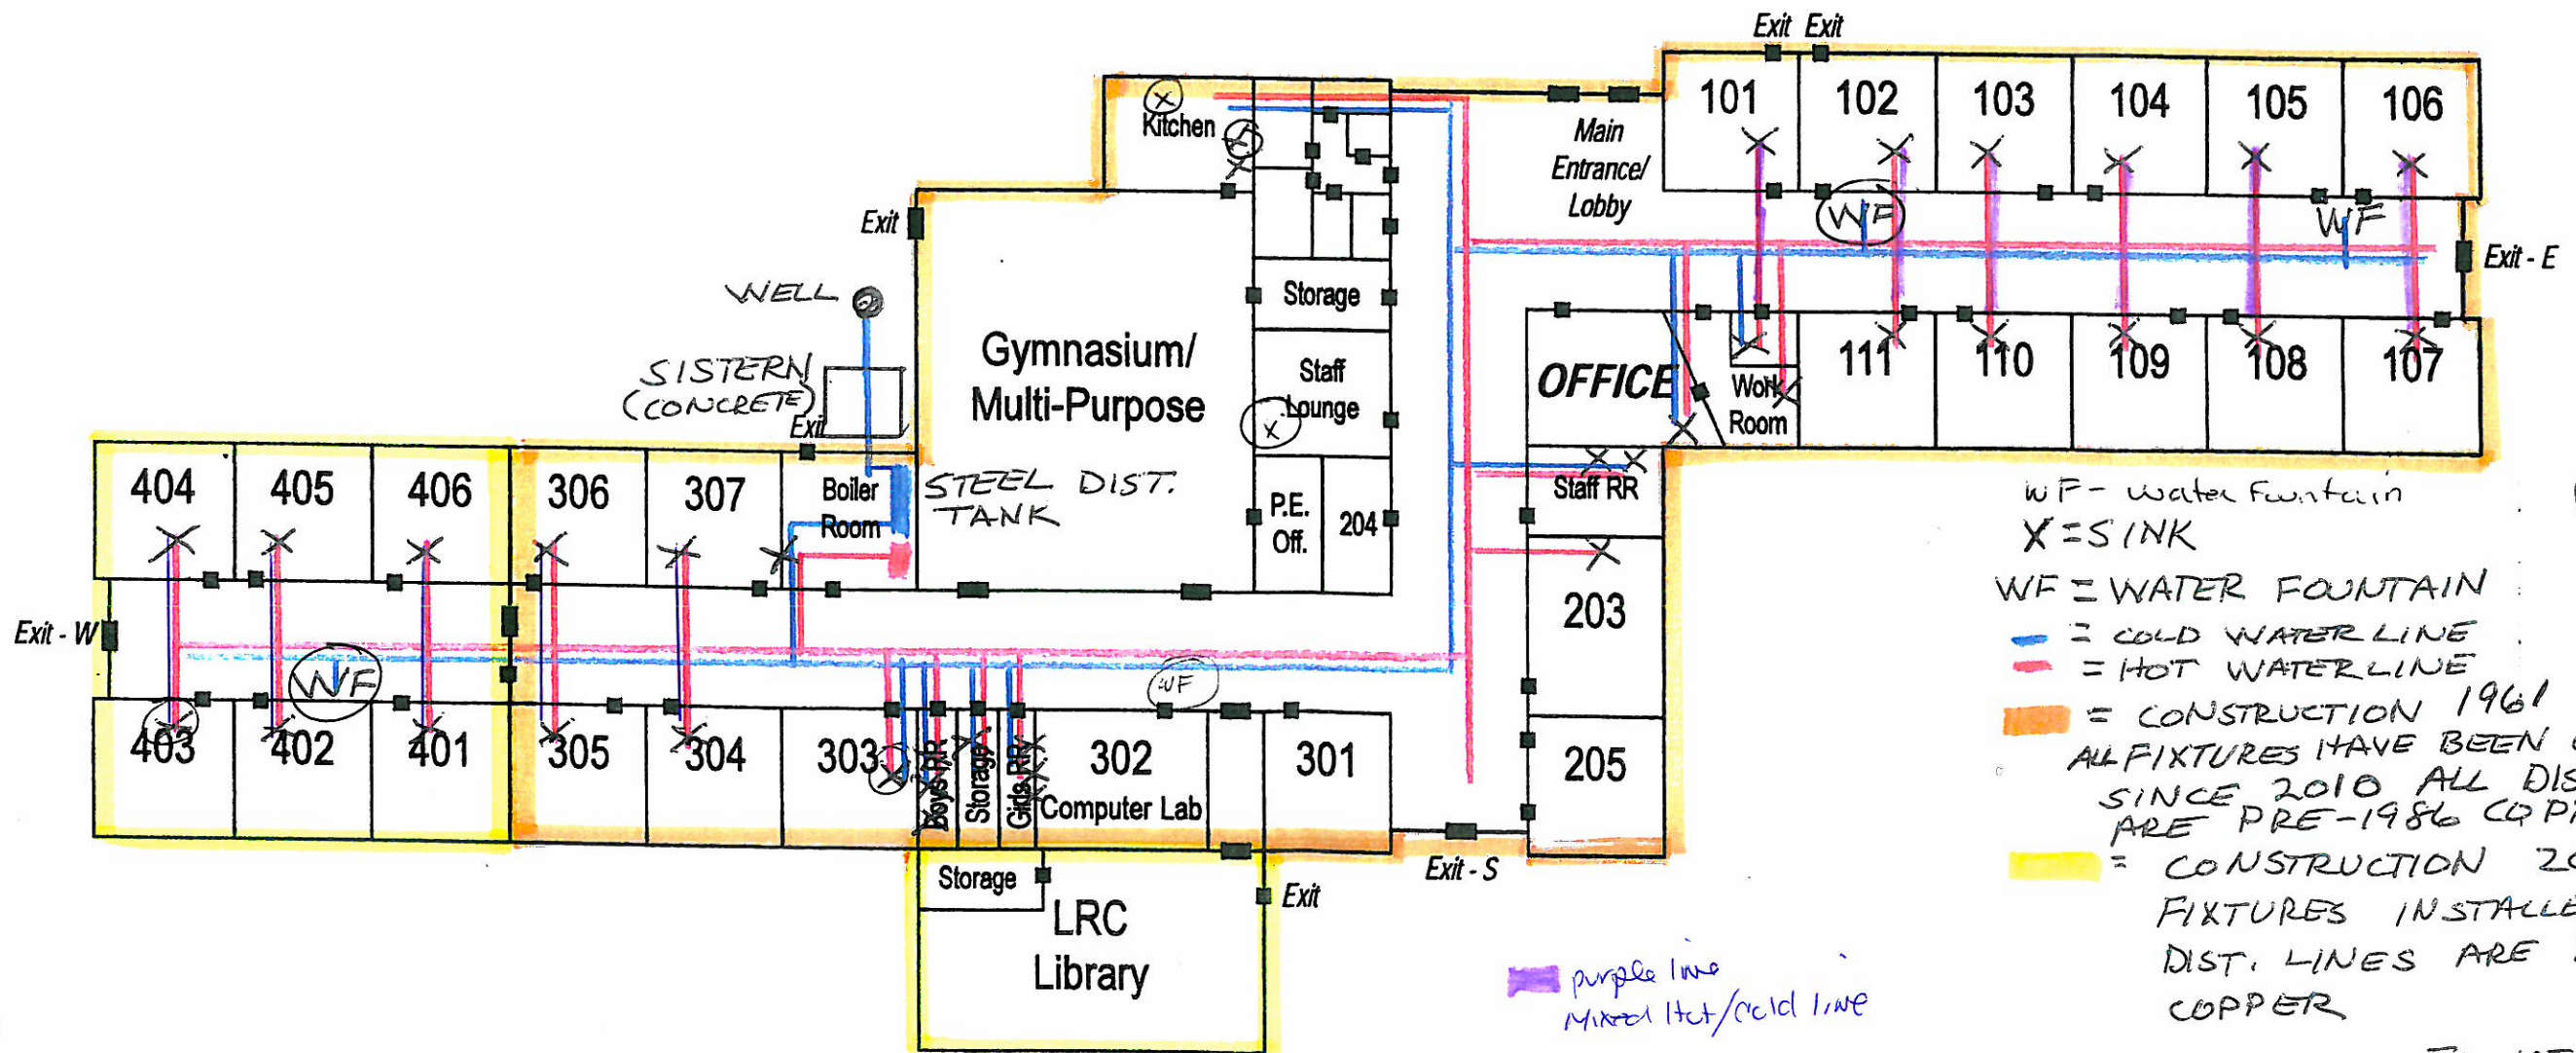

- WF - water fountain
- X = SINK
- WF = WATER FOUNTAIN
- = COLD WATER LINE
- = HOT WATER LINE
- = CONSTRUCTION 1961
- = CONSTRUCTION 2000
- ALL FIXTURES HAVE BEEN CHANGED SINCE 2010 ALL DIST. LINES ARE PRE-1986 COPPER
- = WATER FOUNTAINS ALL POST-1986
- (WF) - Pb+Cu sampling site
- (X) - Pb+Cu sampling site

1" = ~70'

purple line
Mixed Hot/cold line

South