


Because it is practically impossible to determine the lead content of an installed fixture, fitting or pipe, it should be assumed that the manufacture or installation date is the primary indicator of the lead content. Therefore, the characteristics of buildings and piping solder or fixtures would be buildings built prior to 1998 or that use plumbing material or solder manufactured before 1998 may have materials with greater than 8% lead and are at a higher risk of contributing lead to the drinking water than materials manufactured after 1998. In addition, buildings built and plumbing materials manufactured after 2014 were required to have less than 0.25% lead by weight and have the lowest risk for contributing lead to the drinking water. It should be noted however that, although prohibited, some use of leaded solder or leaded components may have occurred after the prohibitions became effective.

RECEIVED  
 MAR 08 2017  
 OHIO EPA NEDO

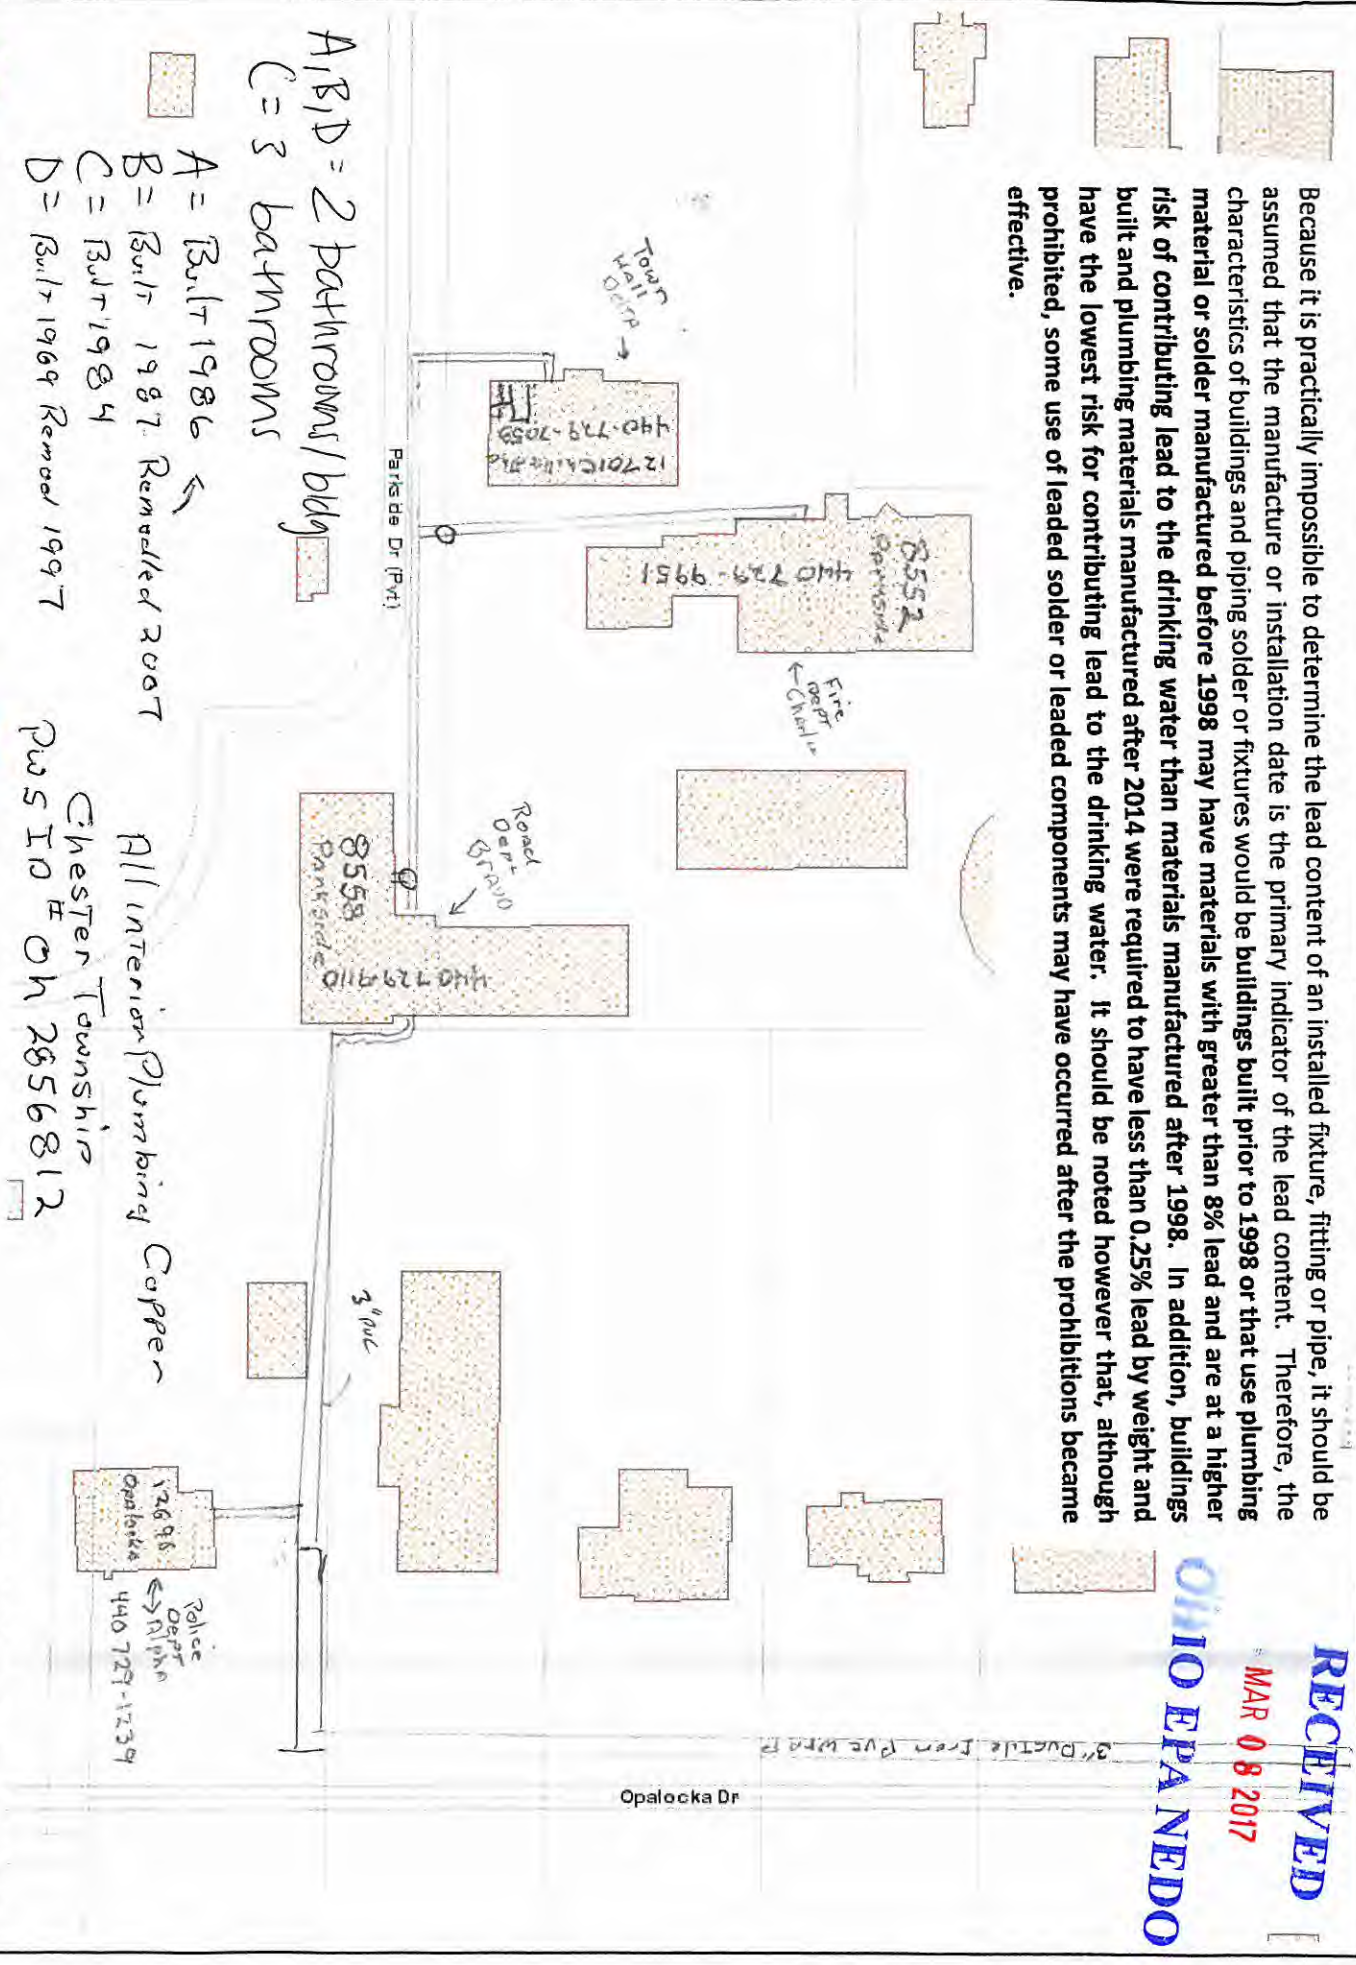

A, B, D = 2 Bathrooms / bldg  
 C = 3 Bathrooms

- A = Built 1986
- B = Built 1987 Remodeled 2007
- C = Built 1984
- D = Built 1969 Remodel 1997

All Interior Plumbing Copper  
 Chester Township  
 PW SIO PH 2856812



Frank J. Gilha, Geauga County Auditor  
 Joe Cattell, Geauga County Engineer PE, PS

1 Inch = 83.33 Feet | Scale: 1,000  
 This map was prepared by Geauga County GIS in accordance with Section 5713.09 of the O.R.C.  
 These and other digital data do not replace or modify any and survey, deeds, and/or other legal instruments  
 defining land ownership or use. Geauga County assumes no legal responsibility for the information.  
 February 10, 2017