



RECEIVED  
MAR 07 2017

BY: .....

Plant

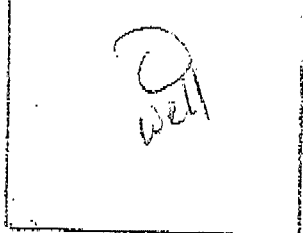

- SMP001 - Furnace Rm
- SMP002 - mens RR
- SMP003 - Womens RR
- SMP004 - Conference room restroom
- SMP005 - Addition RR

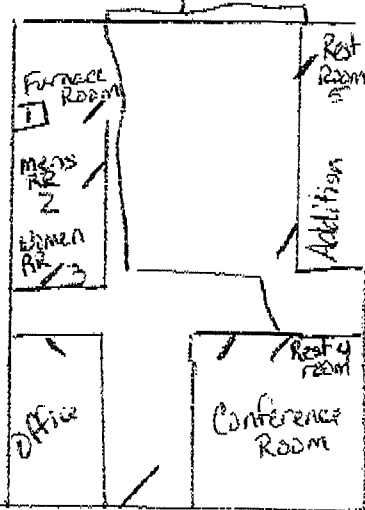

Greif Packaging, LLC  
 787 Warrington Rd. SW  
 PO Box 675  
 Massillon OH 44648  
 PWS# OH7635012

Main plant built 1966  
 Addition built 1990  
 All lines are copper  
 Line comes in thru basement,  
 to pressure tank & up to furnace  
 room and addition

Warrington Rd SW

Entity: Greif Packaging  
 Doc Type: REPORT  
 Doc Subtype: \_\_\_\_\_  
 Program: DPAGN  
 County: STARV  
 Secondary ID: OH7635012