
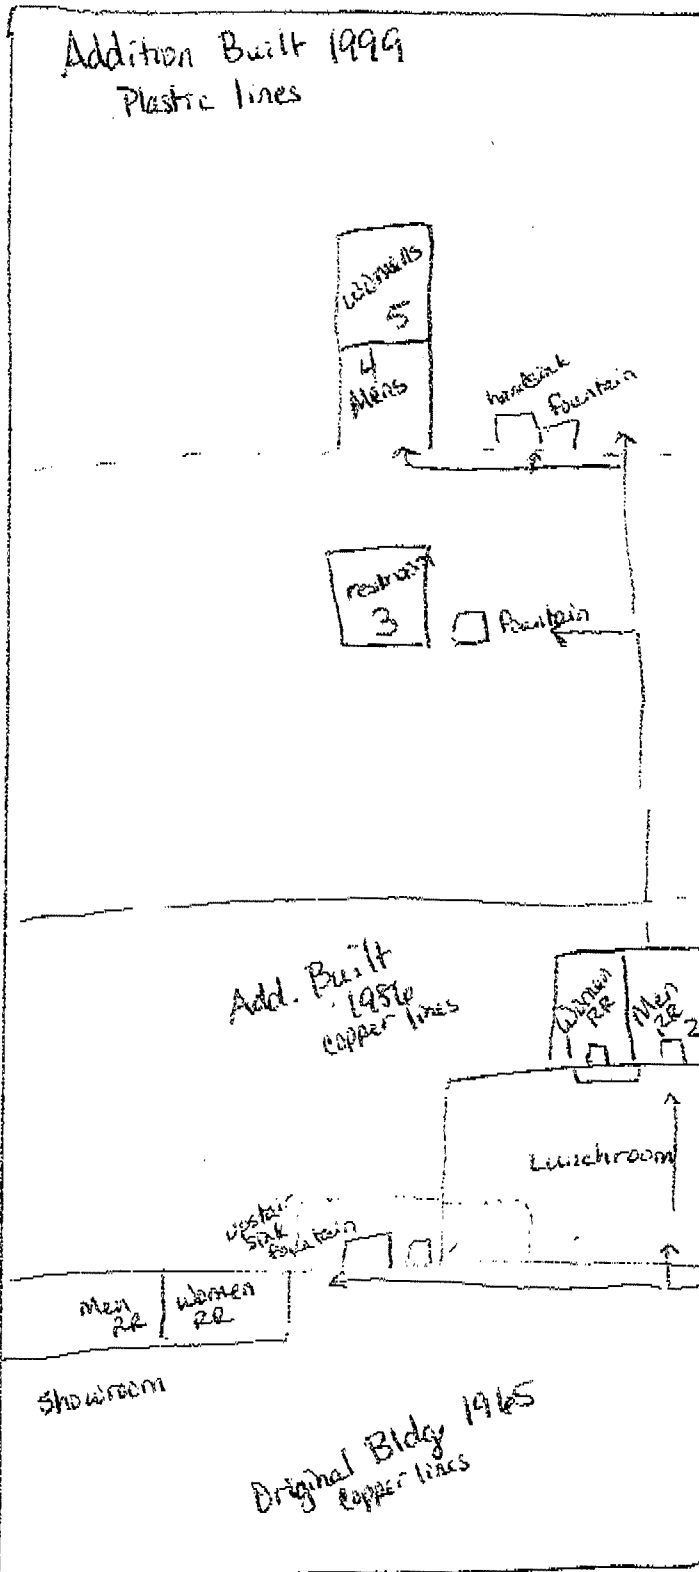


RECEIVED  
MAR 07 2017

BY: .....

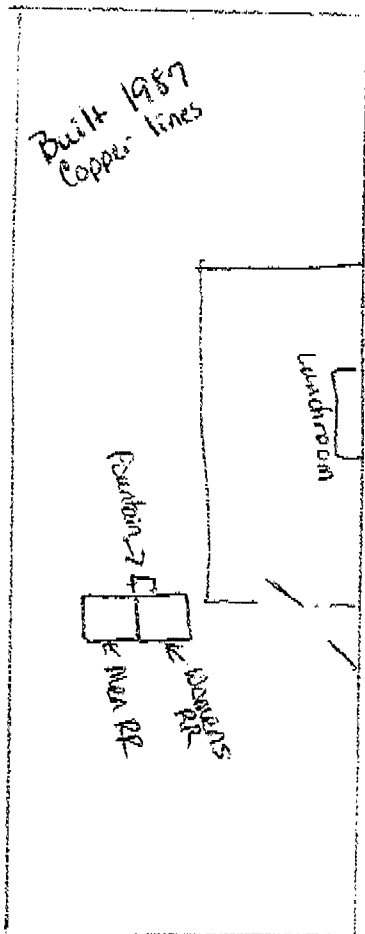

- 3MP001 - Women RR 1st
- 002 - Men RR 1st
- 003 - Eurocase mens RR
- 004 - Plant mens RR
- 005 - Plant womens RR

St. Rt. 241

Mullet Cabinet

Entity: 3M Associates  
 Doc Type: REPORT  
 Doc Subtype: \_\_\_\_\_  
 Program: ADACW  
 County: HOLMES  
 Secondary ID: OH 3848112

7488 St. Rt. 241  
 Millersburg OH 44654  
 PWS#CH3848112