


EMERGENCY EVACUATION MAP

NORTH

OK
Water well

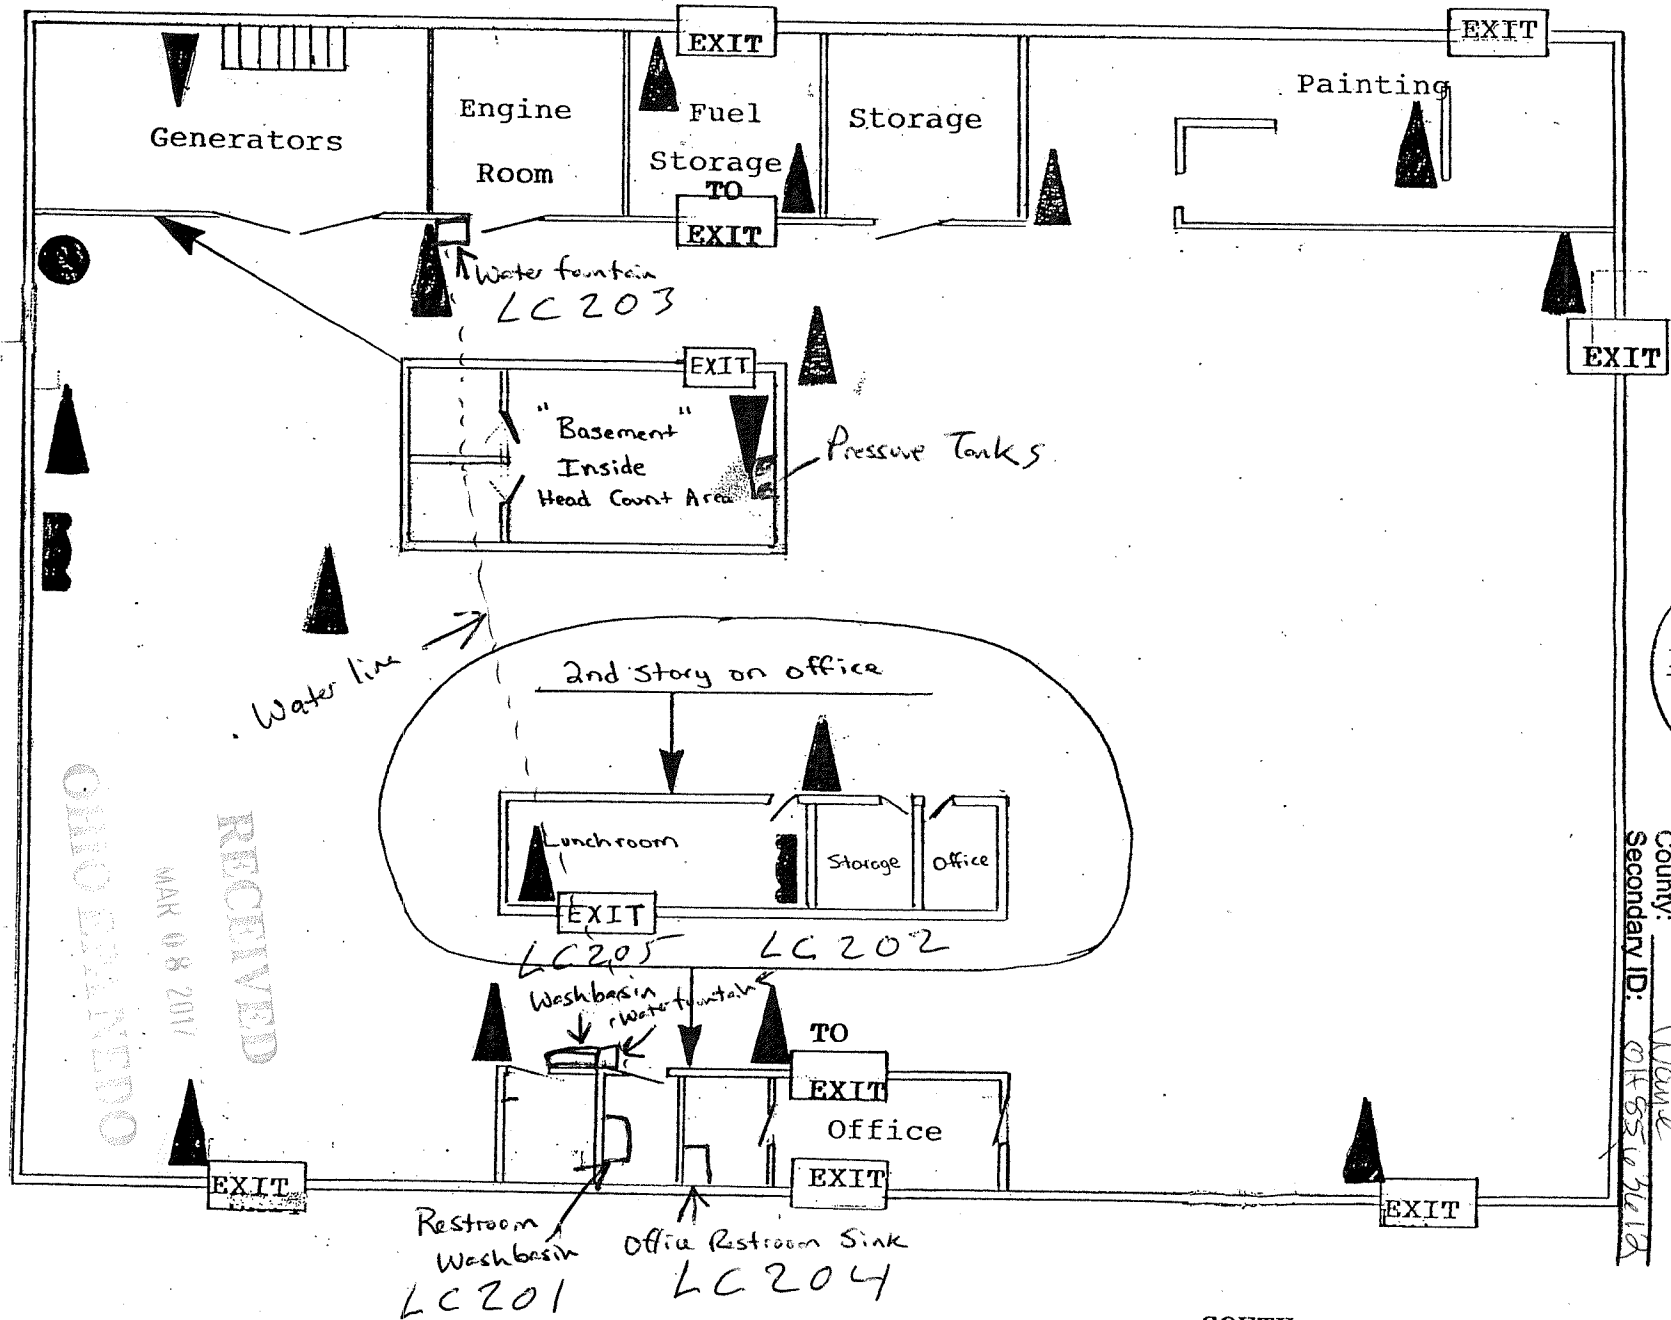

ST

EAST

Head-Count
Area

OHIO EXAMENED
RECEIVED
MAR 08 2011

Entity: Power Equip
 Doc Type: Report
 Doc Subtype: DDA
 Program: DDA
 County: Wade
 Secondary ID: 015543418

SOUTH