


OHIO EPA NEDO

MAR 08 2017

RECEIVED

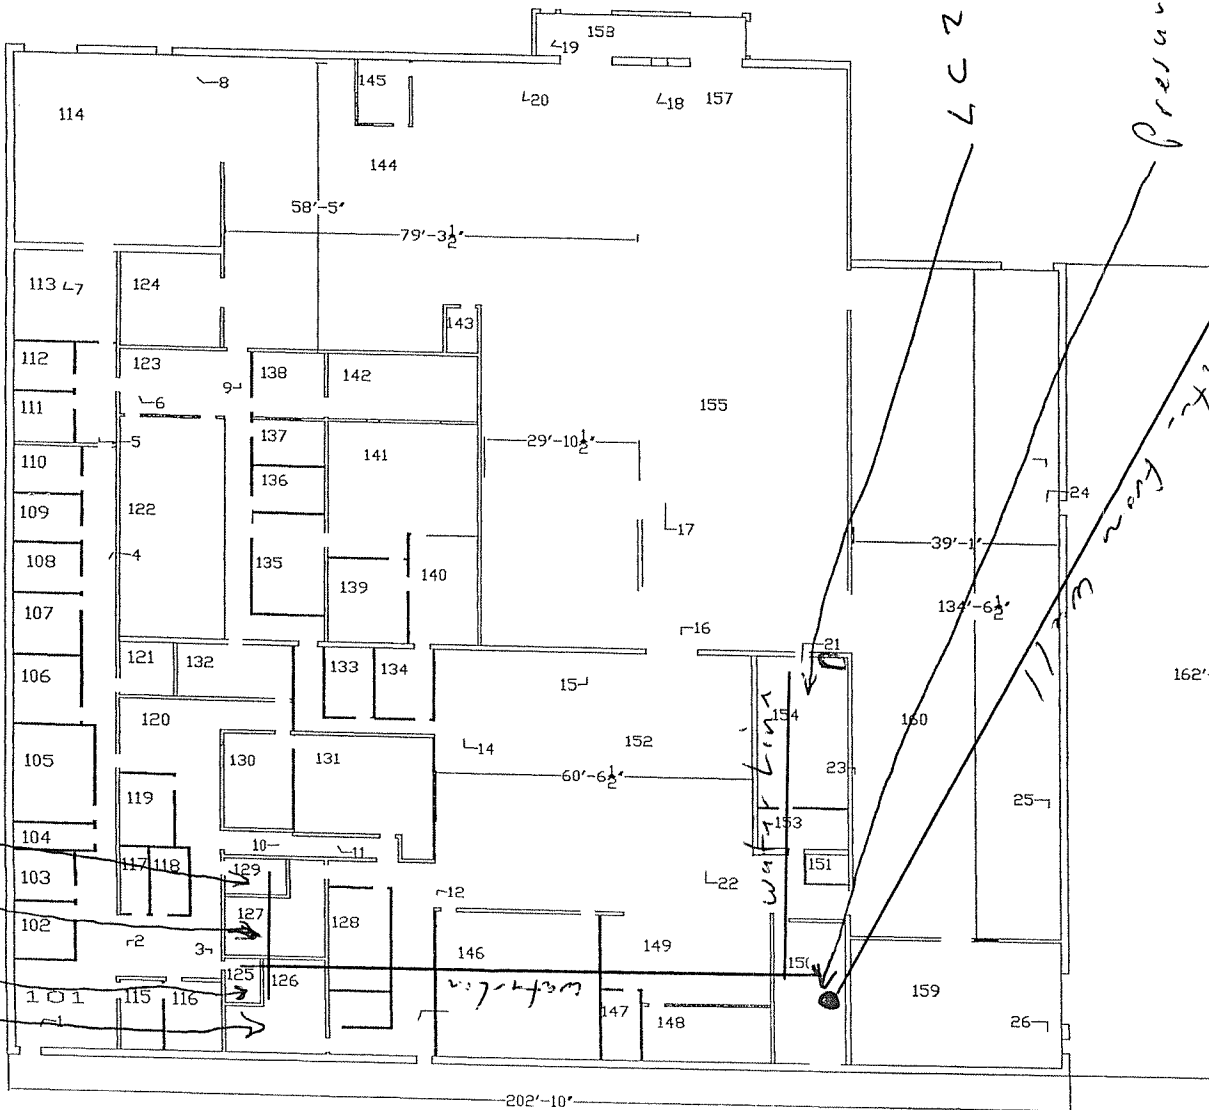


LC 203
LC 201

LC 204
LC 202

LC 205

pressure Tank

well location

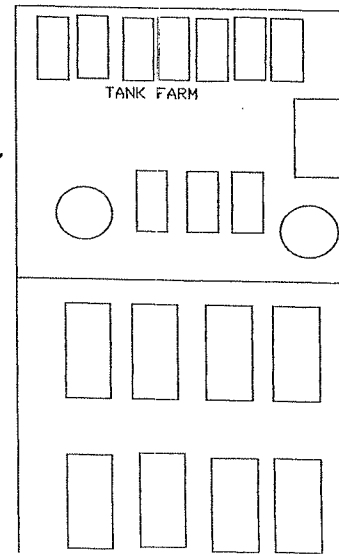

Entity: Chemspec USA
 Doc Type: Report
 Doc Subtype: DDAW
 Program: Waste
 County: OH
 Secondary ID: 018543912