


THE INFORMATION CONTAINED ON THIS DRAWING IS
 NOT BE USED OR REPRODUCED FOR ANY PURPOSE
 OTHER THAN THAT FOR WHICH IT IS SUBMITTED WITHOUT
 1022 HEIL RD. WOOSTER, OHIO 44691

ORIGINAL RELEASE PER Q/RENDWG/FLOOR 1F
 REV A ADD FIRE PULLS TO SOLID EDGE/BUILDING/FLOOR 1F L8 31

FIRST FLOOR

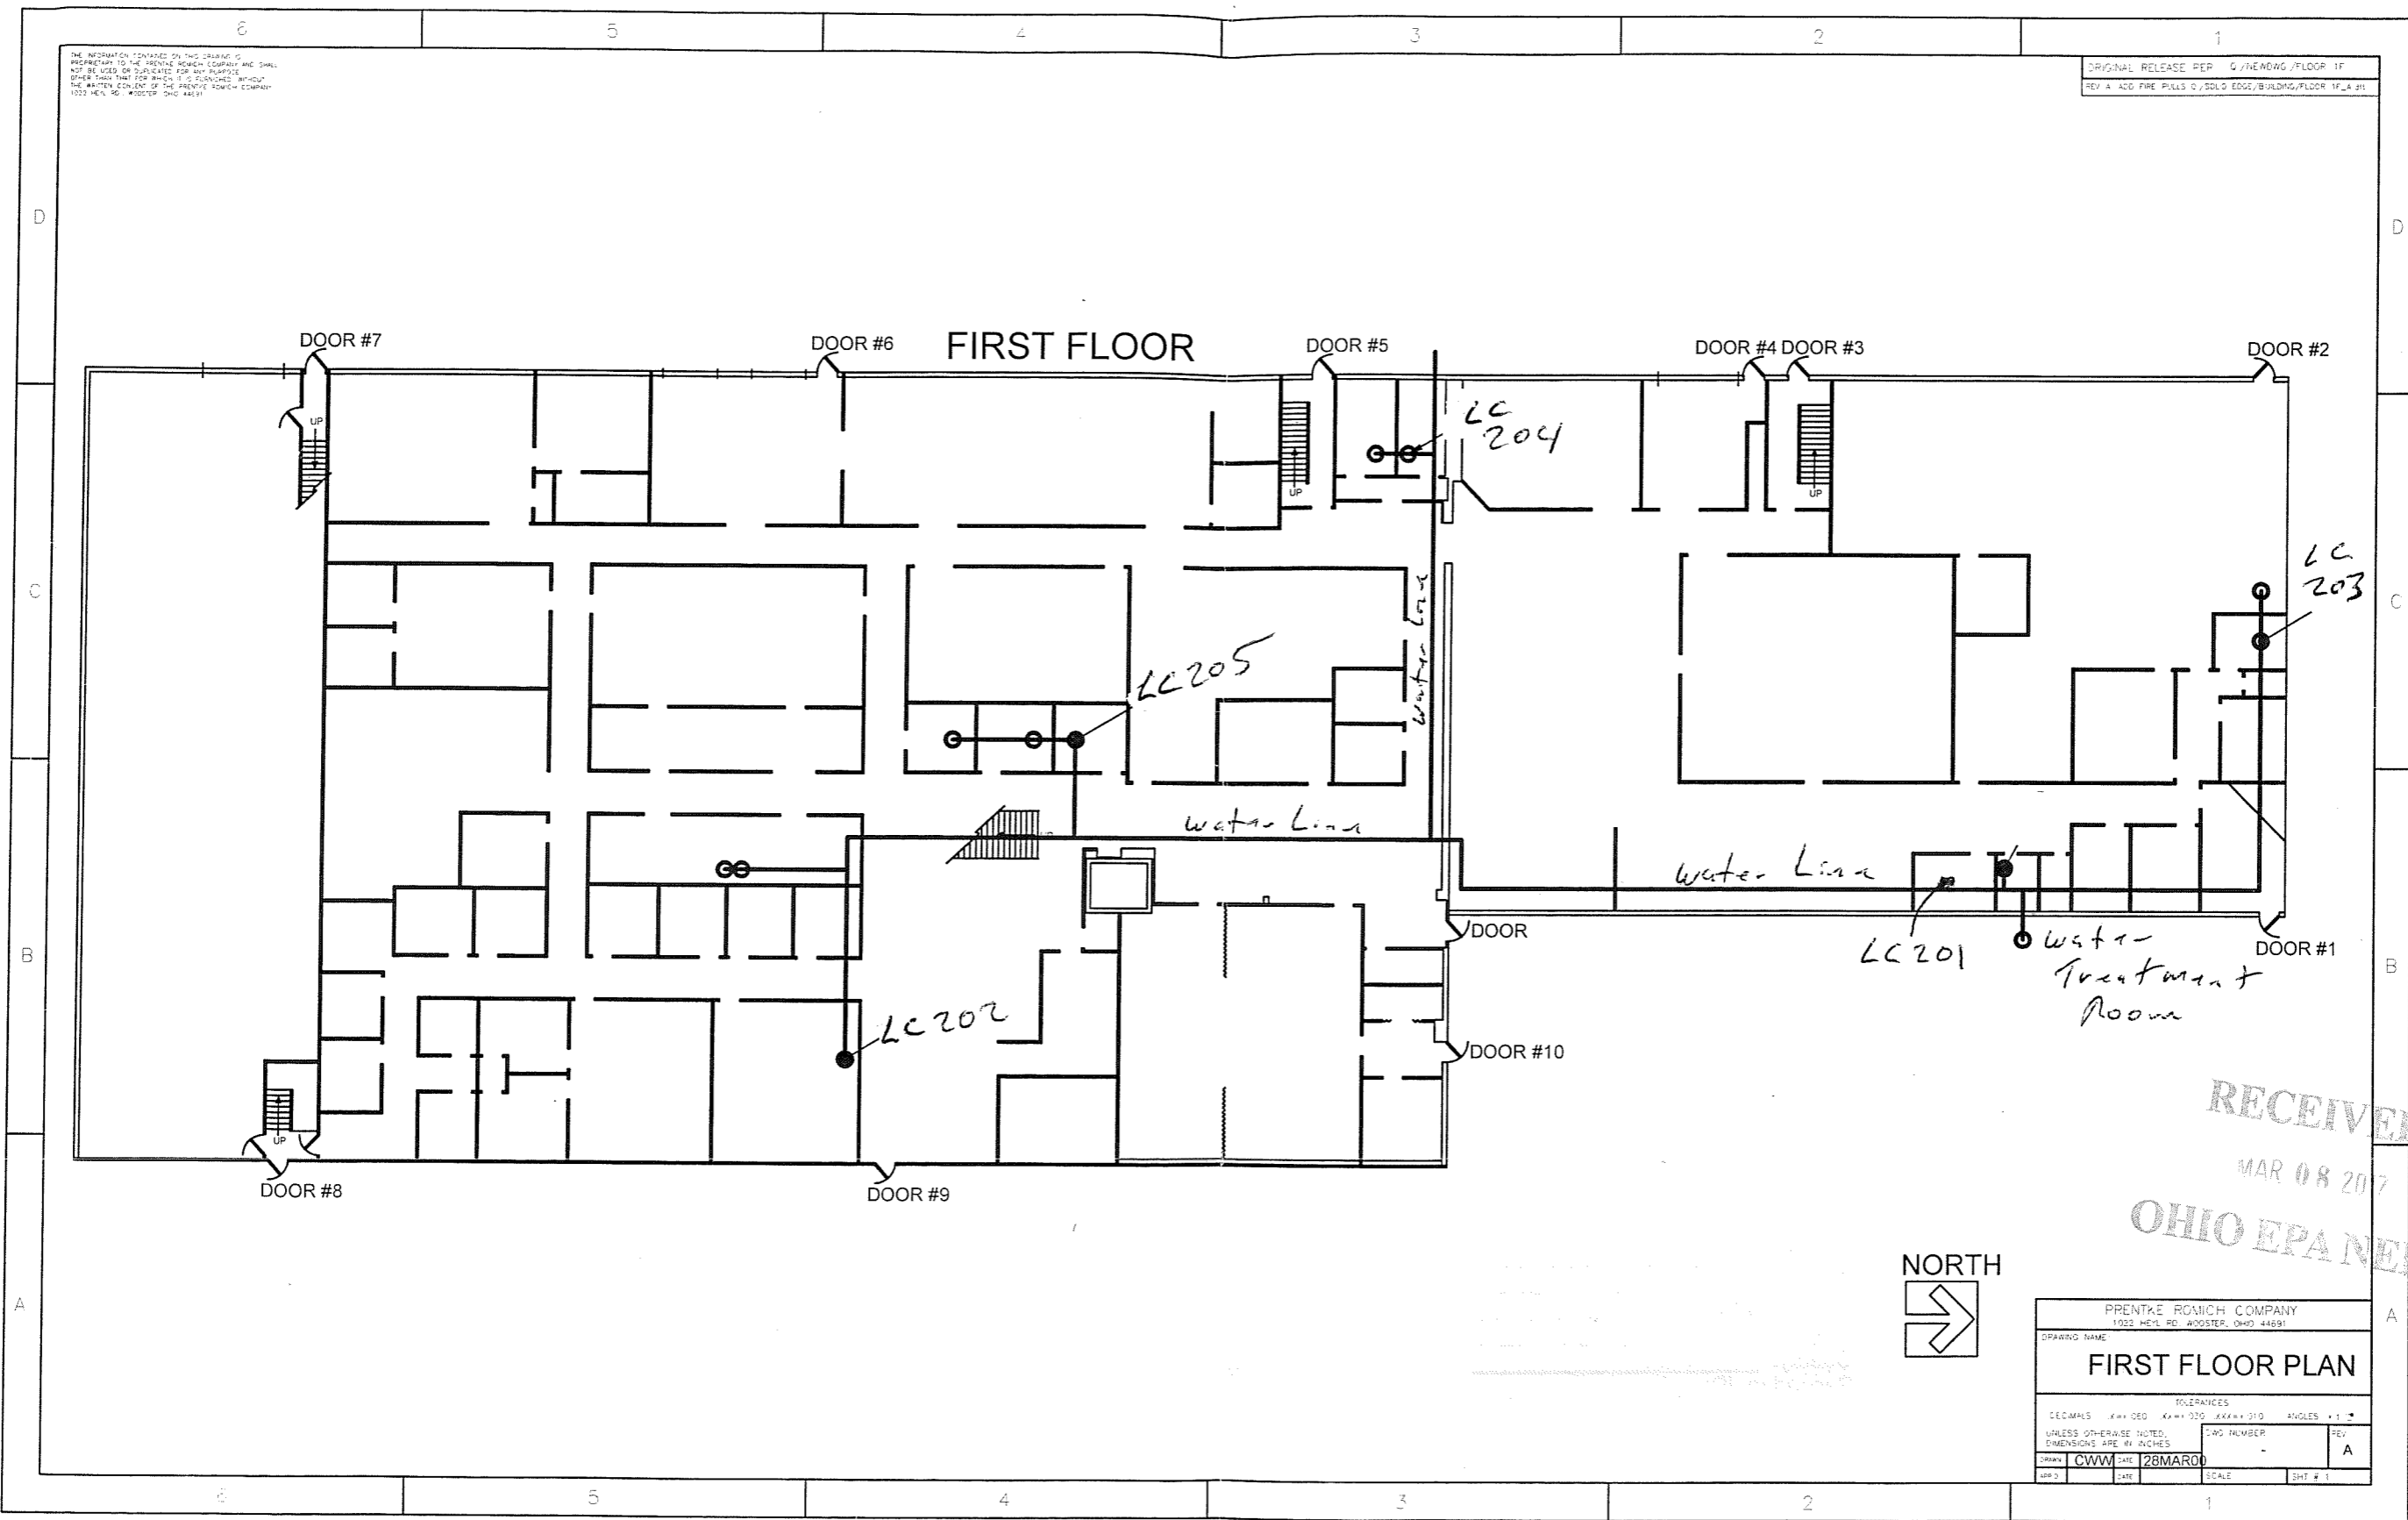

RECEIVED
 MAR 08 2007
 OHIO EPA NEDO



DRAWING NAME FIRST FLOOR PLAN			
TOLERANCES			
DECIMALS	1/8" = 3/16"	1/4" = 3/16"	ANGLES ± 1°
UNLESS OTHERWISE NOTED, DIMENSIONS ARE IN INCHES			REV A
DRWY CWW	DATE 28MAR07	SCALE	SHT # 1