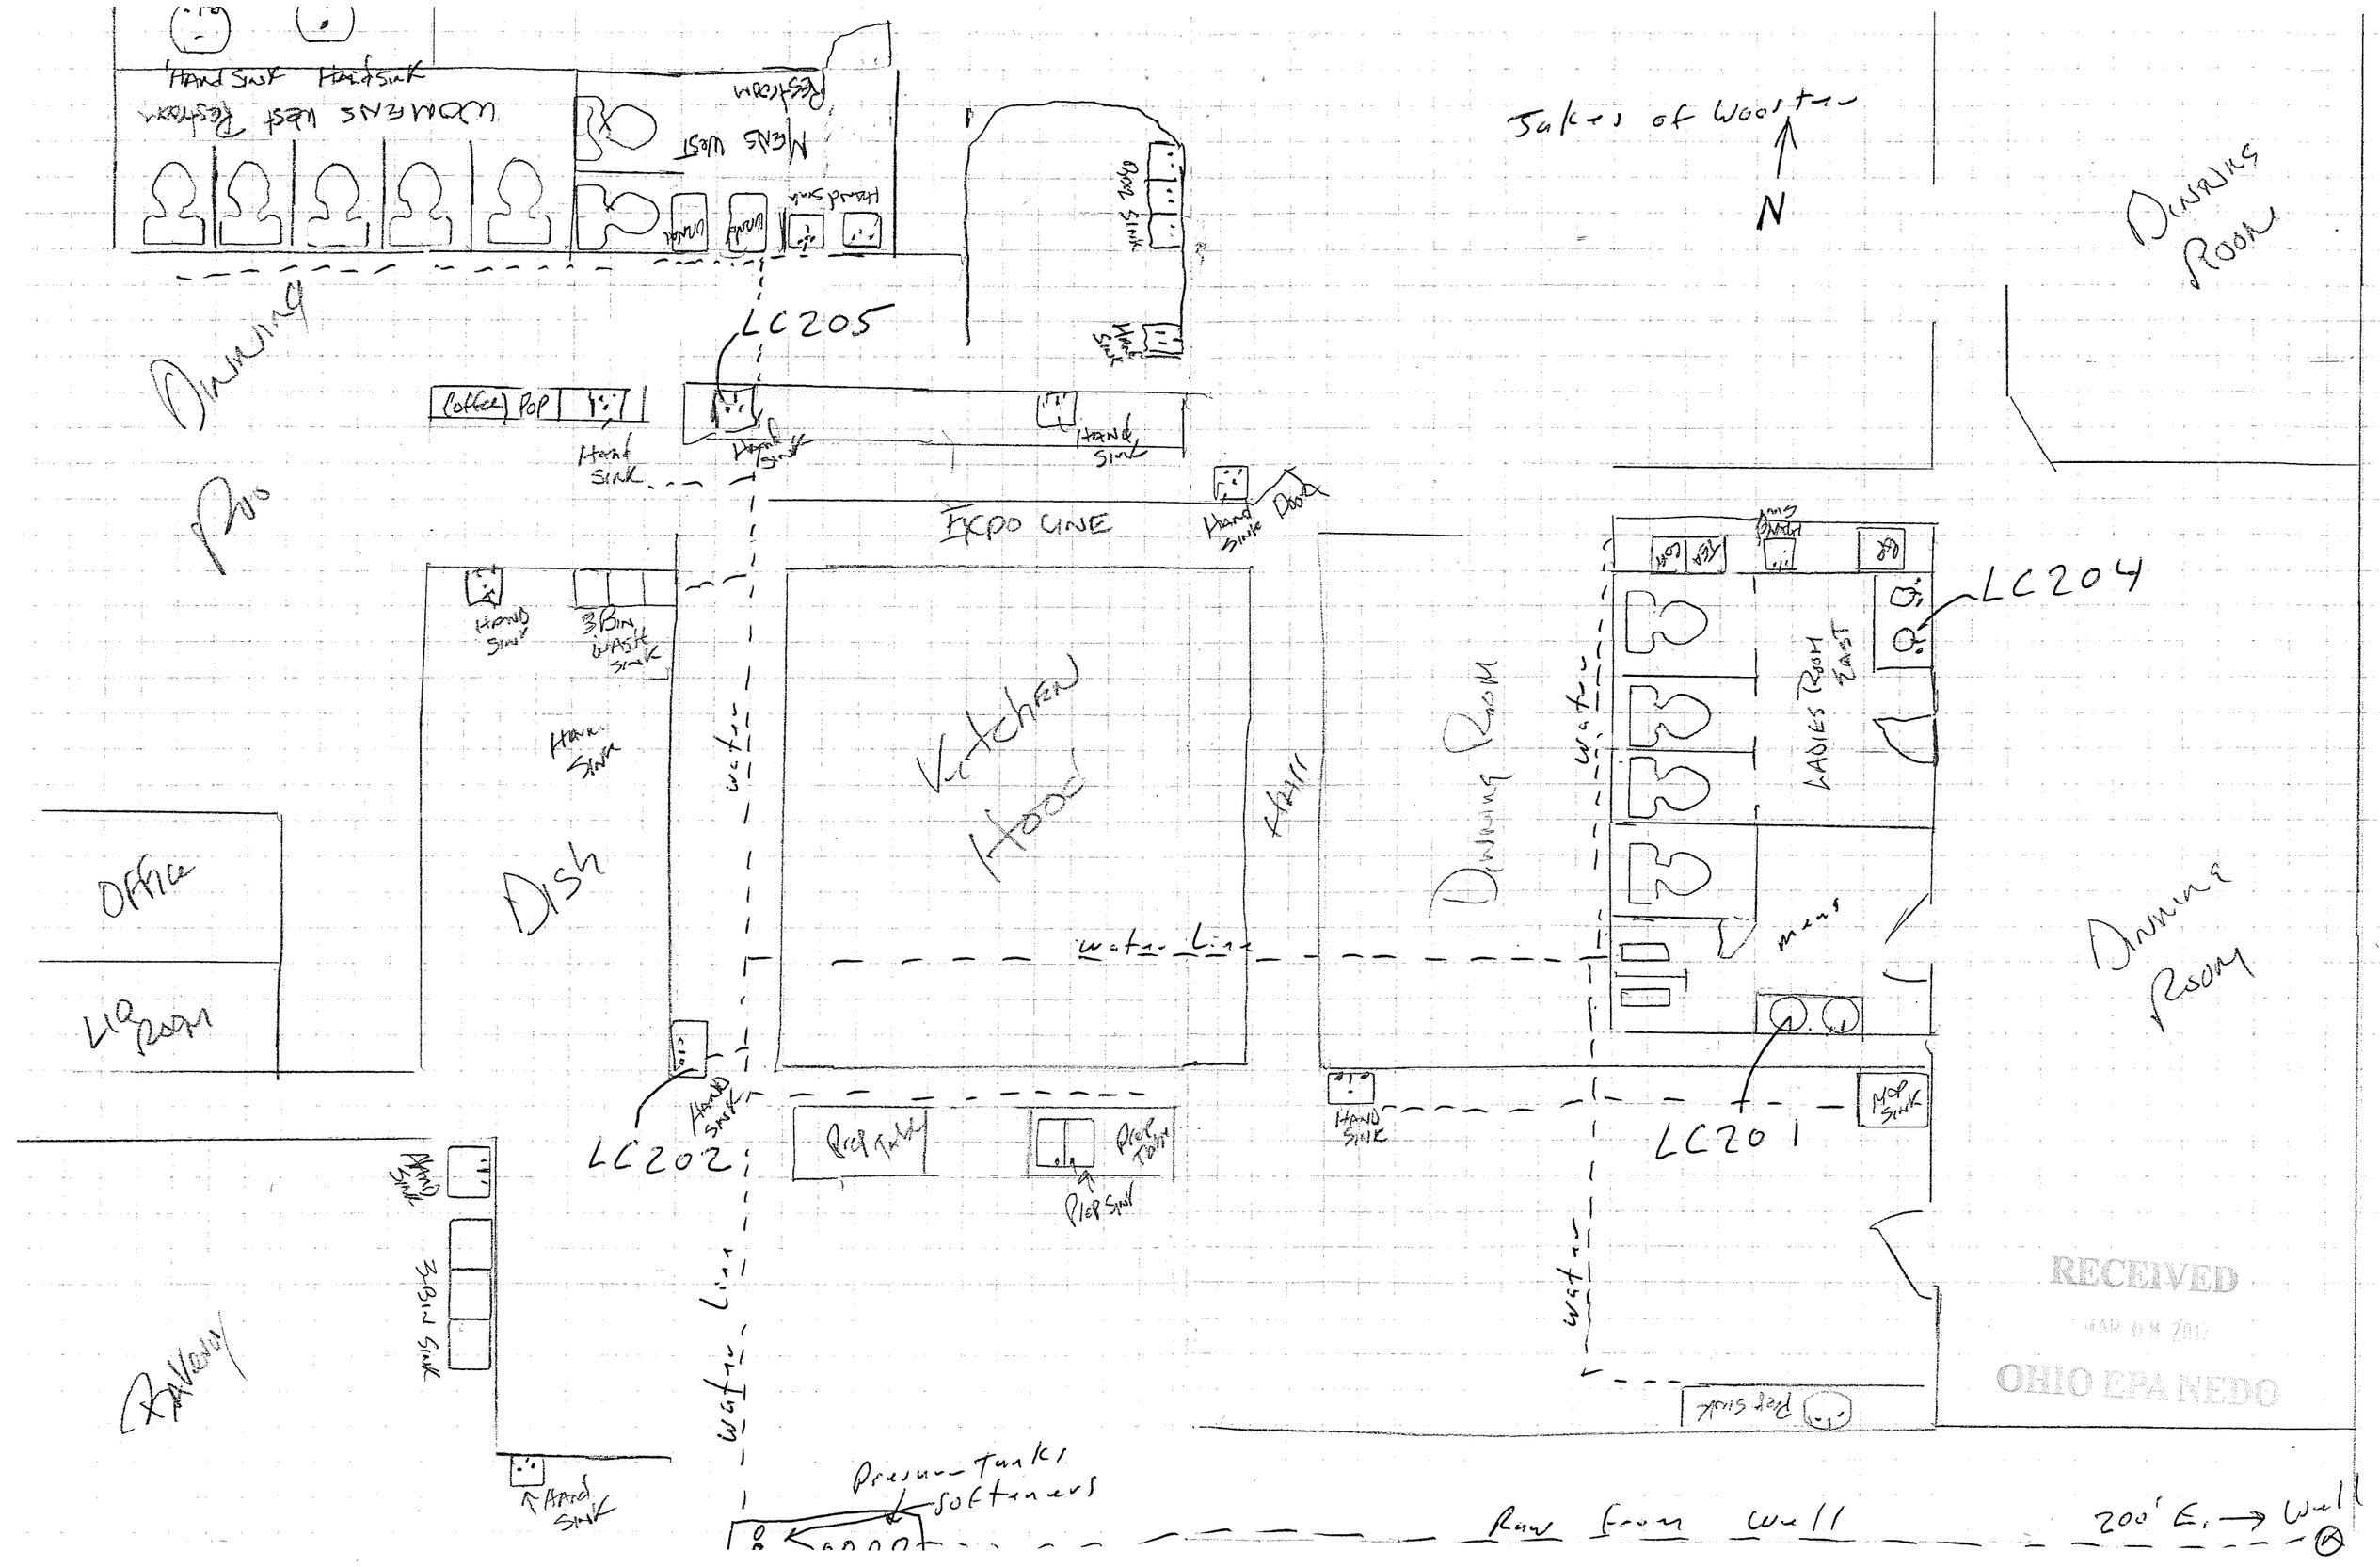

RECEIVED
MAR 05 2012
OHIO EPA NEDO

PINK – FIRE EXTINGUISHER
BLUE – FIRST AID/EYE WASH
PURPLE – TORNADO COVER AREA
GREEN – EXITS

UPPER LEVEL

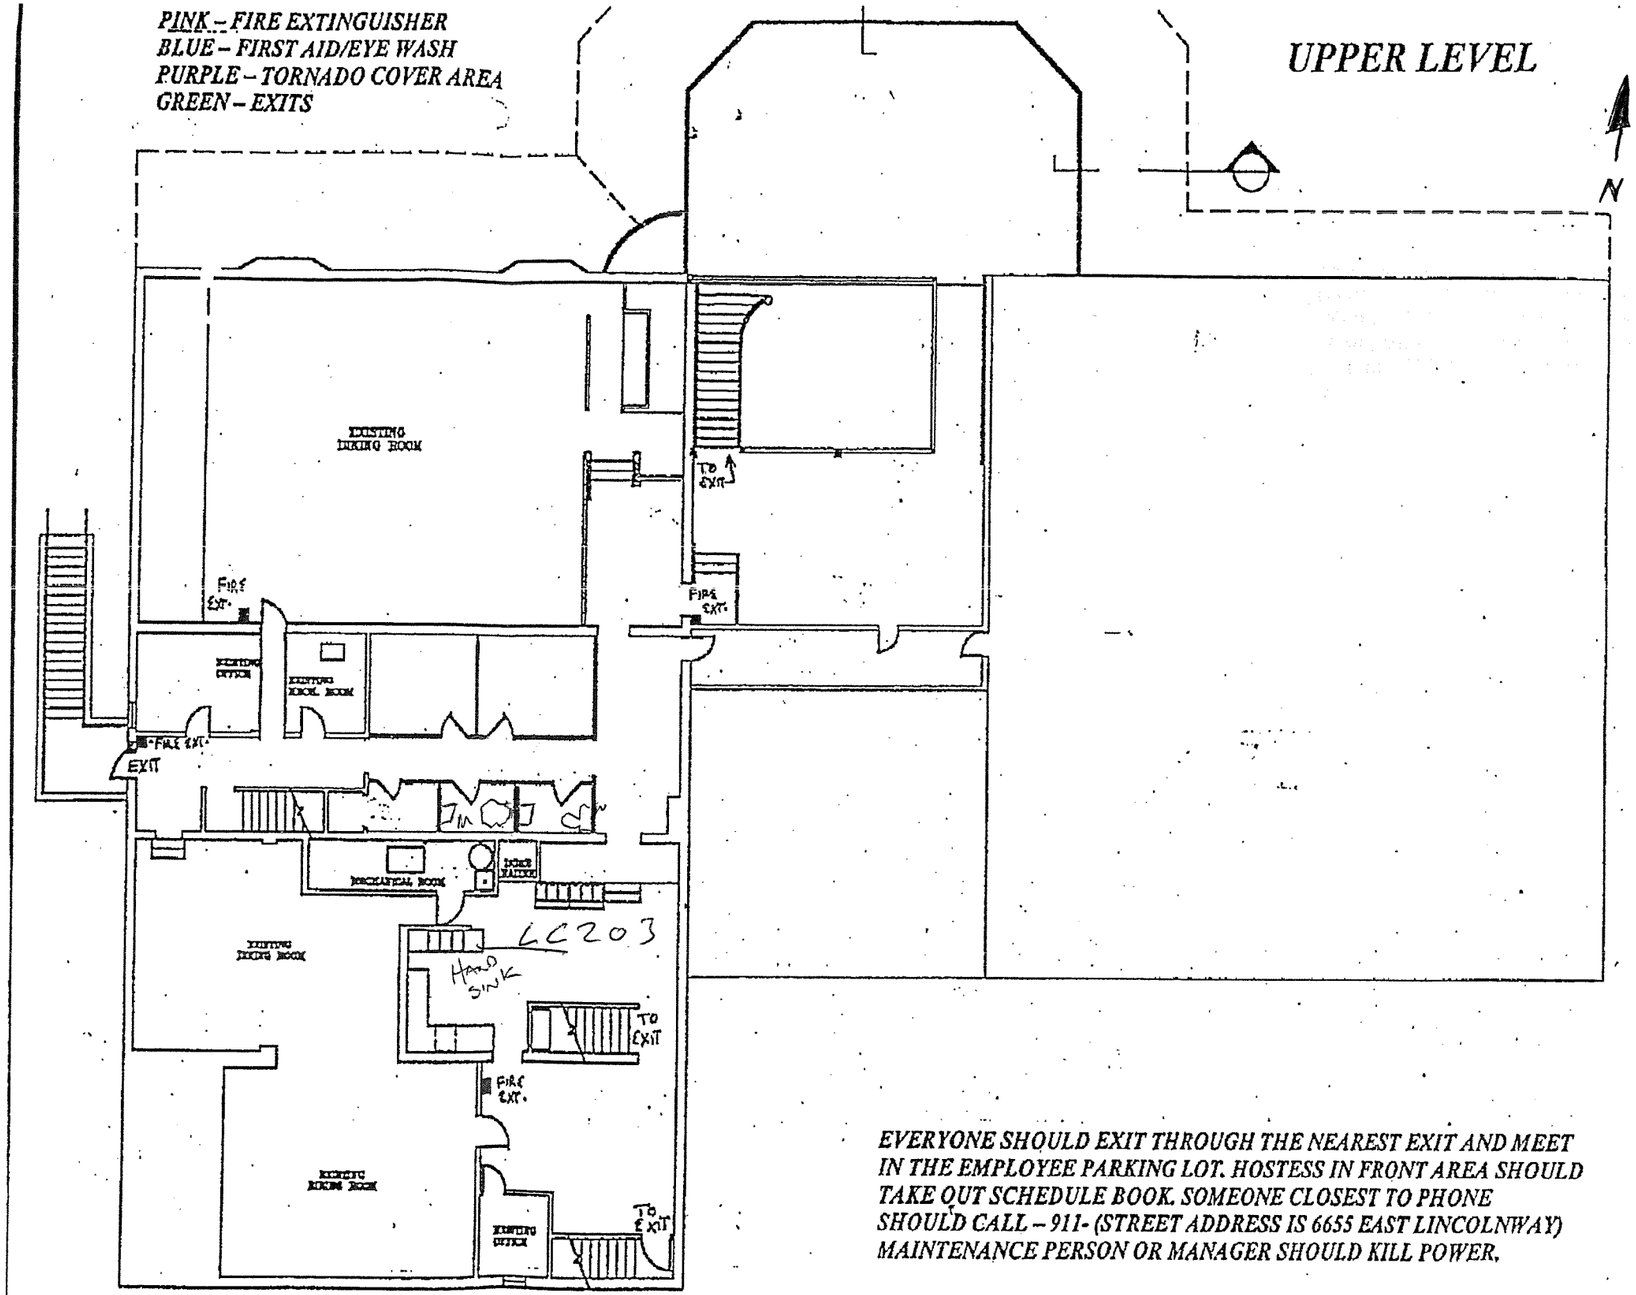

EVERYONE SHOULD EXIT THROUGH THE NEAREST EXIT AND MEET IN THE EMPLOYEE PARKING LOT. HOSTESS IN FRONT AREA SHOULD TAKE OUT SCHEDULE BOOK. SOMEONE CLOSEST TO PHONE SHOULD CALL – 911- (STREET ADDRESS IS 6655 EAST LINCOLNWAY) MAINTENANCE PERSON OR MANAGER SHOULD KILL POWER.

6655 East Lincoln Way
Wooster Ohio 44691

UPSTAIRS
JAKES OF Wooster