





01603B42009

#1254.00

#1253.00

01603B42010

#1254.00

#1267.00

01603B42011

#1274.00

#1285.00

01603B42012

#1284.00

01603B42013

#1295.00

01603B42014

#1300.00

01603B42015

#1314.00

#1307.00

01603B42016

#1314.00

01603B42017

#1275.00

01603B42018

01603B42035


01603B42018

01603B42019



01603B42019


Daleside Systems, Inc.

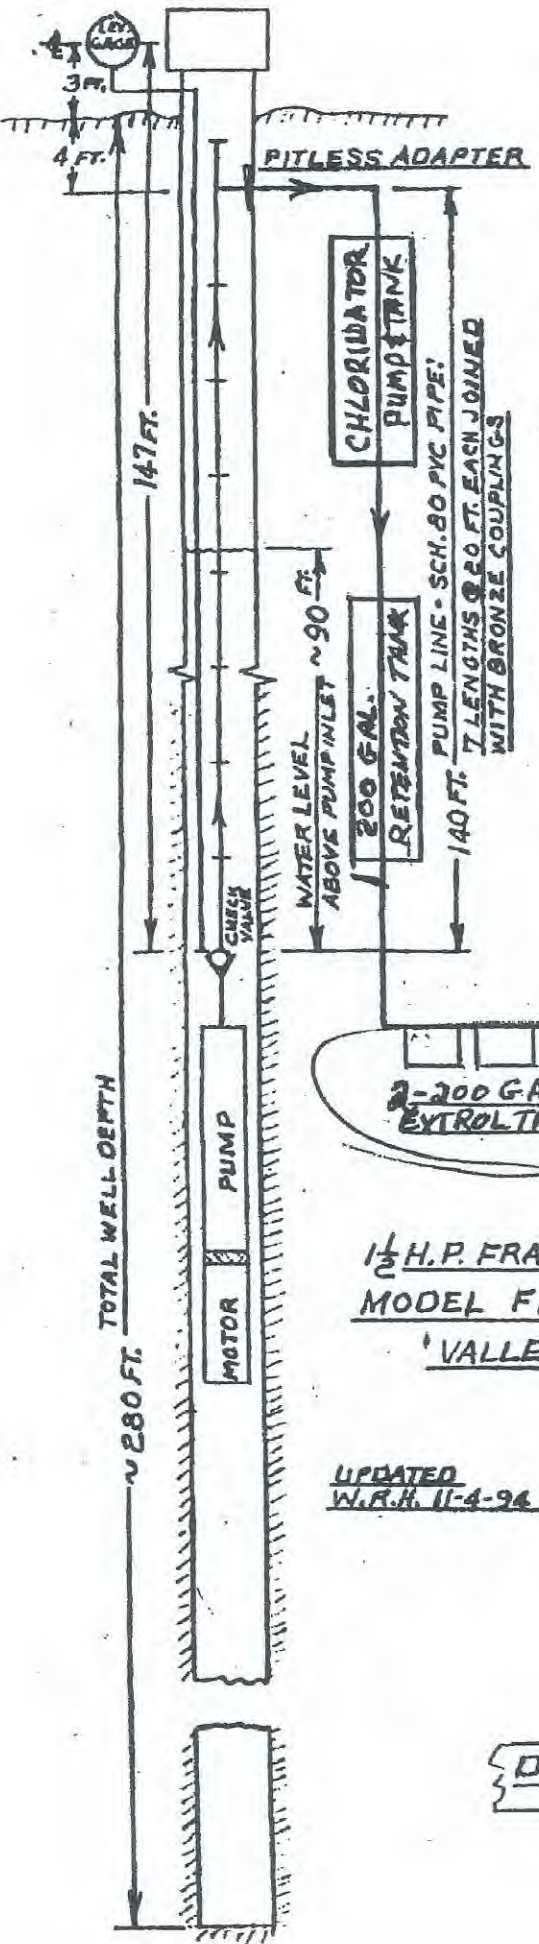

S.R. 303

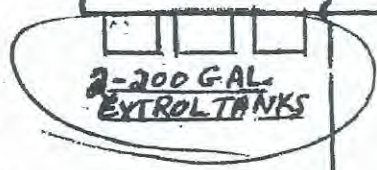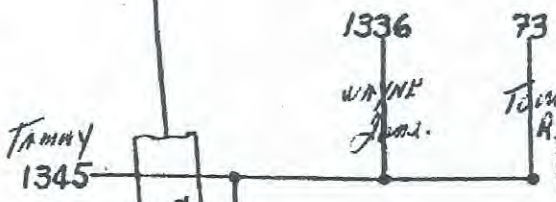


2" YARDLEY 100 PSI GOLDEN JET 11.5 PPI


1 1/2 H.P. FRANKLIN ELEC. CO. MOTOR  
MODEL F1816-MF315A: CODE 1-81

1 VALLEY PUMP CO. PUMP

UPDATED  
W.R.H. 11-4-94

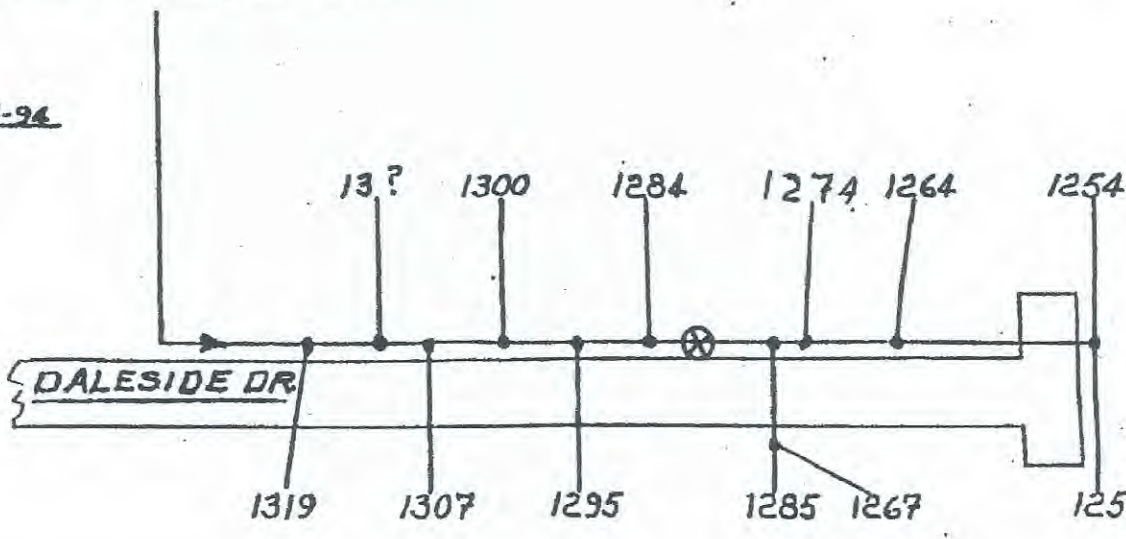

01603B42039

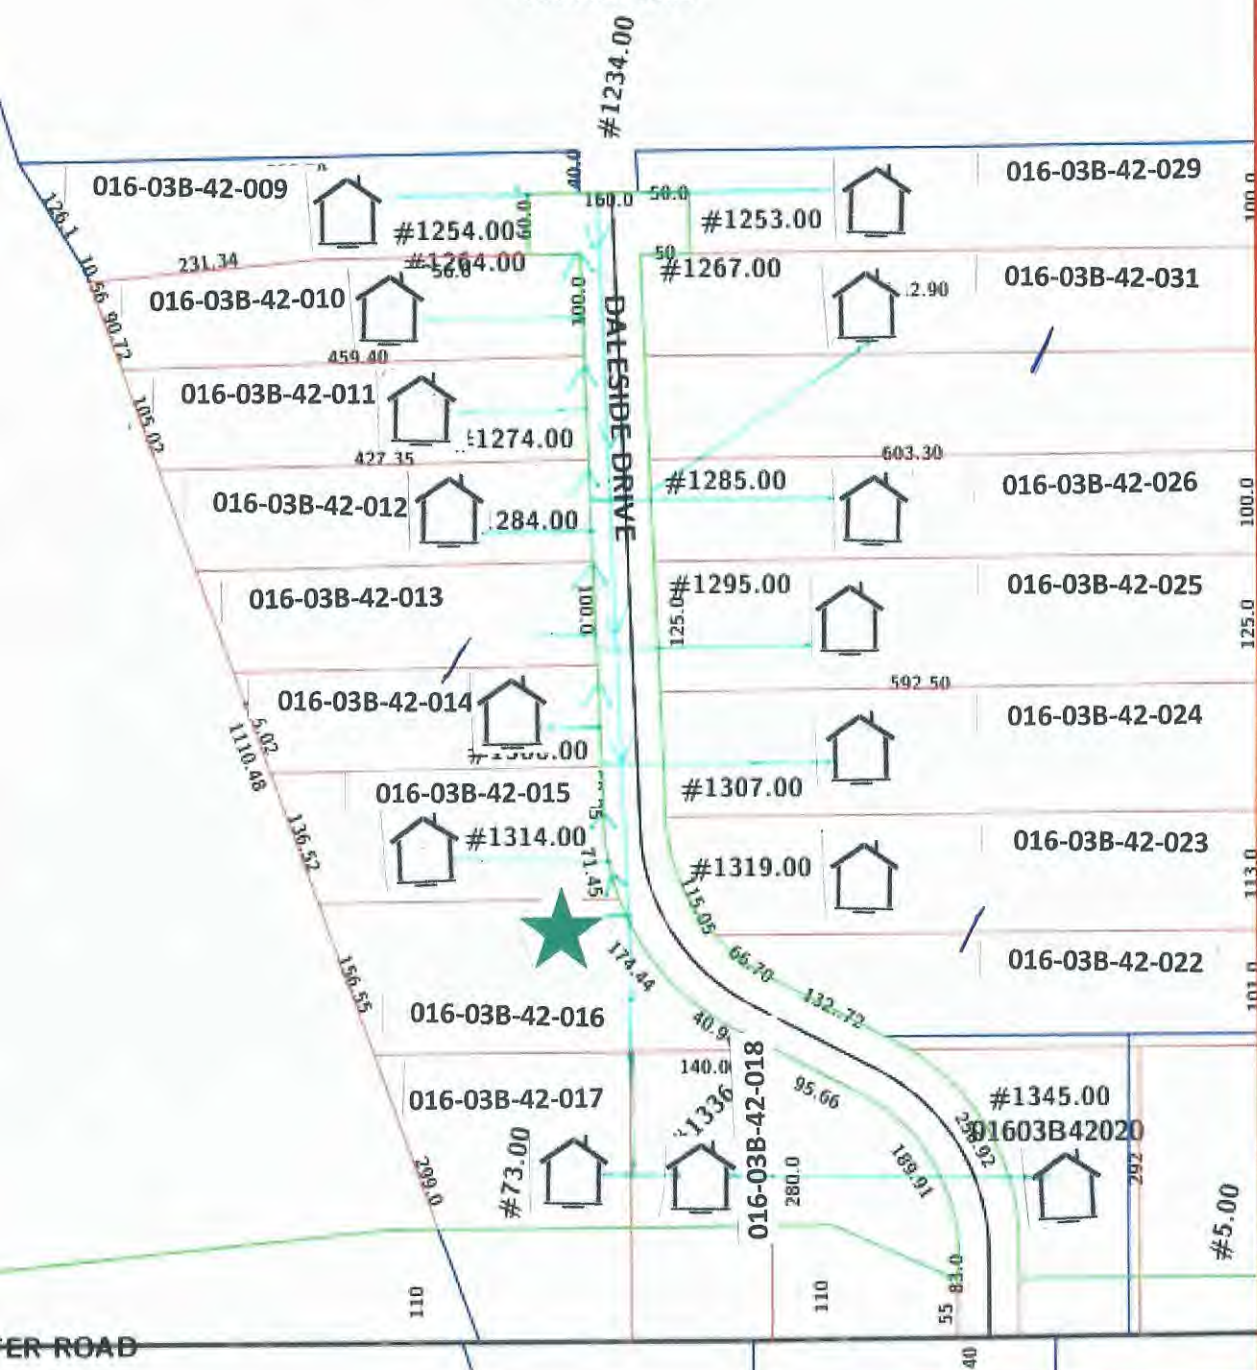

PWS ID# 5200112  
Daleside Systems, Inc.

Contact Info:  
Peg Patterson  
330-461-3088  
chapalapeg@gmail.com

