



#	DESCRIPTION	DATE	APPROVED
0	INITIAL MAPPING	3/7/2017	PAT WHITAKER

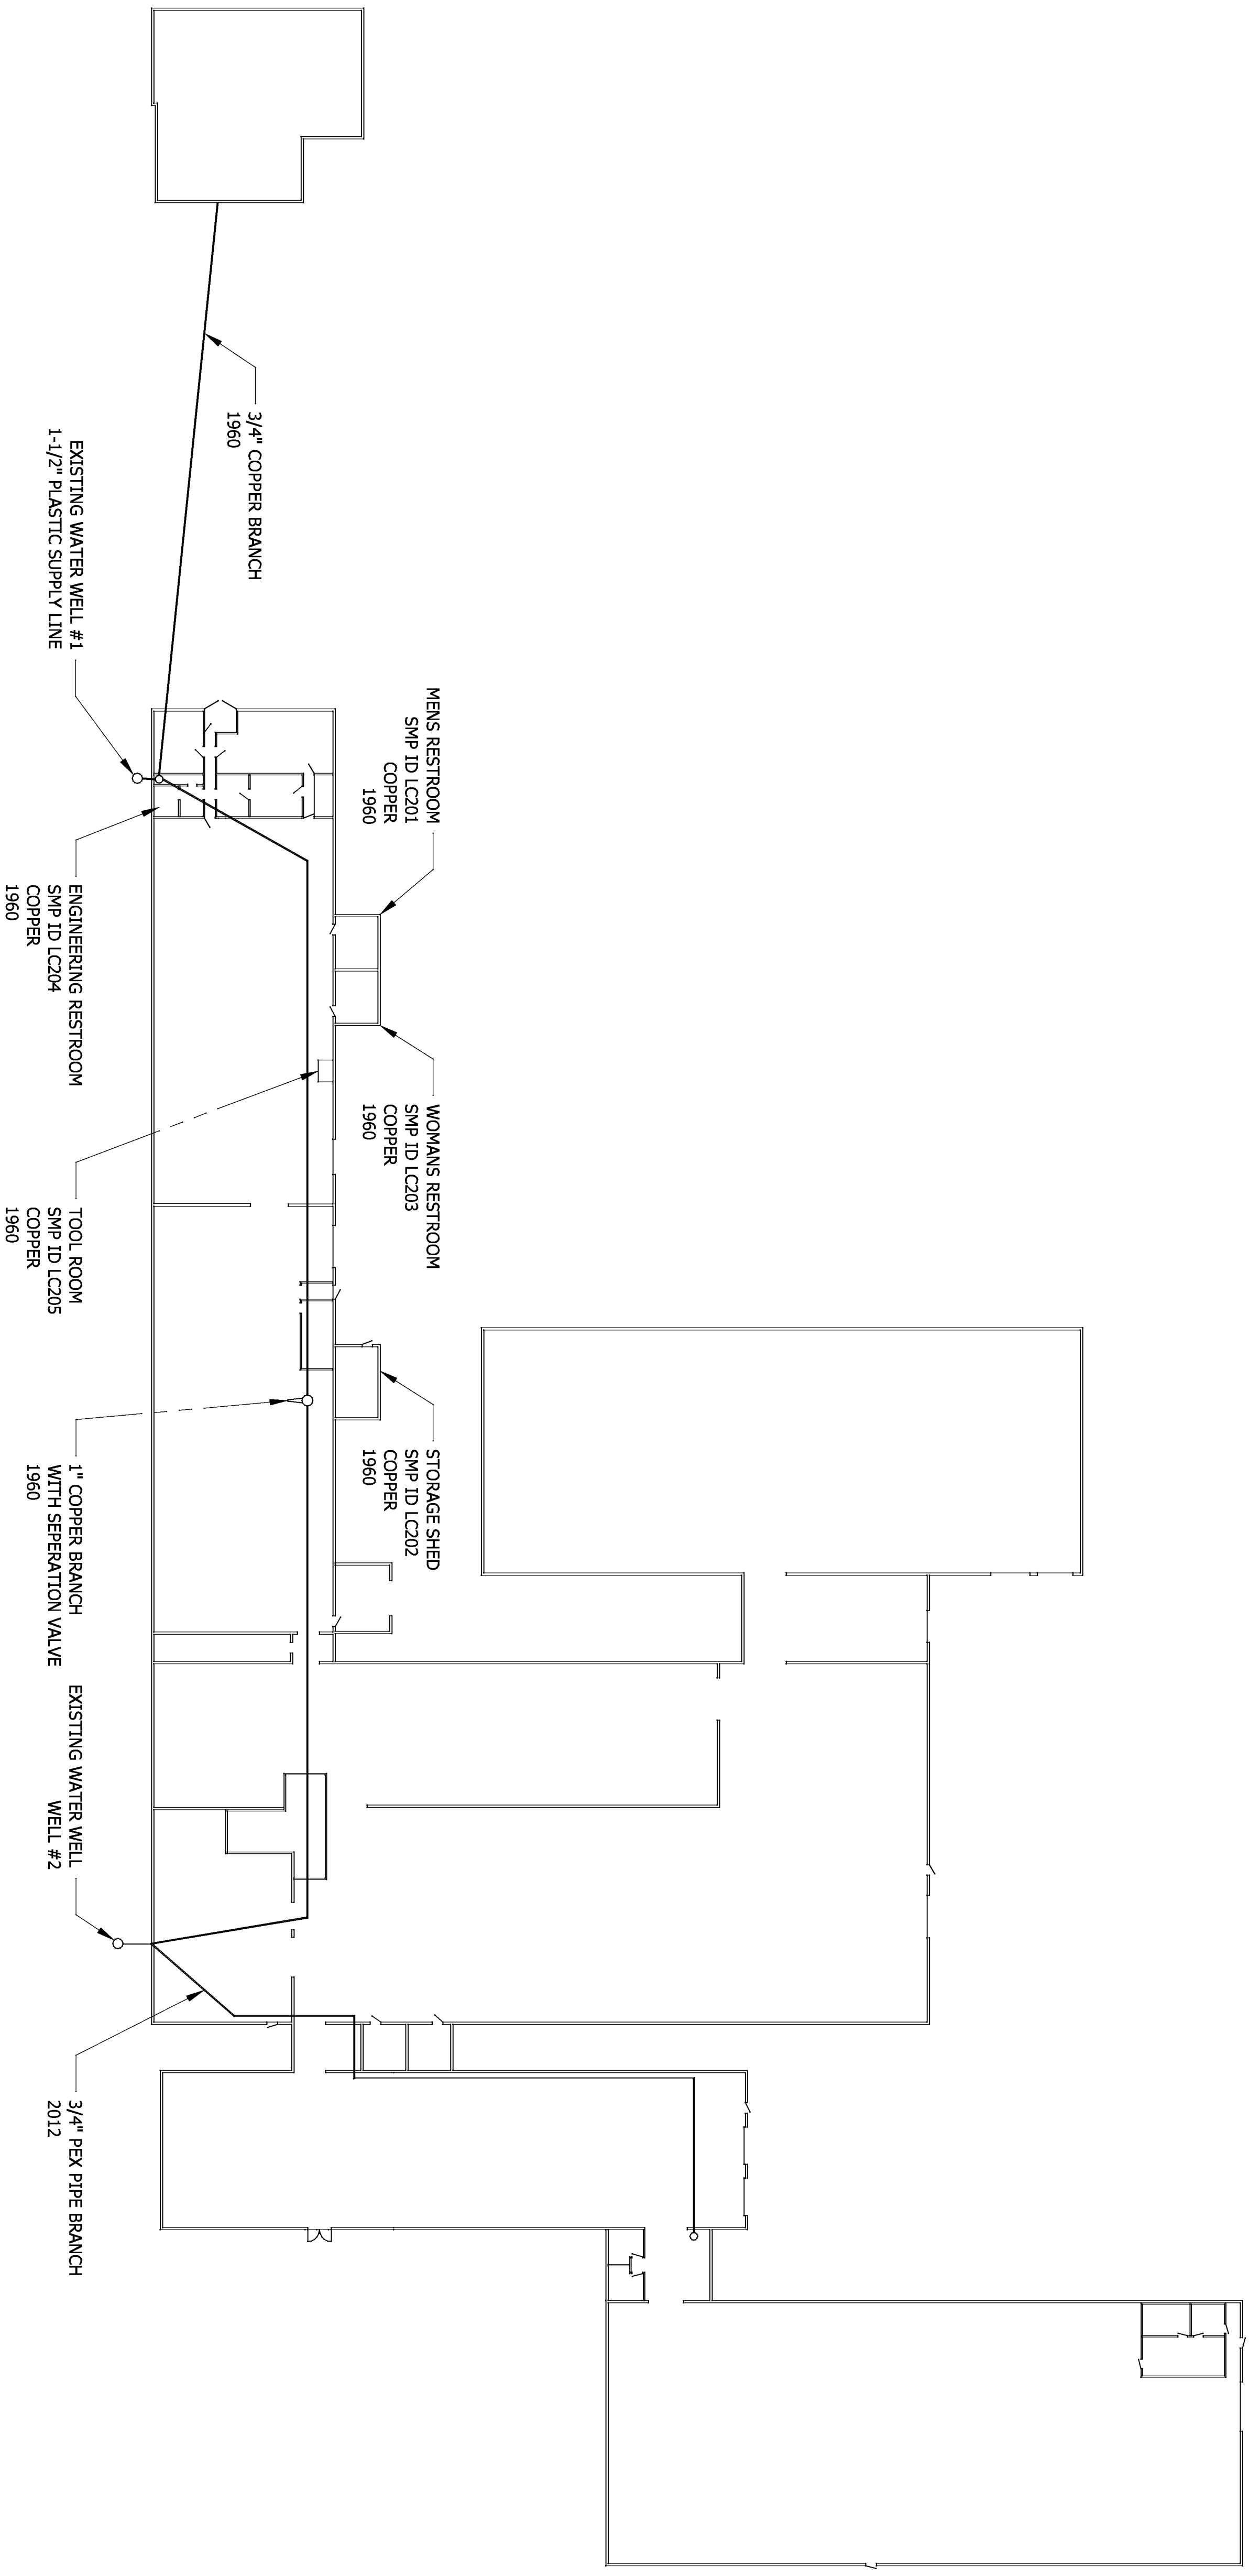

**MARLBORO MANUFACTURING, INC.**  
 11750 MARLBORO AVE. N.E.  
 ALLIANCE, OHIO 44601  
 330-935-2445  
 PWS ID: OH7638512

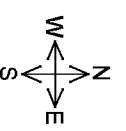

<b>MARLBORO</b>		MANUFACTURING, INC.	
11750 MARLBORO AVE. ALLIANCE, OHIO 44601			
DESCRIPTION	LEAD MAPPING & SAMPLE MONITORING POINTS	DATE	3/7/2017
PWS ID NUMBER	OH7638512	SCALE	NTS
DETAIL NUMBER	N/A	SHEET NO.	1 OF 1
DRAWN BY	PAT WHITAKER	DATE	3/7/2017
		SCALE	NTS
		SHEET	D