


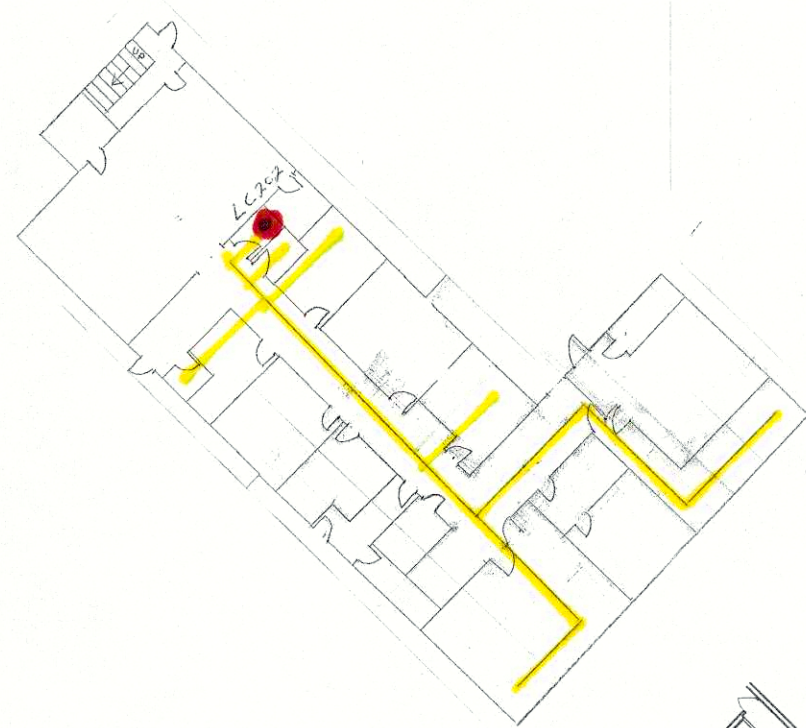


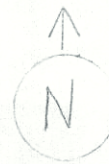

BASEMENT PLAN
1/16" = 1'-0"

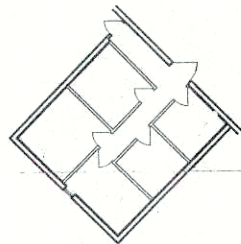

BASEMENT PLAN
1/16" = 1'-0"

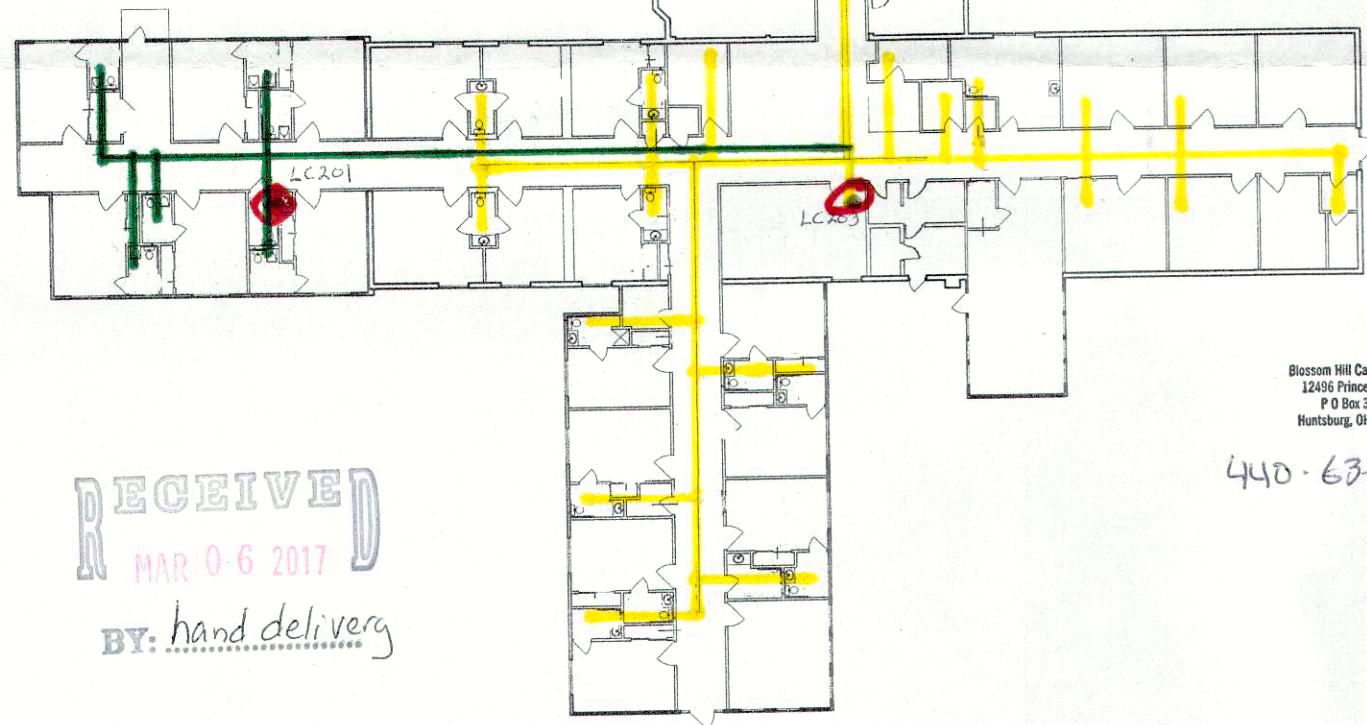

Blossom Hill Care Center
P.O. Box 369
Huntsburg, OH 44046

440-635-5567

- Yellow - Lead
 - Green - No Lead
 - Red dot - Sample Locations
- All locations are Tier 2

OH 2800212



FIRST FLOOR PLAN
1/16" = 1'-0"

RECEIVED
MAR 06 2017
BY: hand delivery

Entity: Blossom Hill Care Center
Doc Type: Report
Doc Subtype:
Program: Drinking Water
County: Geauga
Secondary ID: OH 2800212

Princeton Rd.