

MAPLEWOOD ELEMENTARY SCHOOL 1ST FLOOR

1699 Kinsman rd.NE
North Bloomfield, Ohio 44450
Phone 330 583-2321
PWS ID OH 7849112
Facility ID 7859230

All service lines are copper after 1986
New building addition and all water lines replaced
in the old building finished in 2003

- 1 WATER CONNECTION FROM WELL PVC TO CAST IRON THROUGH BLDG TO COPPER
- 2 A & B WATER SOFTENERS COPPER RM 113
- 3 ABC RETENTION TANKS COPPER TO PVC TO COPPER
- 4 AB PRESSURE TANKS COPPER
- 5 ARSENIC REMOVAL SYSTEM SOPPER TO PVC TO COPPER
- 6 SINK COPPER RM 111
- 7 DRINKING FOUNTAIN COPPER OUTSIDE RM 110
- 8 ABC SINKS COPPER GIRLS REST ROOM
- 9 SINK COPPER BOYS RESTROOM
- 10 SINK COPPER CLINIC
- 11 SINK COPPER CLINIC REST ROOM
- 12 SINK COPPER OFFICE REST ROOM
- 13 SINK COPPER OFFICE WORK ROOM
- 14 SINK COPPER LIBRARY WORK ROOM
- 15 DRINKINGFOUNTAIN COPPER CAFETERIAL 116
- 16 DRINKING FOUNTAIN COPPER STAIRWELL OUTSIDE LIBRARY
- 17 3 BAY SINK COPPER KITCHEN
- 18 DISHWASHER COPPER KITCHEN
- 19 2 BAY SINK COPPERKITCHEN
- 20 HANDSINK COPPER KITCHEN
- 21 SINK COPPER BOYSREST ROOM
- 22 SINK COPPER GIRLS RESTROOM
- 23 SINK COPPER BETWEEN BOYS & GIRLS RESTROOMS
- 24 SINK COPPER RM 121
- 25 SINK COPPER STAFF REST ROOM
- 26 SINK COPPER RM 129A
- 27 SINK COPPER REST ROOM KITCHEN
- 28 SINK COPPER STAFF REST ROOM
- 29 SINK COPPER RM 125
- 30 SINK COPPER REST RM 125
- 31 SINK COPPER RM 126
- 32 SINK COPPER RM 126 REST ROOM
- 33 SINK COPPER RM 128
- 34 SINK COPPER REST RM RM 128
- 35 SINK COPPER RM 127
- 36 SINK COPPERREST ROOM RM 127

Entity: Maplewood Elementary School
Doc Type: REPORT
Doc Subtype: _____
Program: Drinking water
County: TRUMBULL
Secondary ID: OH 7849112

RECEIVED

MAR 06 2007

OHIO EDO



MAPLEWOOD ELEMENTARY SCHOOL 2ND FLOOR

- 1 DRINKING FOUNTAIN COPPER OUTSIDE HALL RM 208
- 2 SINK COPPER RM 208
- 3 AB SINKS COPPER BOYS REST ROOM
- 4 AB SINKS COPPER GIRLS REST ROOM
- 5 SINK COPPER RM 223
- 6 SINK COPPER RM 222
- 7 SINK COPPER RM 221
- 8 SINK COPPER RM 219
- 9 SINK COPPER RM 218
- 10 SINK COPPER RM 217
- 11 SINK COPPER RM 216
- 12 SINK COPPER RM 215
- 13 SINK COPPER RM 214
- 14 SINK COPPER RM 213
- 15 SINK COPPER GIRLS REST ROOM
- 16 SINK COPPER BOYS REST ROOM
- 17 ABC SINKS COPPER BETWEEN GIRLS & BOYS RESTROOM

MAPLEWOOD ELEMENTARY SCHOOL 3RD FLOOR

- 1 DRINKING FOUNTAIN COPPER OUTSIDE HALL RM 304A
- 2 SINK COPER RM 306 RESTROOM
- 3 SINK COPER STAFF RESTROOM
- 4 SINK COPER STAFF RESTROOM
- 5 SINK COPER ART ROOM 307
- 6 SINK COPER ART ROOM 307
- 7 SINK COPER MUSIC ROOM 303

MAPLEWOOD ELEMENTARY SCHOOL
FIRST FLOOR

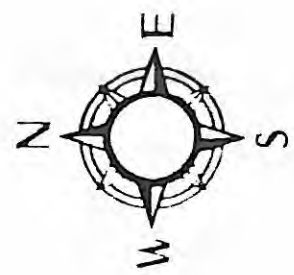
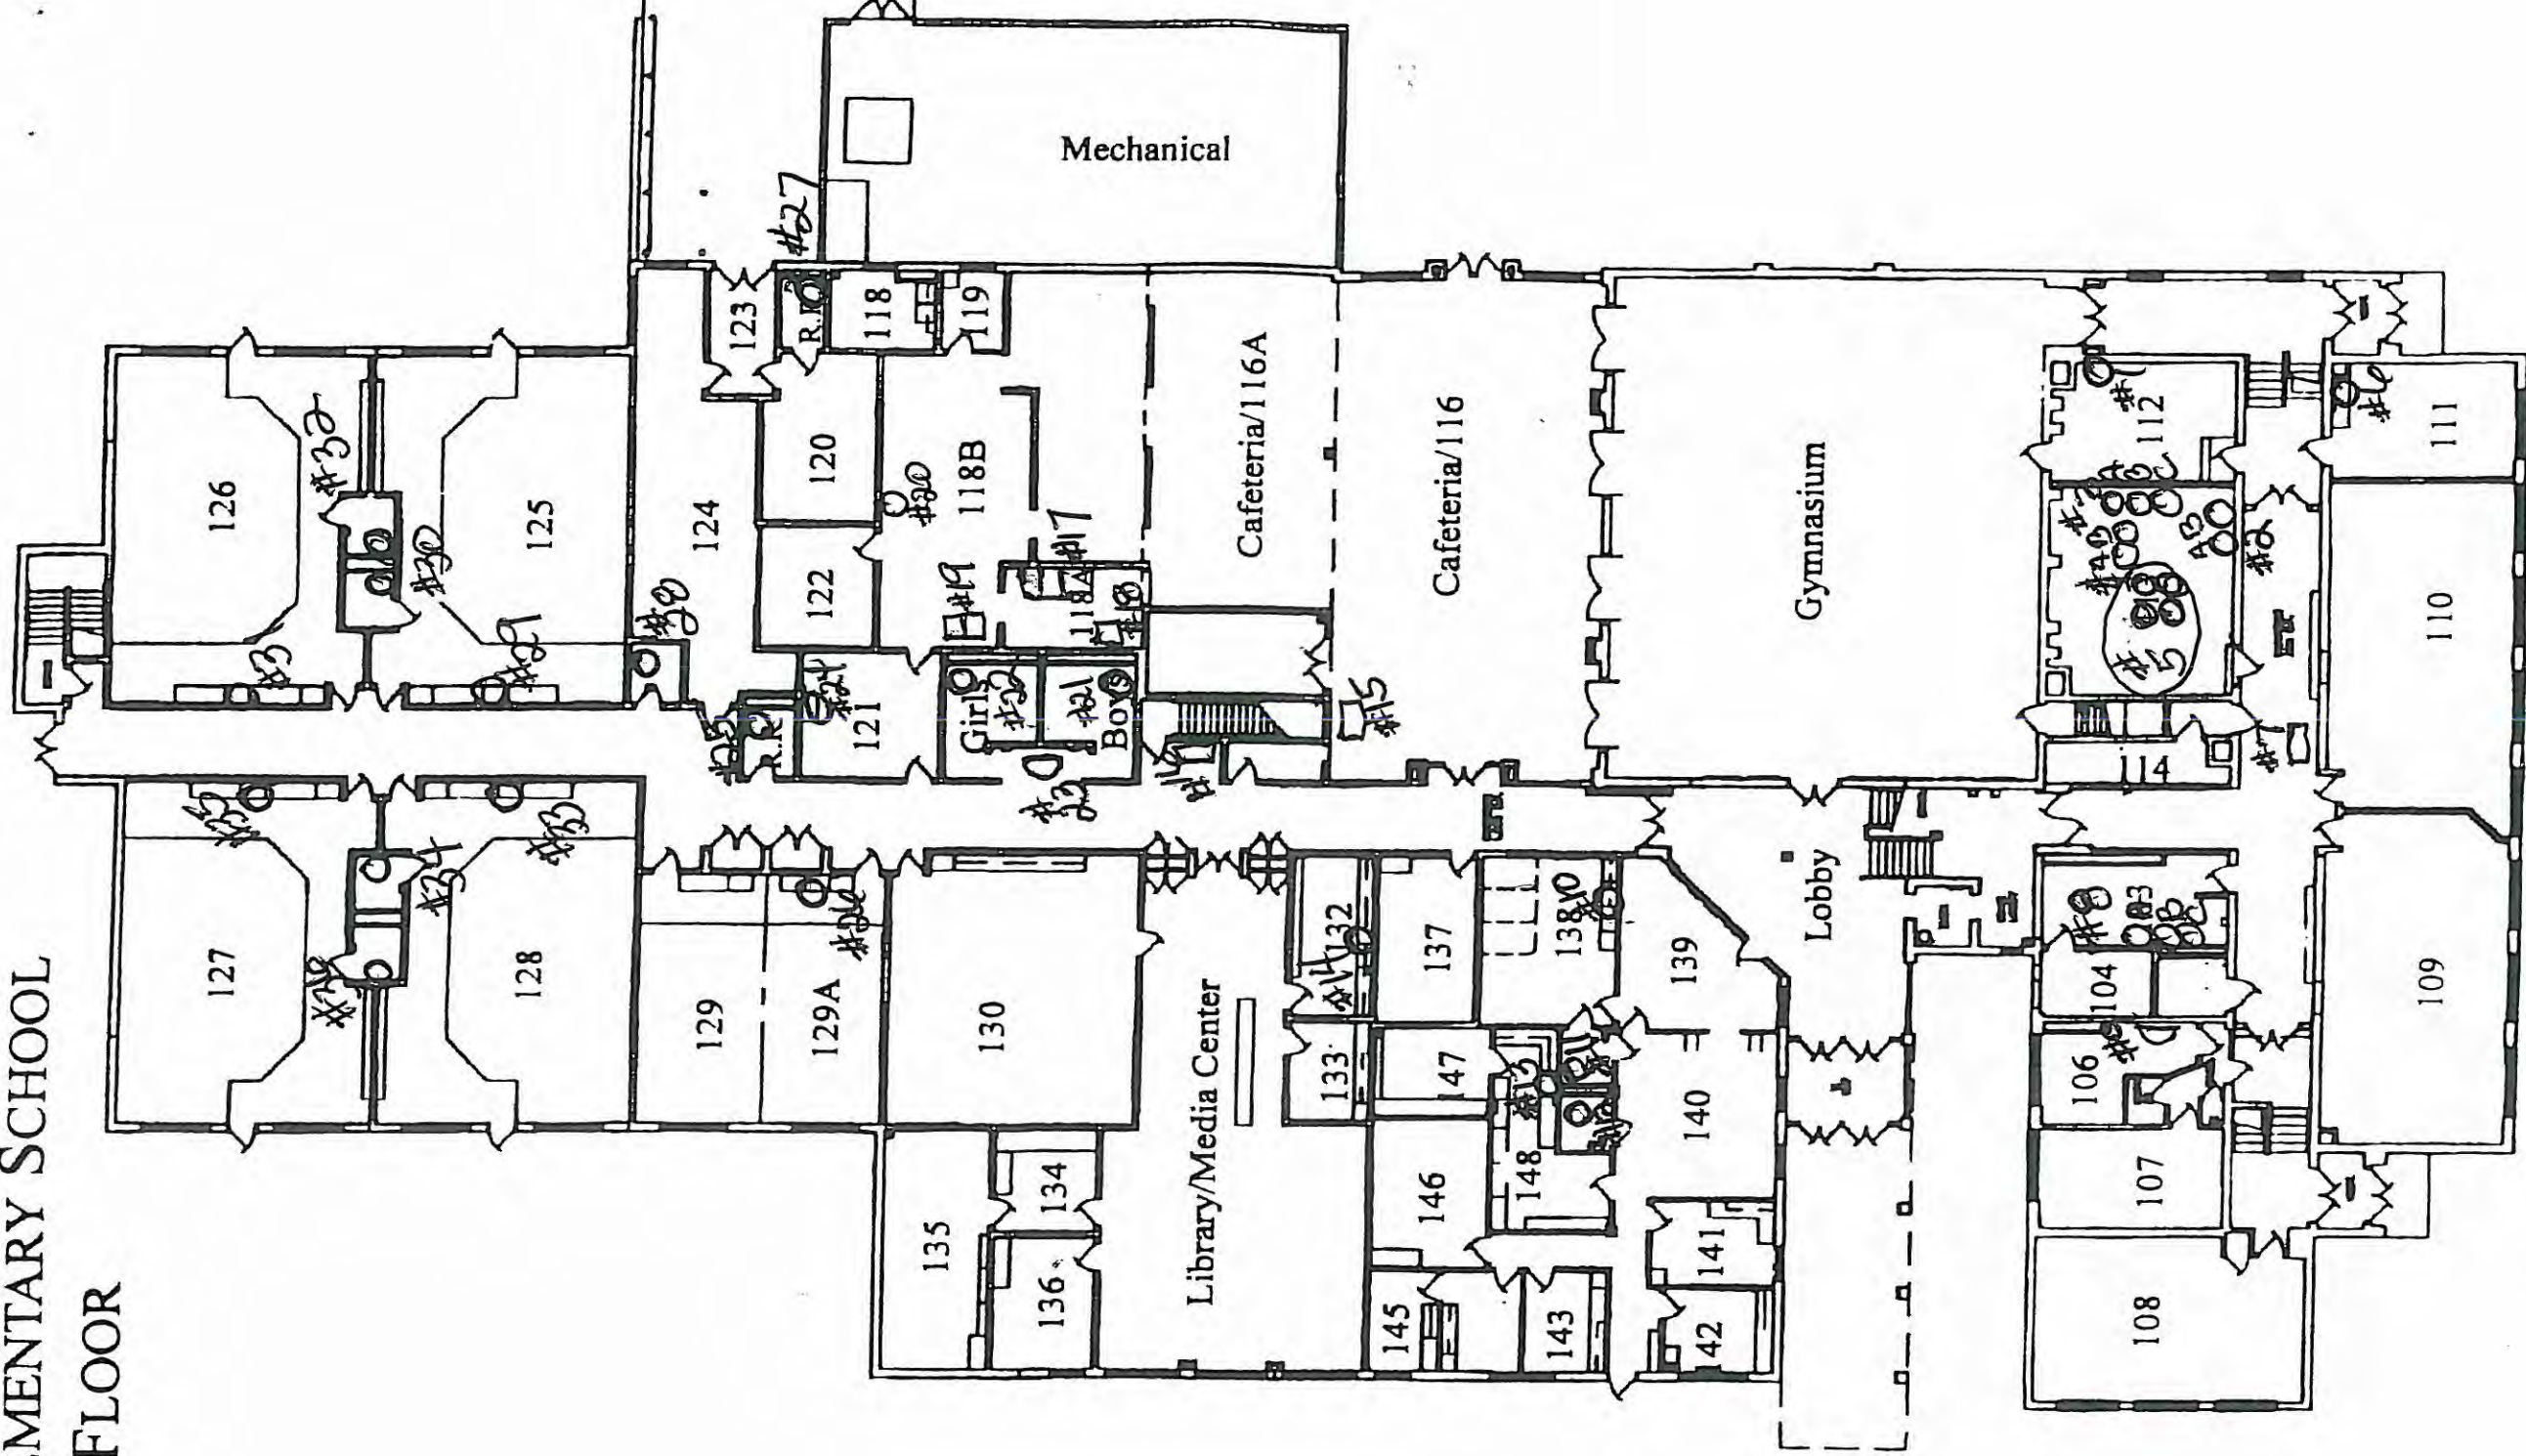


RECEIVED

MAR 06 2017

OHIO EPA NEDO

MAPLEWOOD ELEMENTARY
SECOND FLOOR

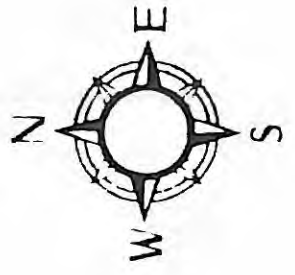
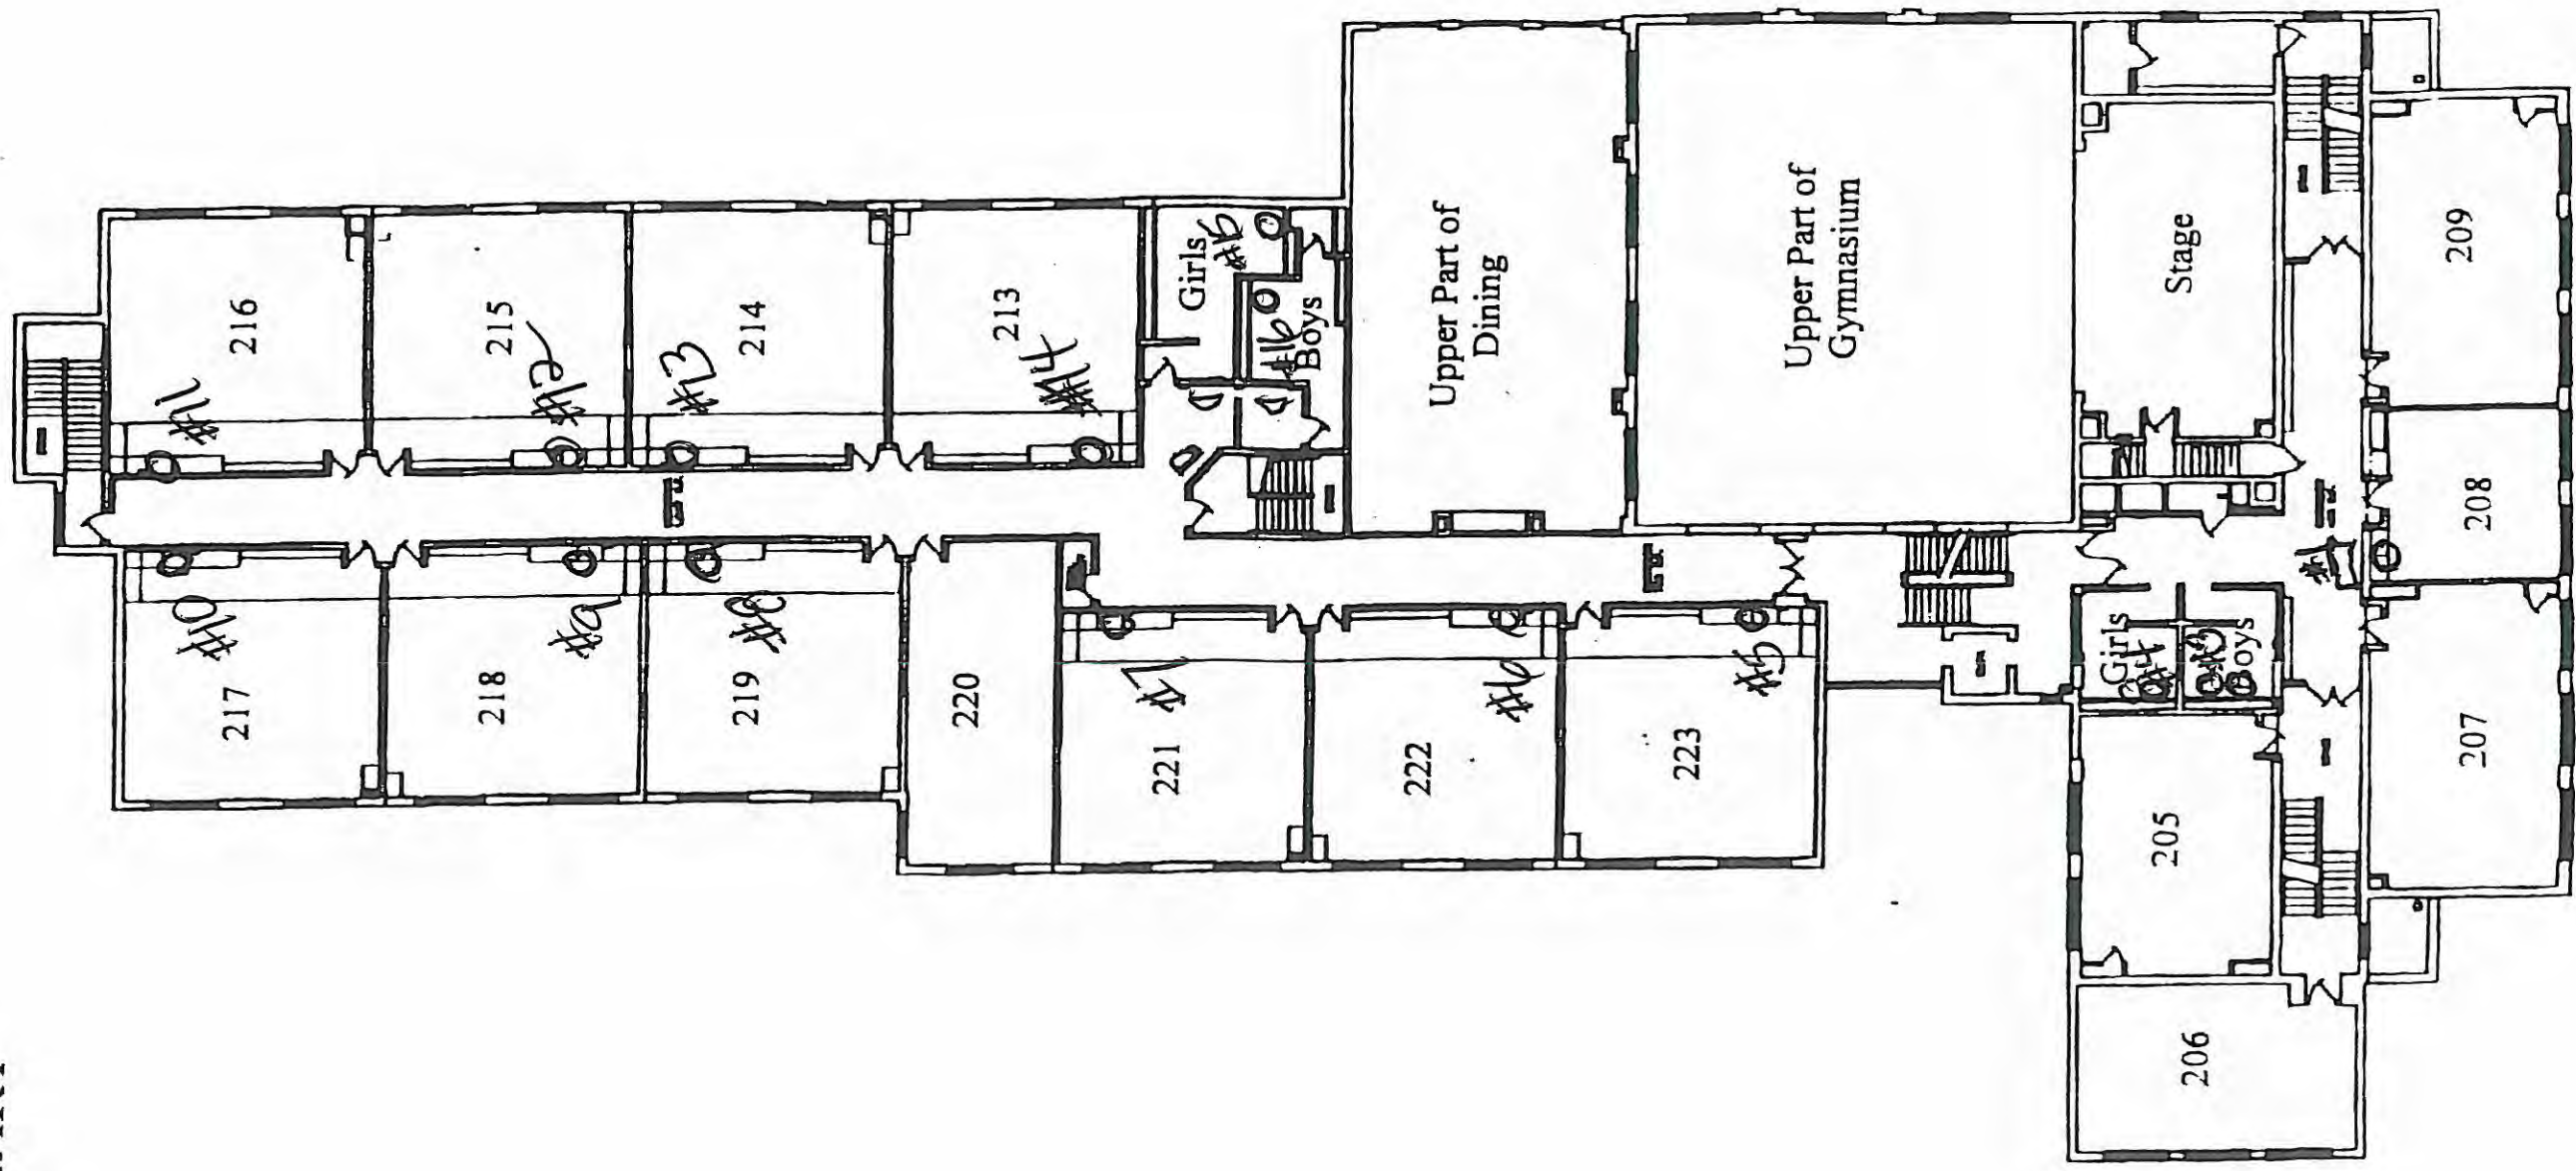


RECEIVED

MAR 06 2017

OHIO EPANEDO

MAPLEWOOD ELEMENTARY SCHOOL
THIRD FLOOR

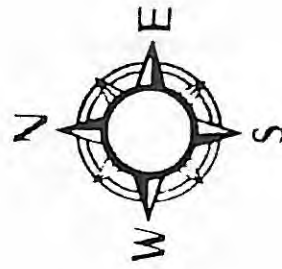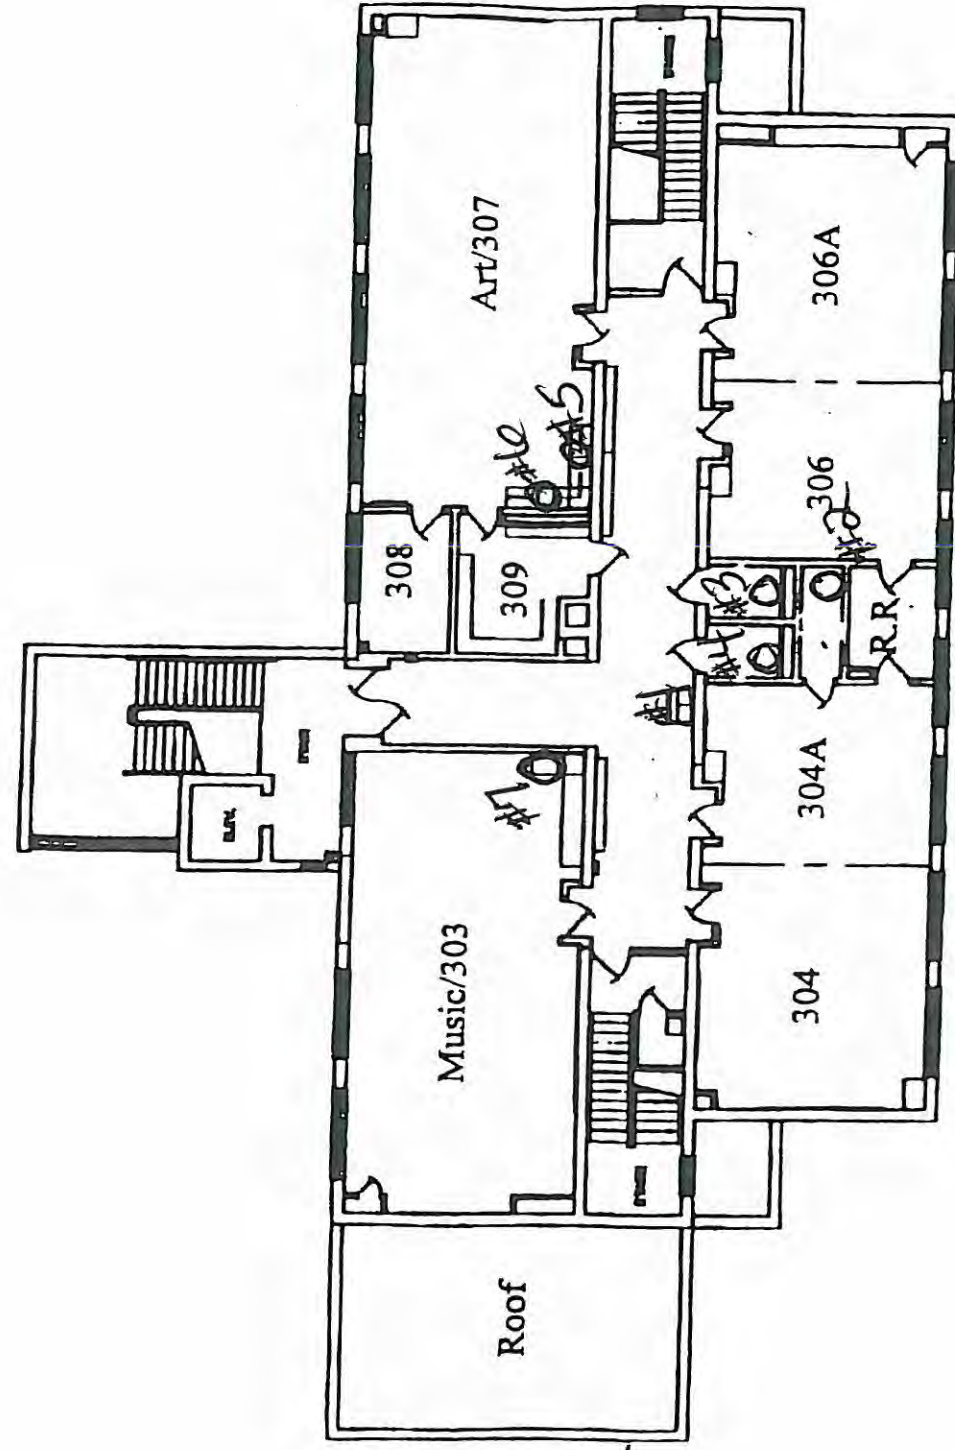

RECEIVED

MAR 06 2017

OHIO EPA NEDO