

MAPLEWOOD HIGH SCHOOL

2414 Greenville rd.
 Cortland, Ohio 44410
 Phone 330 637-8466
 PWS ID OH 7839512
 Facility ID 7859194

All service lines are copper after 1986
 New building addition and all water lines replaced
 in the old building finished in 2002

RECEIVED

MAR 06 2017


OHIO EPA NEDO

Entity: MAPLEWOOD HIGH SCHOOL
 Doc Type: REPORT
 Doc Subtype:
 Program: DRINKING WATER
 County: TUMBULL
 Secondary ID: OH 7839512


1	Entry from well PVC to cast iron into bldg to copper
2	water softners 2 tanks copper
3	pressure tanks 4 tanks copper to pvc to copper
4	retention tanks 3 tanks copper
5	7 sinks copper science labe 134
6	eye wash station copper science lab 134
7	sinks copper 2 rm 143
8	sinks copper 7 total science lab rm 145
9	sinks copper 6 total schience lab rm 144
10	eye wash station copper rm 144
11	eye wash station copper rm 145
12	sinks 3 total copper girls rest room
13	sinks 3 total copper boys rest room
14	drinking fountain copper hallway across from rm 127A
15	sink copper shop
16	sinks copper 2 art rm 124
17	sinks copper 1 dark room 122
18	sinks copper 1 rm 121 a
19	sinks copper 1 rest rom rm 121a & b
20	sinks copper 1 staff rest room
21	sinks copper 1 staff rest room
22	sinks copper 1 staff lounge
23	sinks copper 1 staff lounge
24	hand sink copper kitchen
25	2 compartment sink copper kitchen
26	3 compartment sink copper kitchen

27	drinking fountain copper auditorium
28	garbage disposal copper kitchen
29	dishwasher copper kitchen
30	sink copper kitchen rest room
31	sink 3 copper boys rest room
32	sink 3 copper girls rest room
33	drinking fountain copper hallway outside rm 152
34	sink copper office rest room
35	sink copperclinic rest room
36	sink copper clinic sink
37	sink copper officesink
38	sincs 2 copper boys rest room
39	sinks 3 copper girls rest room
40	sink copper staff rest room
41	sink copper library work room
42	drinking fountain copper gym hallway
43	drinking fountain copper girls rocker room
44	sink 2 copper girls locker room
45	sinks 2 copper boys locker room
46	drinking fountain copper gym hallway
47	drinking fountain copper fitnessroom
48	drinkingfountain copper gym south hall
49	sink coppermedical room
50	sinks 4 copper boys locker rom 183
51	sinks 4 copper girls locker rm 185
52	drinking fountain copper boys locker rm 183
53	drinking fountain copper girls locker rm 185
54	sink copper band work room 177

MAPLEWOOD HIGH SCHOOL

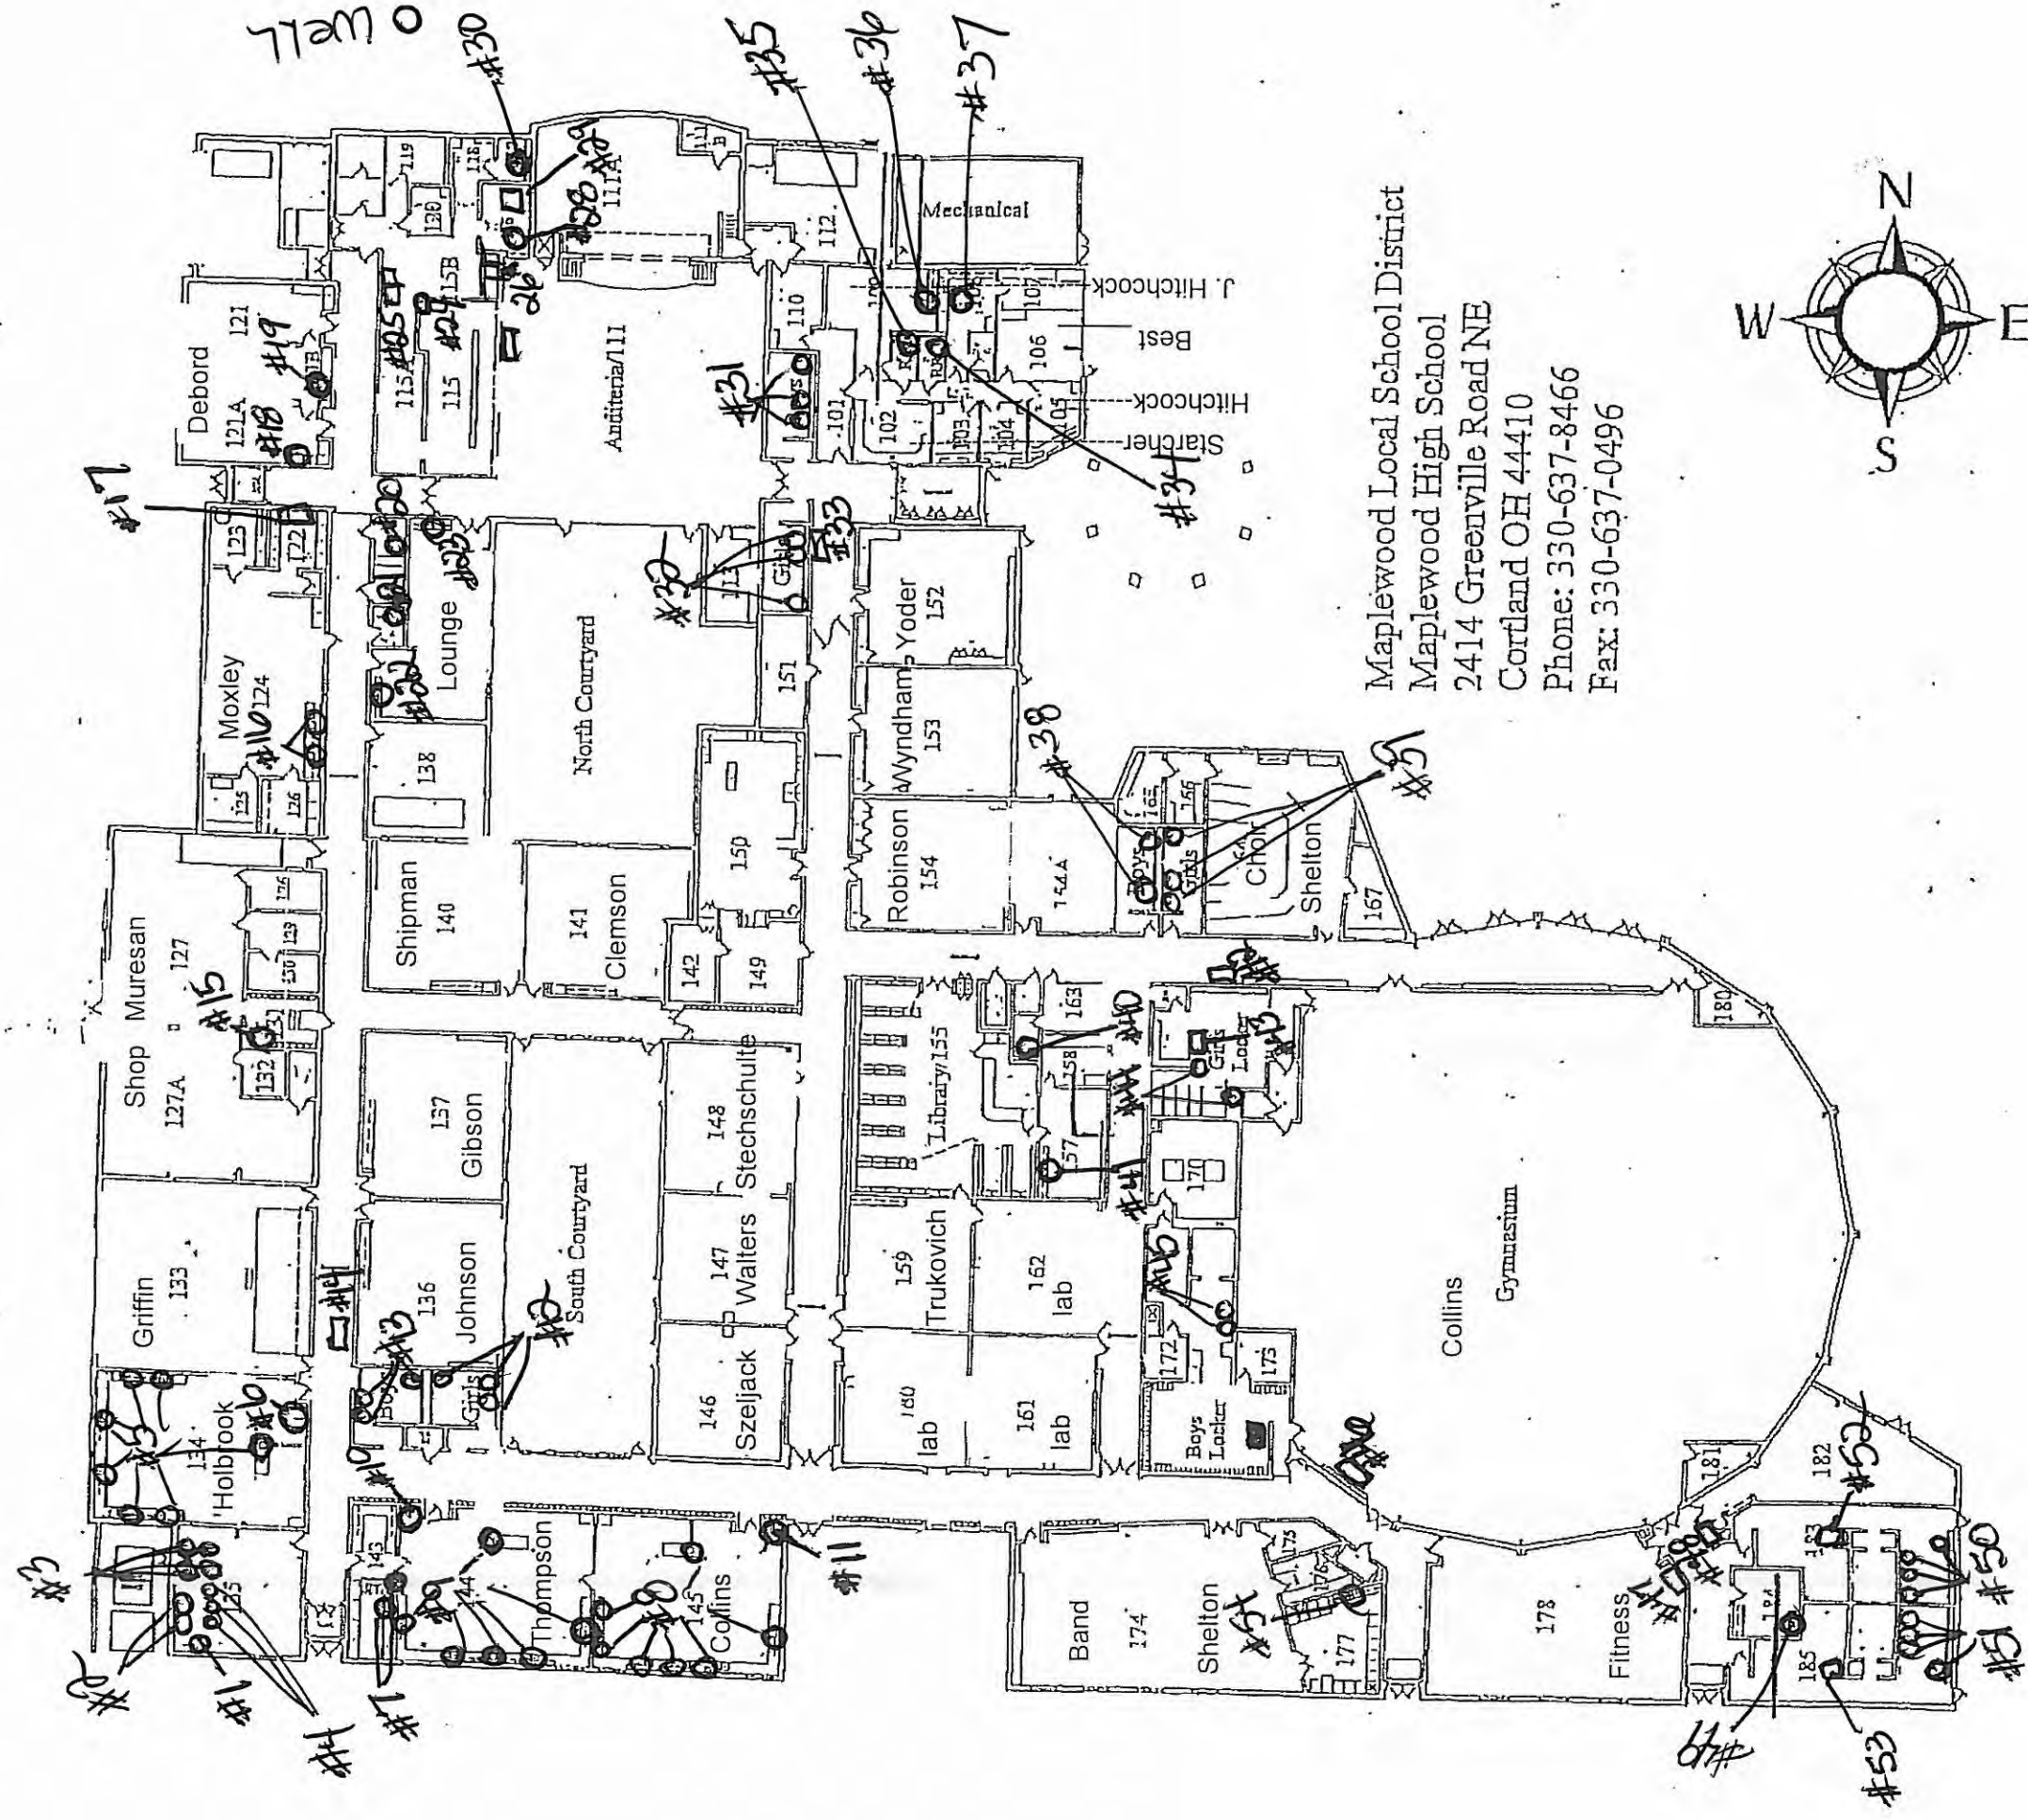

Maplewood Local School District
 Maplewood High School
 2414 Greenville Road NE
 Cortland OH 44410
 Phone: 330-637-8466
 Fax: 330-637-0496

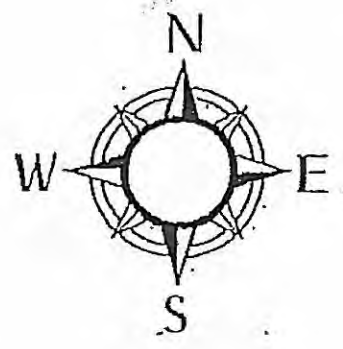

RECEIVED

MAR 06 2017

OHIO EPA NEDO