


all Lead Service Lines were Removed in the Projects in 1995-2000

LEAD Service Areas:


The Village of Windham has no known records of any lead pipe water service installations within its' system. This information is not a guarantee or promise and should not be relied upon as such.

Characters of Building "Areas" that may have lead piping, solder or plumbing fixtures: In 1956 (effective 1987) the Safe Water Drinking Act (SWDA) banned lead solder in excess of 0.2% lead for residential and human consumption and lead free pipes and fittings were defined as having no more than 8.0% lead. Residential and commercial buildings and areas constructed after 1987 are not as likely to contain lead piping and fixtures. Buildings constructed before 1988 are more likely to have higher exposure risk to lead. In 2011 SWDA, section 1417 amendment (effective 2014) banned lead in excess of 0.25% for commercial, industrial etc. building materials. Therefore, construction that followed is the least likely to have lead exposure

Information contained on this map is not intended to identify specific water services, homes and/or buildings, but rather is to identify general areas of potential for lead based exposure. This information is not intended as a guarantee or promise and should not be used or relied upon as such.

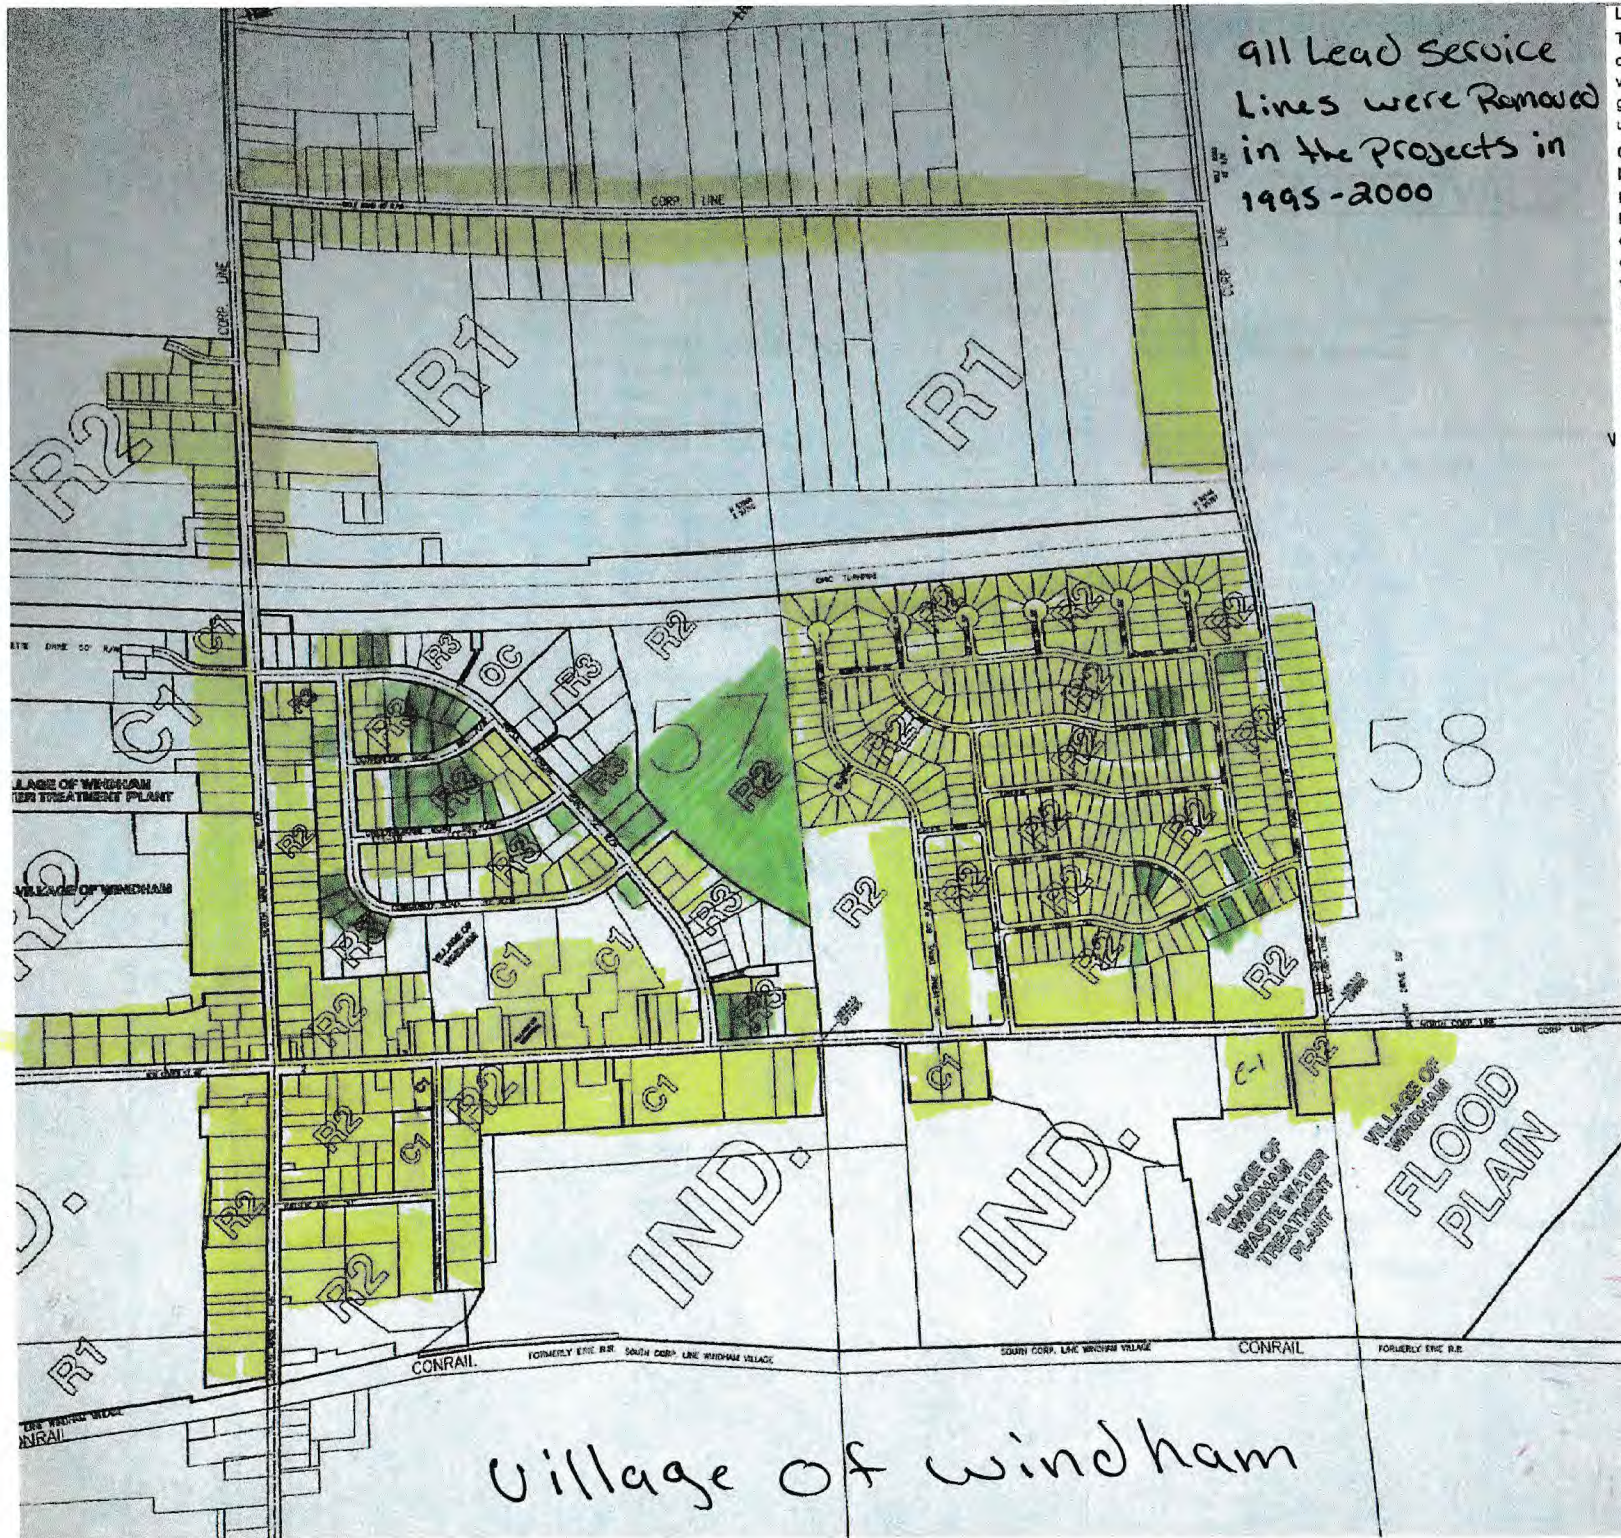

58

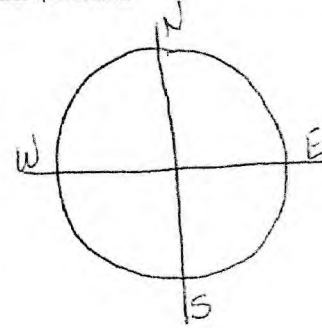

- Pre 1988 Building areas
- 1988-2014

Village of Windham


**VERIFICATION FORM FOR COMMUNITY PUBLIC WATER SYSTEMS
CLAIMING NO LEAD SERVICE LINES**

Systems must also submit a report to the director containing at least both of the following: (1) The applicable map with narrative, and (2) A list of sampling locations used to collect samples as required by Ohio Revised Code (ORC) Section 6109.121 and any rules adopted thereunder, including contact information for the owner and occupant of each sampling site.

Should a water system determine no lead service lines exist in their distribution system, they must provide information stating they reviewed, at the minimum, historical permit records and local ordinances, distribution maintenance records and information pertaining to installation dates or materials for all services lines. This information must be verified below.

I HEREBY CERTIFY THAT THE FOLLOWING METHOD(S) WERE USED TO DETERMINE NO LEAD SERVICE LINES EXIST IN THIS WATER SYSTEM'S DISTRIBUTION SYSTEM, AS REQUIRED BY ORC 6109.121(F):

LEAD SERVICE LINE VERIFICATION
<p>This PWS states they have no lead service lines and has reviewed the following information (select one or more of the following):</p> <ul style="list-style-type: none"><input type="checkbox"/> Historical permit records and/or local ordinances<input checked="" type="checkbox"/> Distribution maintenance records (i.e. meter replacement, waterline break repairs)<input type="checkbox"/> Information pertaining to installation dates for all service lines (i.e. after 1986 when lead services lines were banned)<input type="checkbox"/> Service line material of all service lines is known (i.e. all service lines are known to be PVC)

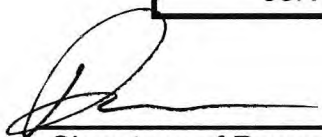

Signature of Responsible Person Date 3/8/17

Ryan S Wagner

Printed Name and Title of Responsible Person

PWS NAME: Village of Windham
PWS ID: OH 6784812
COUNTY: Portage

<p>For Ohio EPA use only:</p> <p>Date Verification Rec'd: _____</p>
--