


NORTH ↑

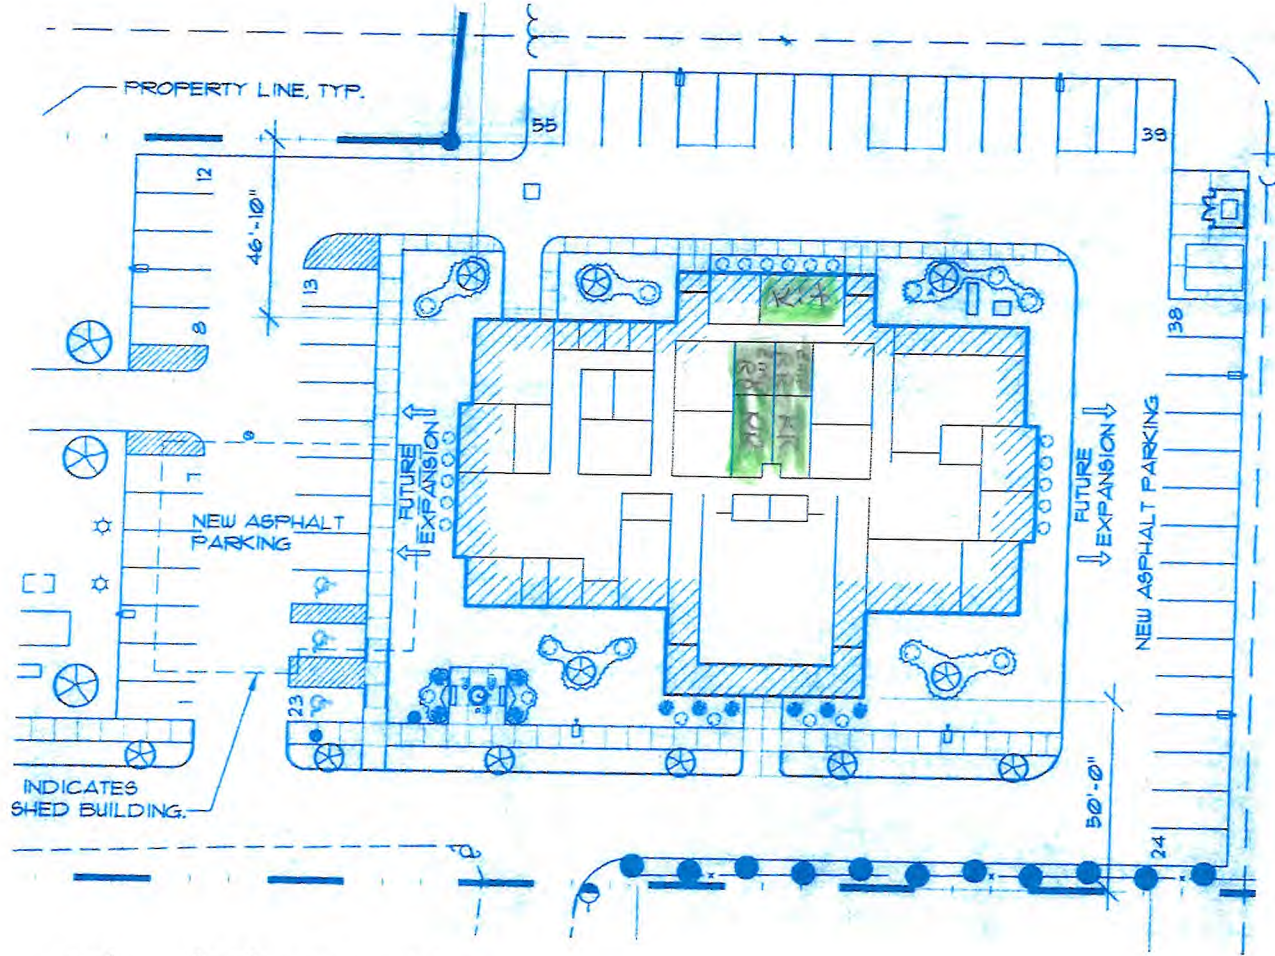

Facility Built 2004  
Copper plumbing  
Sampling site terr 2

Sampling Sites ██████████

Facility has no  
lead service lines  
line from well is copper  
fixtures with brass  
content.

City of New Franklin  
Administration Bldg  
5611 Manchester Rd  
New Franklin, Ohio 44319  
PWS: 7700036  
ORC Denny White 330-607-4659