


Rt ↑ 303

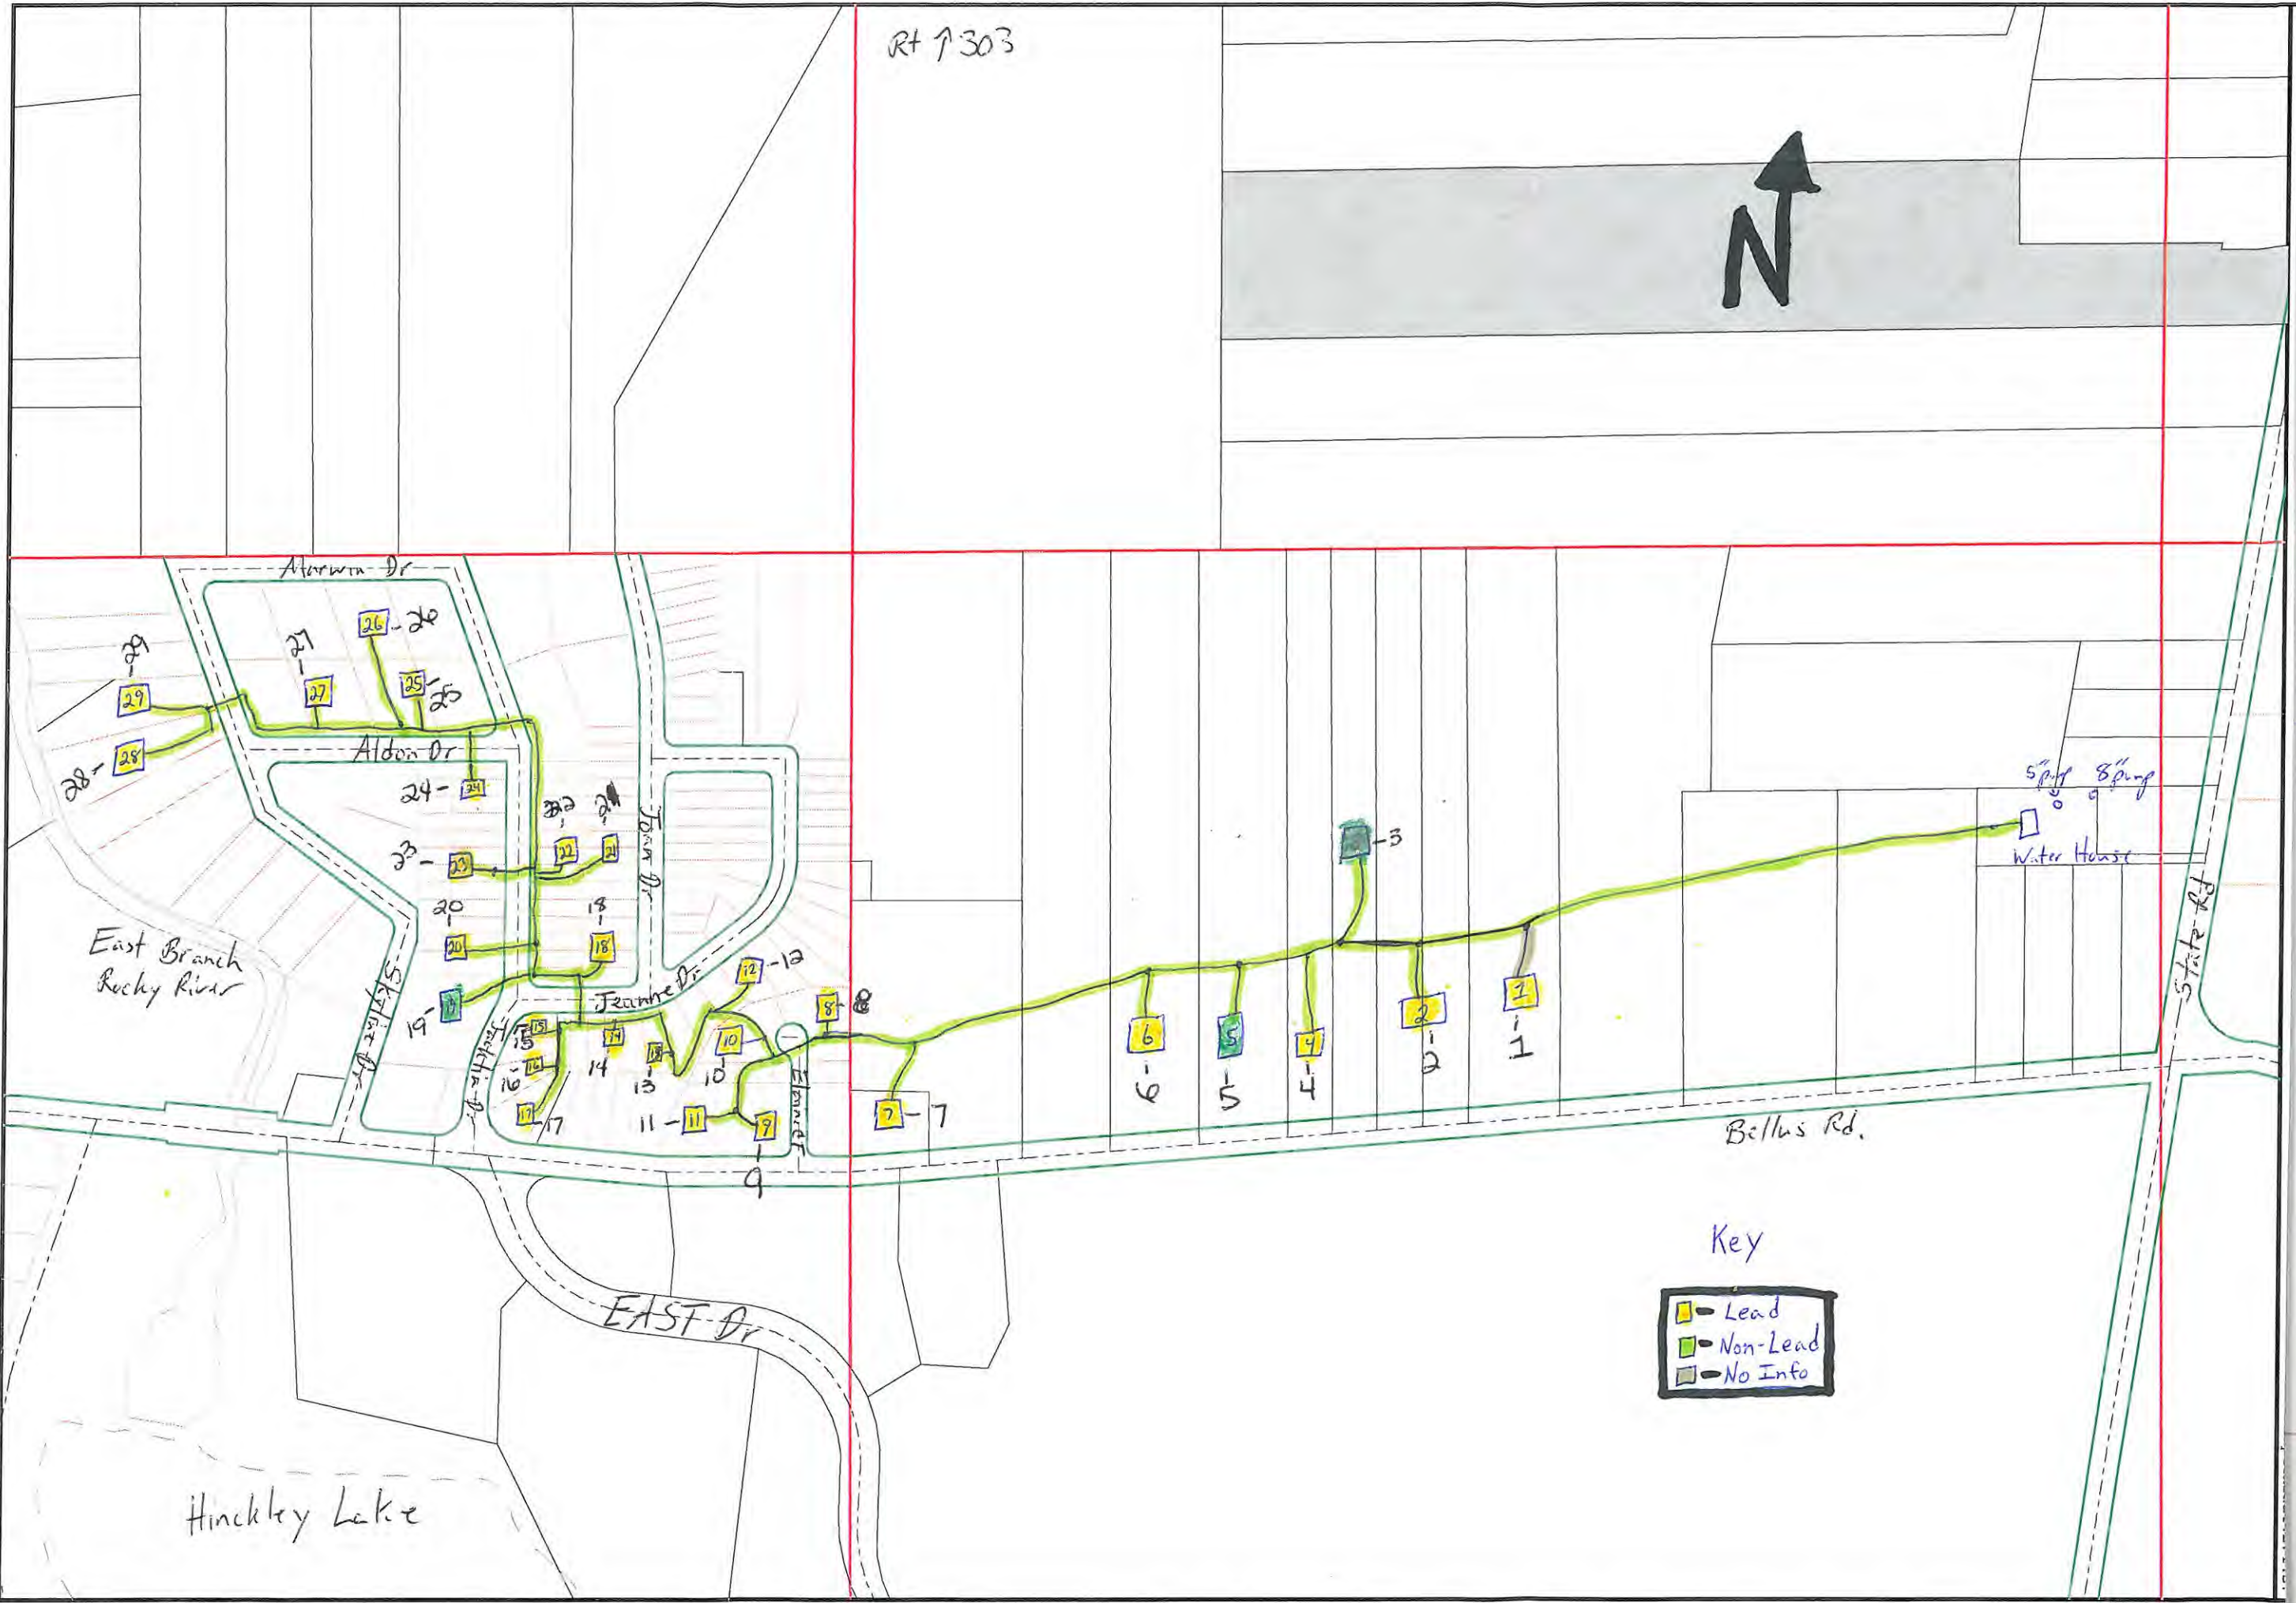

East Branch Rocky River

Water House

Bellus Rd.

EAST DR

Hinckley Lake

Key

Yellow box	Lead
Green box	Non-Lead
Grey box	No Info