


Bazetta/Champion OH7804303



1998-2014 2014-Present WATER LINE

1,800 900 0 1,800 Feet

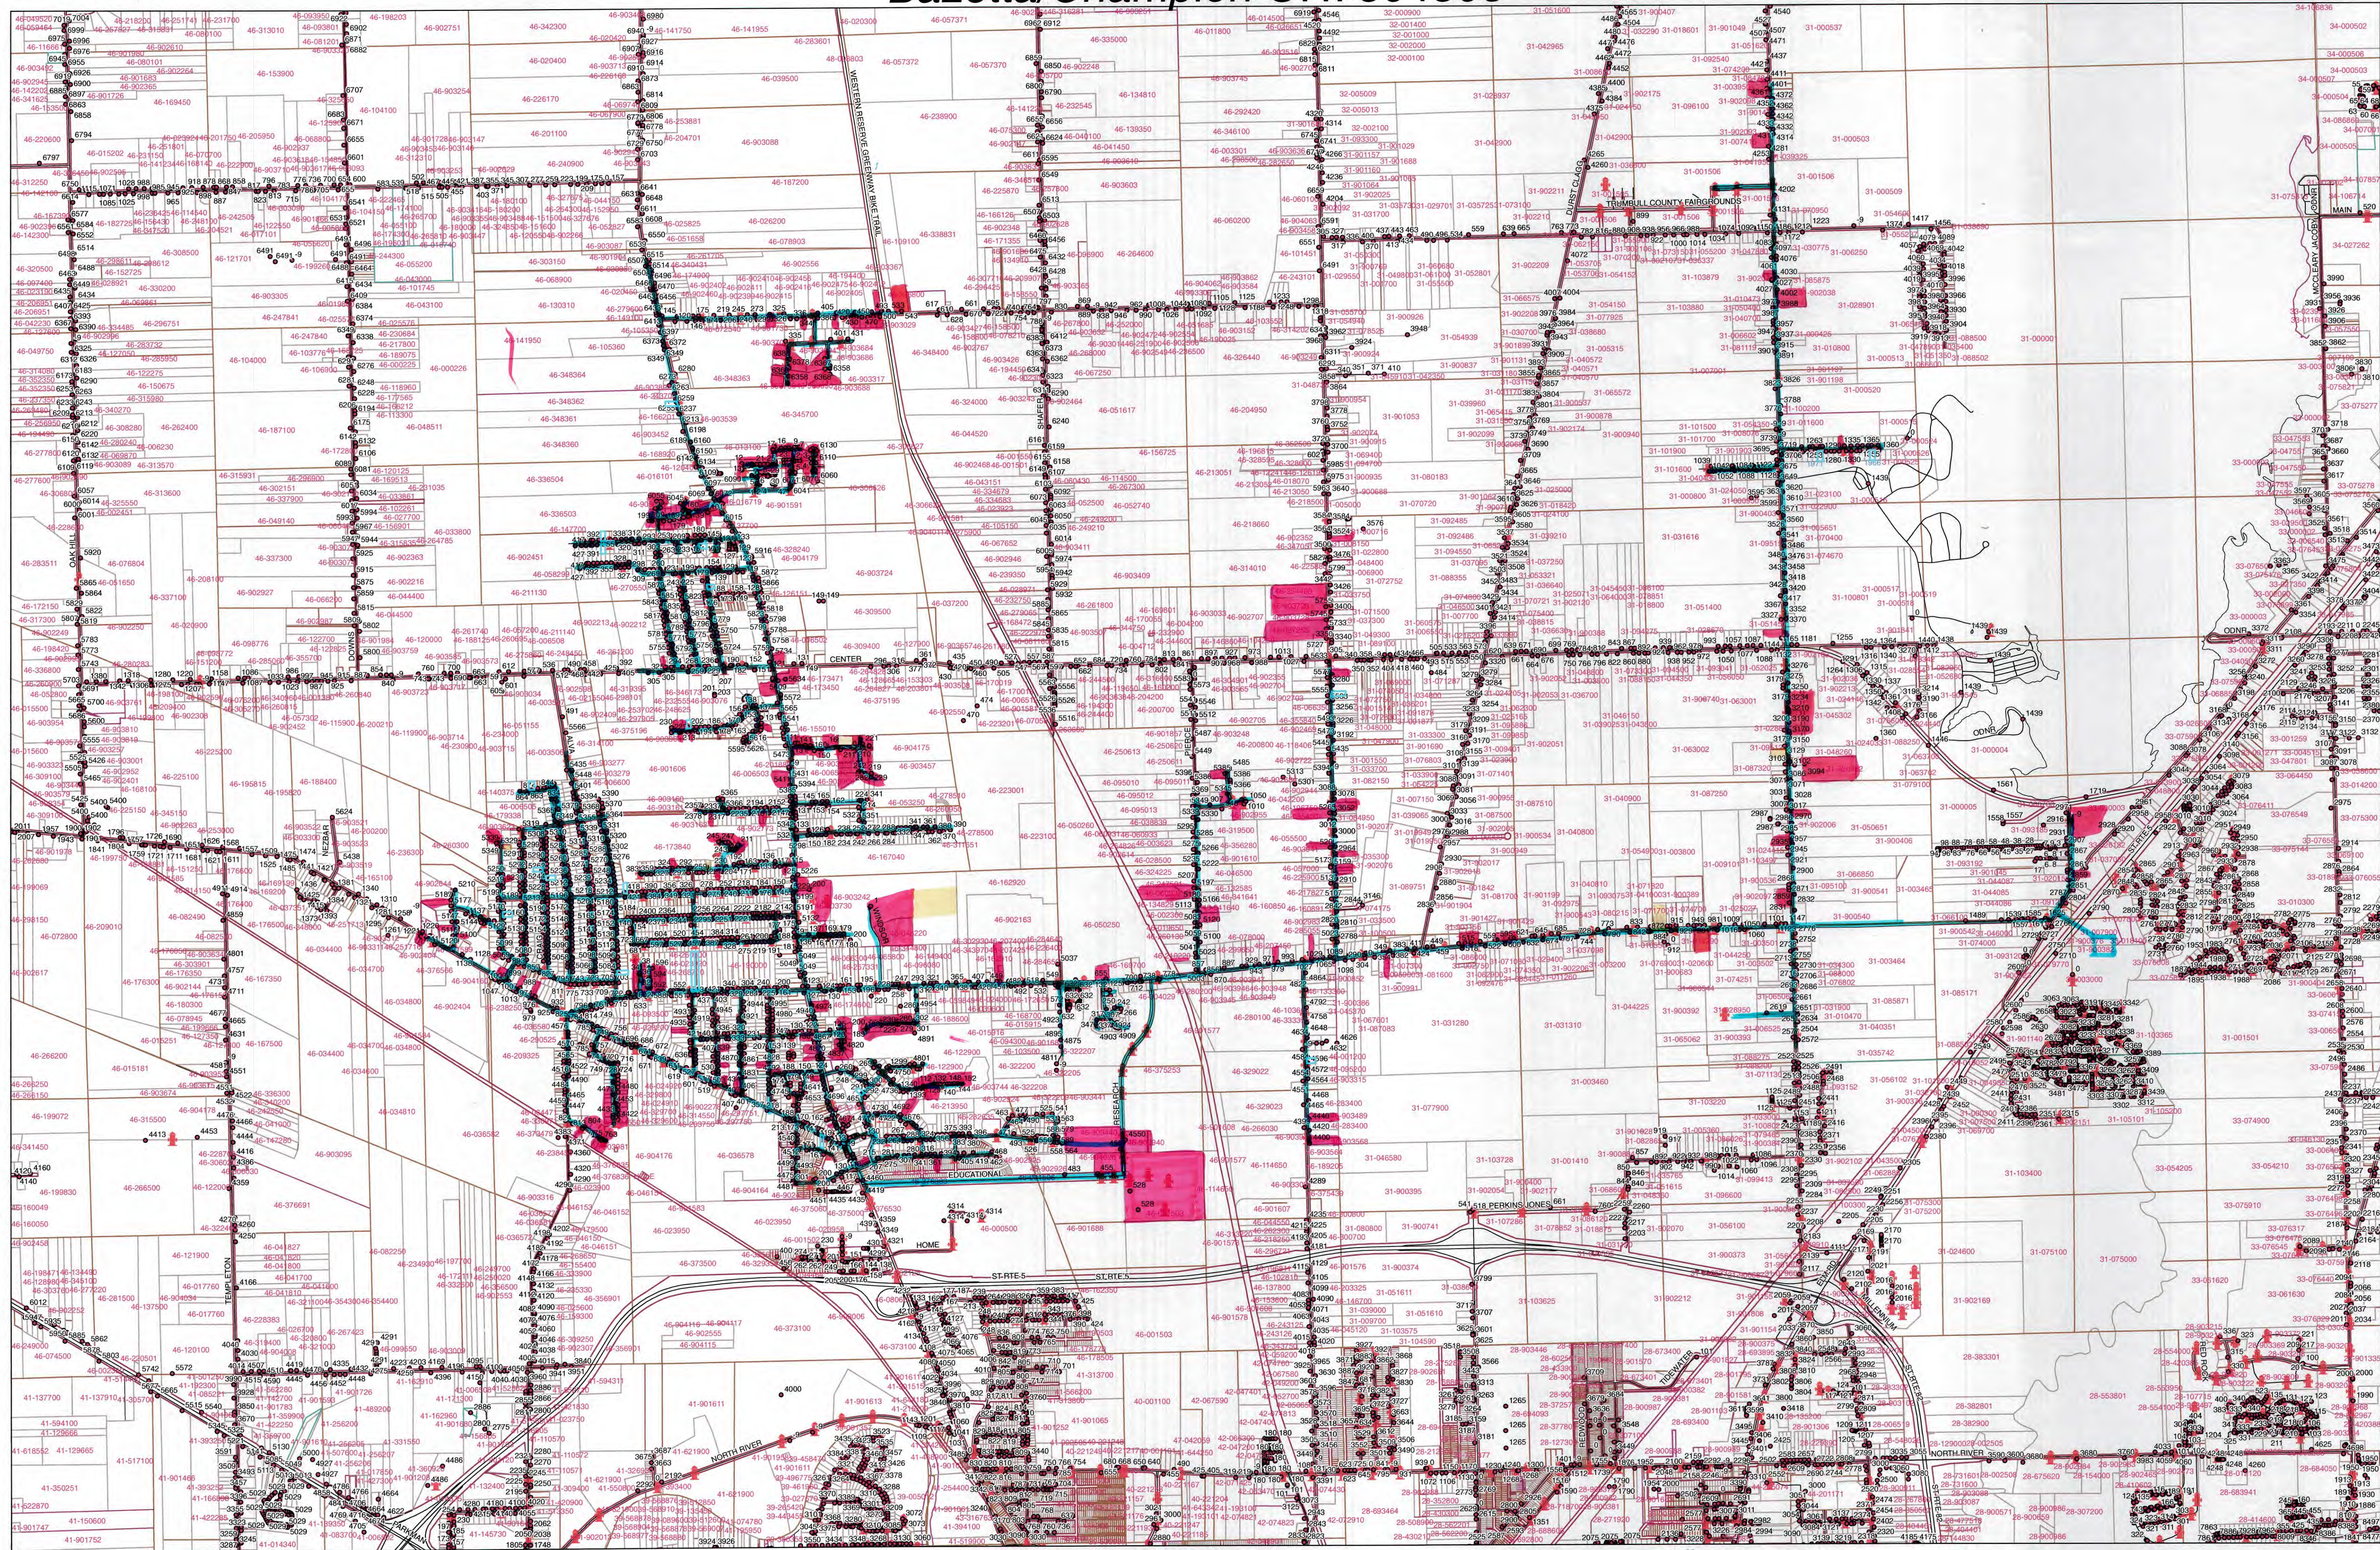

Bazetta/Champion PWS OH7804303

According to field personnel, no known lead service lines are in this system.

Age of homes were determined by the Trumbull County Auditors Web Site.

Bazetta/Champion Water District consists of 3086 service connections as of February 2017.

Customers in this district, not colored with pink or yellow highlighter, are pre 1998

Water lines for this district have been marked with blue highlighter.

Sample sites are outlined in blue ink.