

Water
 To wall
 wall
 f...


Entry: CRS Rep
 Doc Type: Report
 Doc Subtype: ADP&W
 Program: ADP&W
 County: ADP&W
 Secondary ID: 013850813

RECEIVED

MAR 08 2017

OHIO EPA NEDO

EMERGENCY EVACUATION PLAN

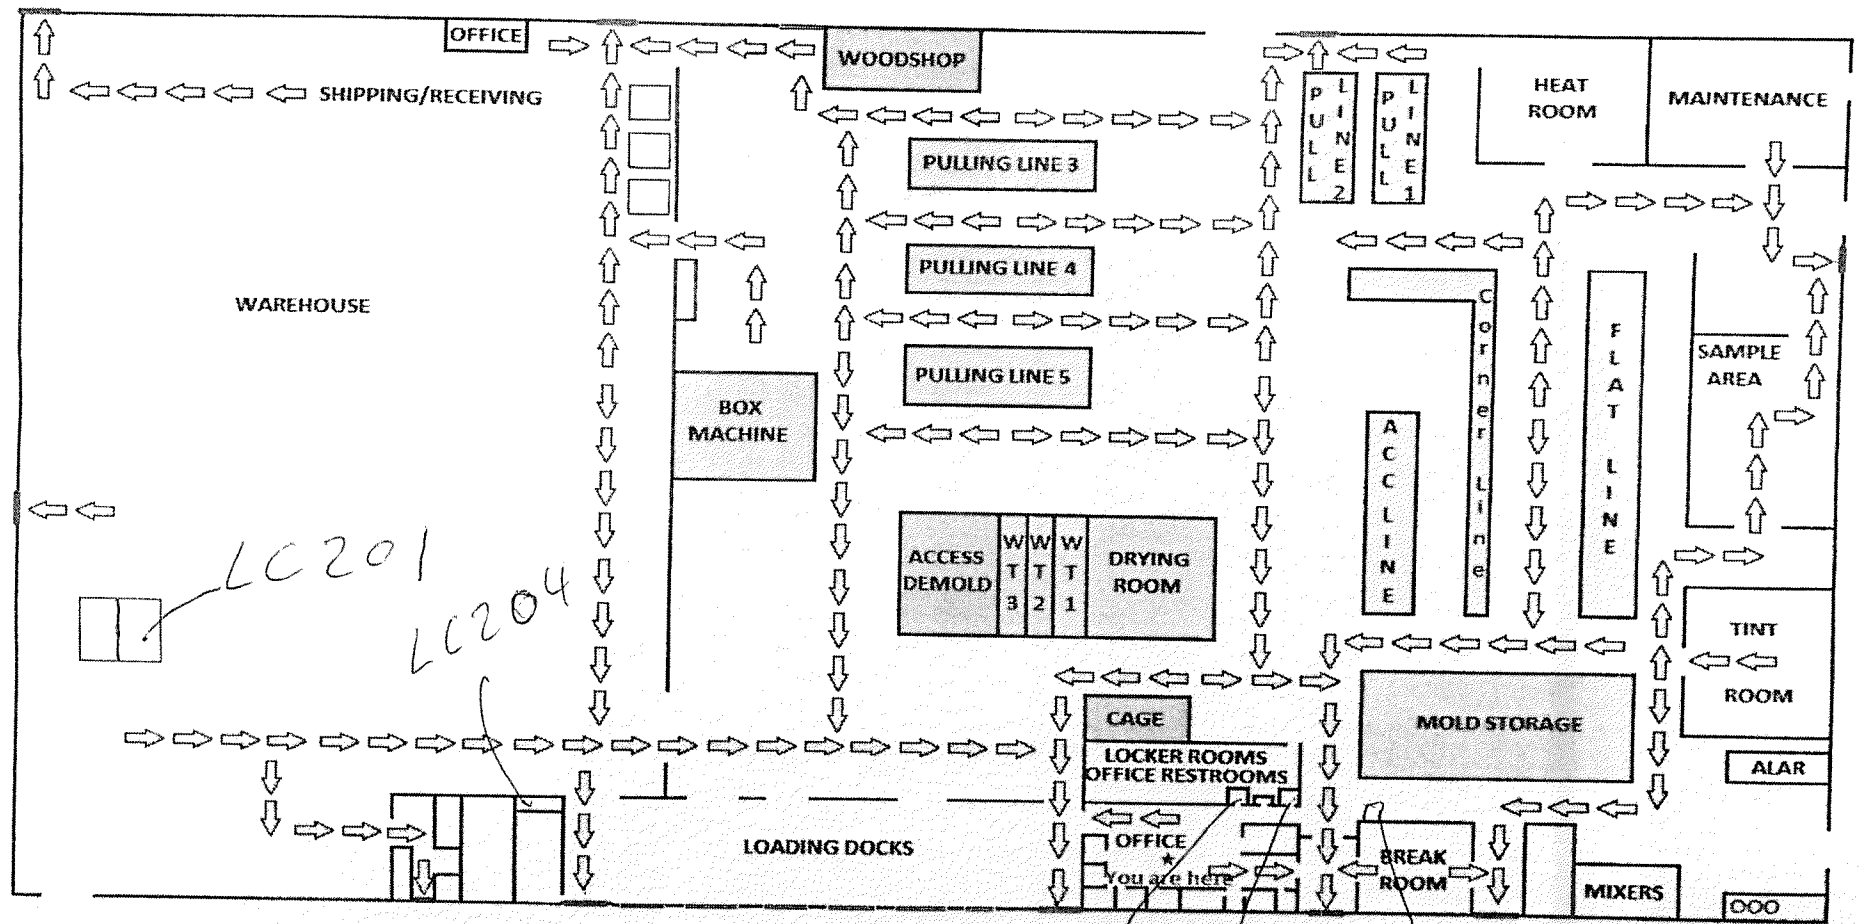

Emergency Exit



LC201
 LC204
 LC202
 LC203
 LC205