

Portage Private Industry Council
PWS ID: OH6779512

RECEIVED

MAR 06 2017

OHIO EPA NEDO

1. Building address: 4833 Harding Avenue, Ravenna, Ohio 44266.
2. Phone number (administrative office): (330)297-7795.

3. Phone number (building location): (330) 297-1662.

4. Building is a single story wood structure.

5. Water service entrance point to building material is copper.

6. Water line from well to building is PVC.

7. Layout of hot and cold water lines is color coded green and lines run side by side.

- A. Solid green lines show ceiling mount and interior walls water line runs.
- Broken green lines show under floor water line runs.

8. Type of service lines and solder


- A. Service lines: domestic water type "L" hard copper.
- B. Fittings for copper pipe: wrought copper solder joint type with 95-5 solder.

9. Fixture types are all new and lead free.

10. Building renovated in 2008 – 2009. Almost all of the plumbing was replaced during the renovation, Architect spec sheet is enclosed for plumbing work to be completed during renovation. All materials used during the renovation should have been "lead free". All service lines were installed after the 1986 lead service line ban.

11. Certificate of Occupancy from Office of the Building Official Portage County, Ohio. Certificate was issued after 2008-2009 renovation.

Entity: PORTAGE PRIVATE INDUSTRIAL COUNCIL
Doc Type: REPORT
Doc Subtype:
Program: DRINKING WATER
County: PORTAGE
Secondary ID: 0A6779512

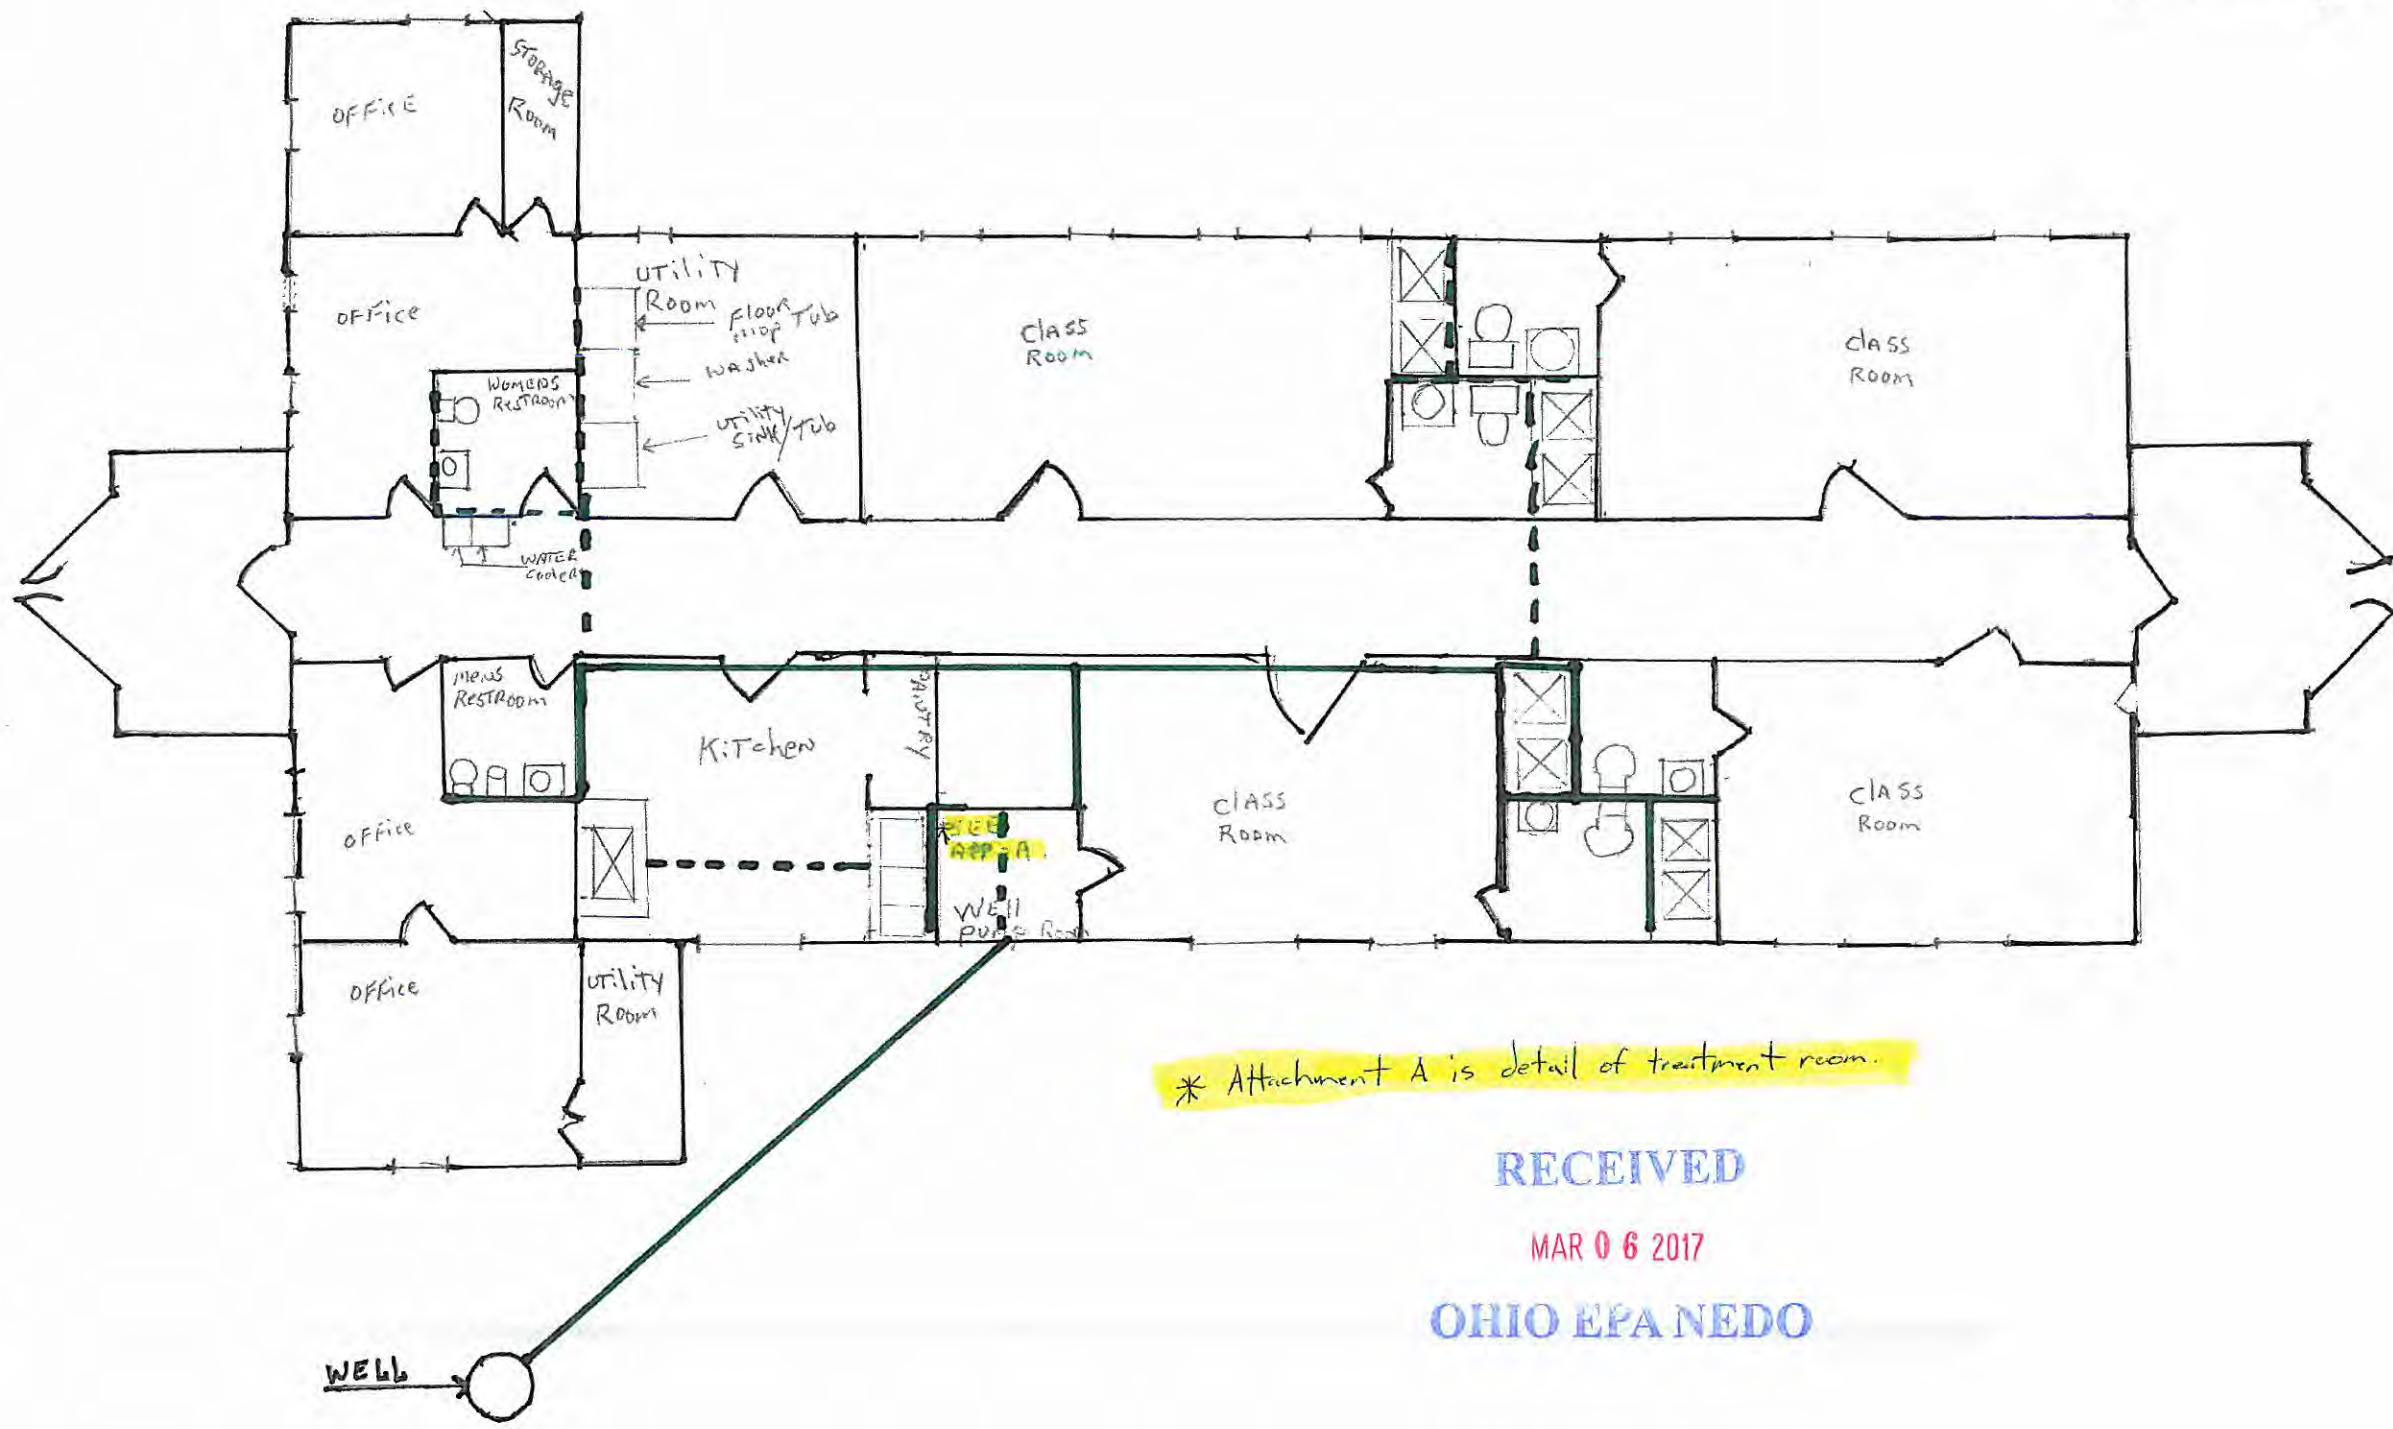


RECEIVED

MAR 06 2017

OHIO EPA NEDO

TREATMENT ROOM LAYOUT SHEET

PT PRESSURE TANK
S SOFTNER
WT WATER TANK
W WELL

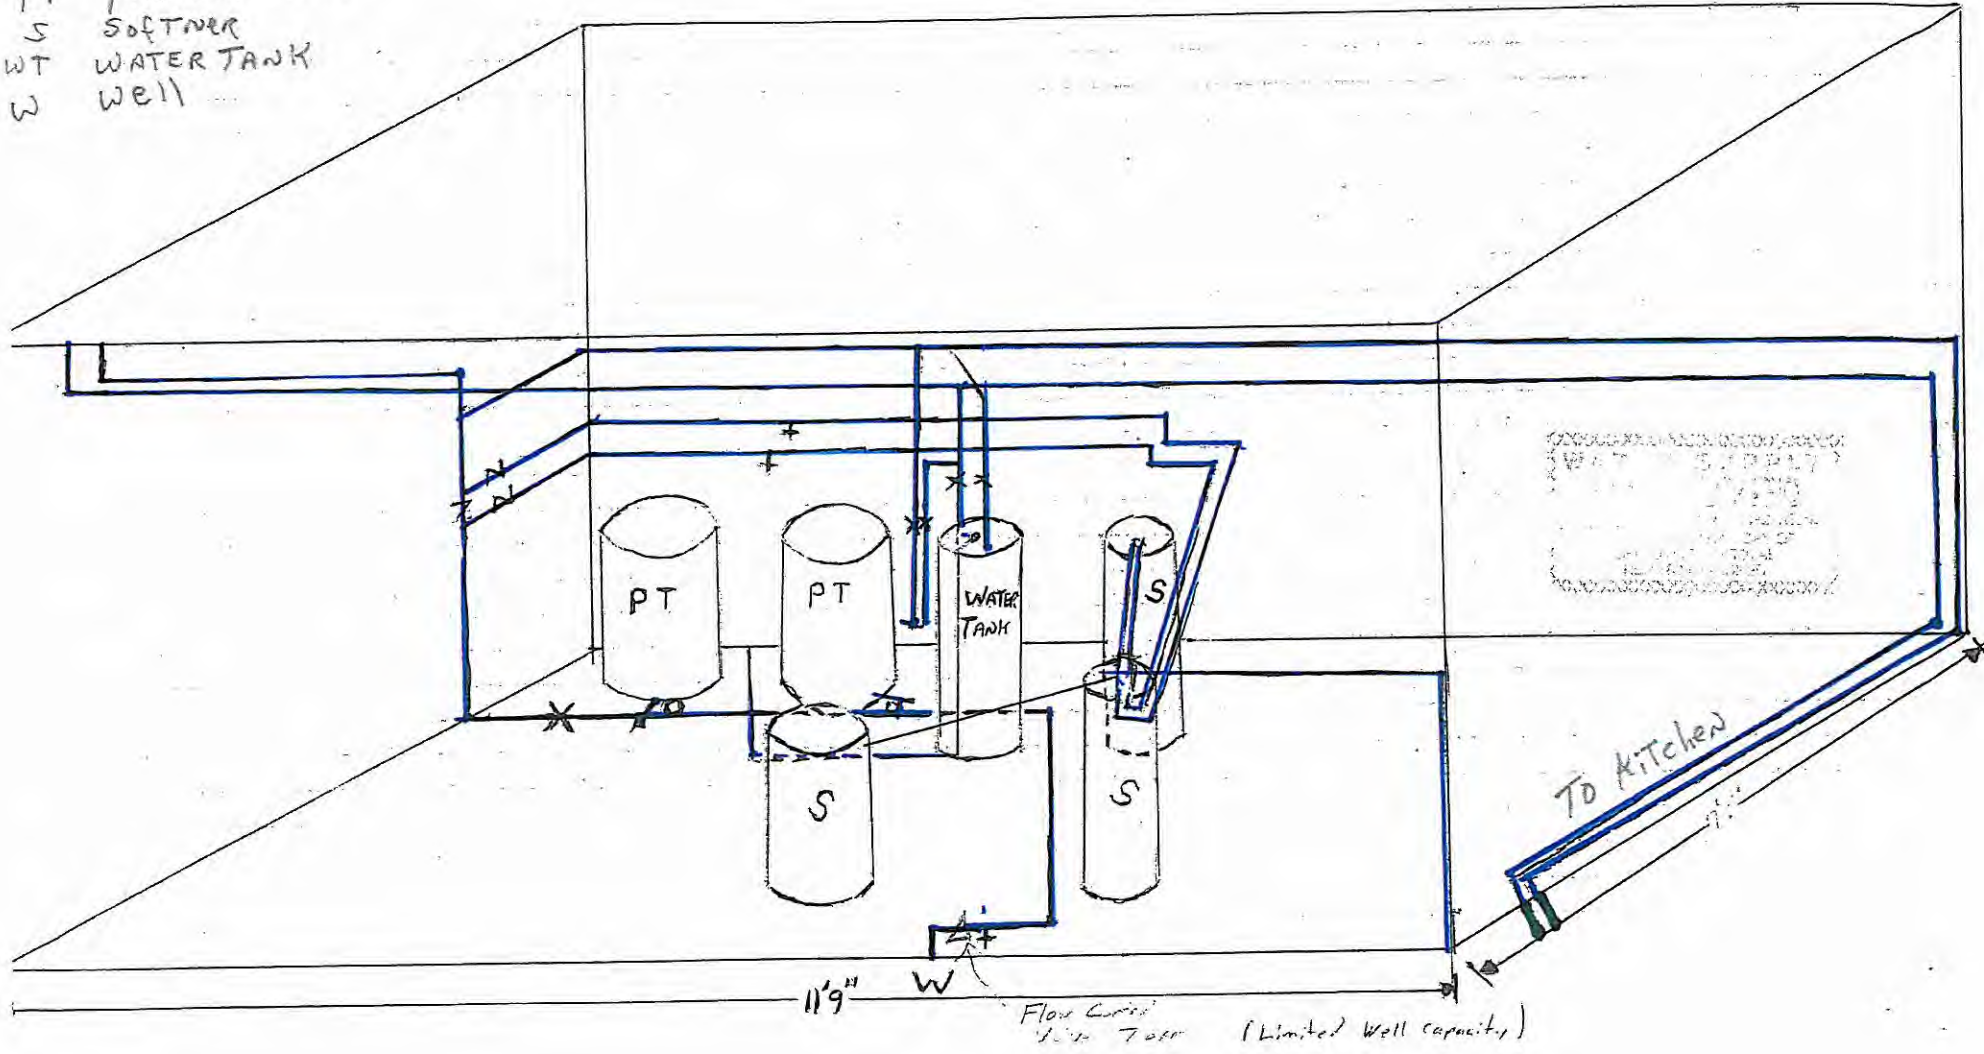

Attachment A

4-32

Certificate of Occupancy
Office of the Building Official
Portage County Ohio



Property Address: 4833 Harding Avenue, Ravenna Township

Approved as: Addition and Alterations

Use Groups: Primary: Day-Care Accessory: Office Mixed Uses: B/E Nonseparated

Occupancy Description: Head Start Preschool Area: 5294 S. F.

Construction Type: 5B Occupancy Load: Business 7 -- Day care 77 -- Mech. 2 = Total 96

Fire Suppression System: Not Required Existing System: No

Fire Alarm System: Yes

Storage Height: _____ Aisle Width: _____

Sprinkler System Demand @ base of riser: _____

Standpipe System Demand @ base of riser: _____

System Location: _____

Stipulations, Conditions, Variances: None

This Certificate represents an approval that is valid only when the building and its facilities are used as stated and is conditional upon all building systems being maintained and tested in accordance with the approval. This certifies conformance with Chapters 3781. and 3791. of the Revised Code and the applicable provisions of the rules of the Ohio Board of Building Standards.

Plan Approval Number: 208000056

Approved pursuant to: OBC 2007 NEC 2008 IECC 2006

Every room or space that is assembly occupancy shall have the occupant load posted in a conspicuous place, near the main exit or exit access doorway from the room or space. Posted signs shall be of legible permanent design and shall be maintained by the owner.

Building Official: _____

[Signature]

Date: 2-9-09