


Western Reserve

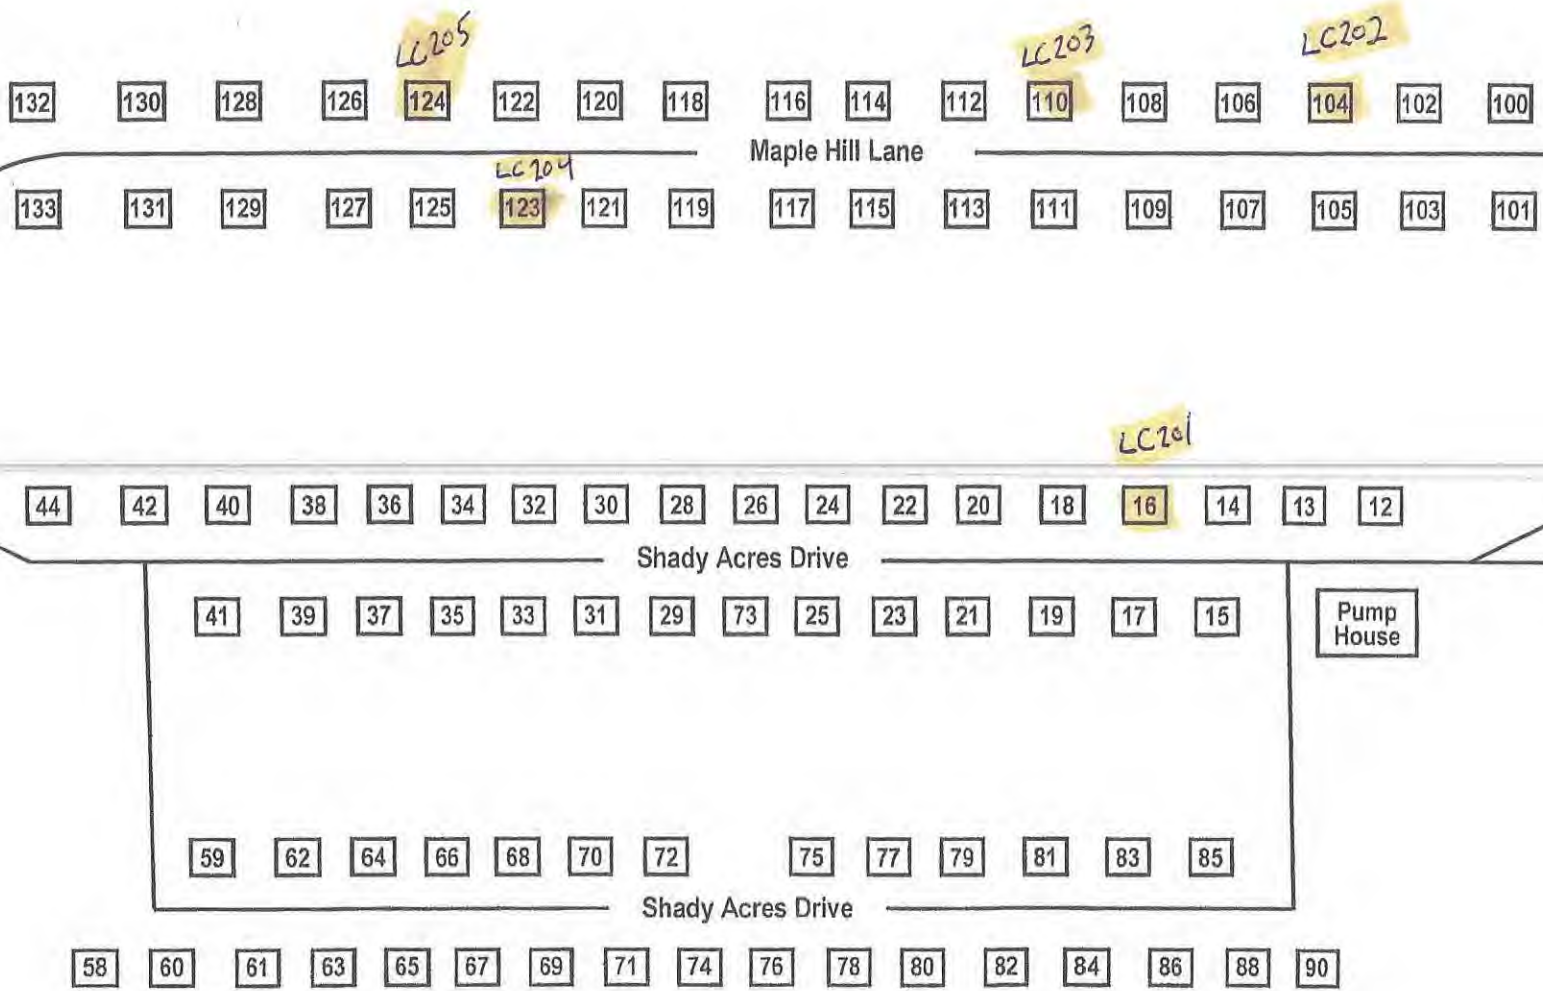

A
L
B
R
E
C
H
T