




## The Village of Shawnee

Here in the Village of Shawnee our system was replaced about 2000. The Superior fibers factory is shut down and is full of copper lines. Almost every building in town was constructed around the turn of the century - (1900). From what I have learned in my short time working here, there is a lot of copper and galvanized service lines still feeding the homes and business'. All service lines were replaced with  $\frac{3}{4}$ " CTS from the main to the meters.

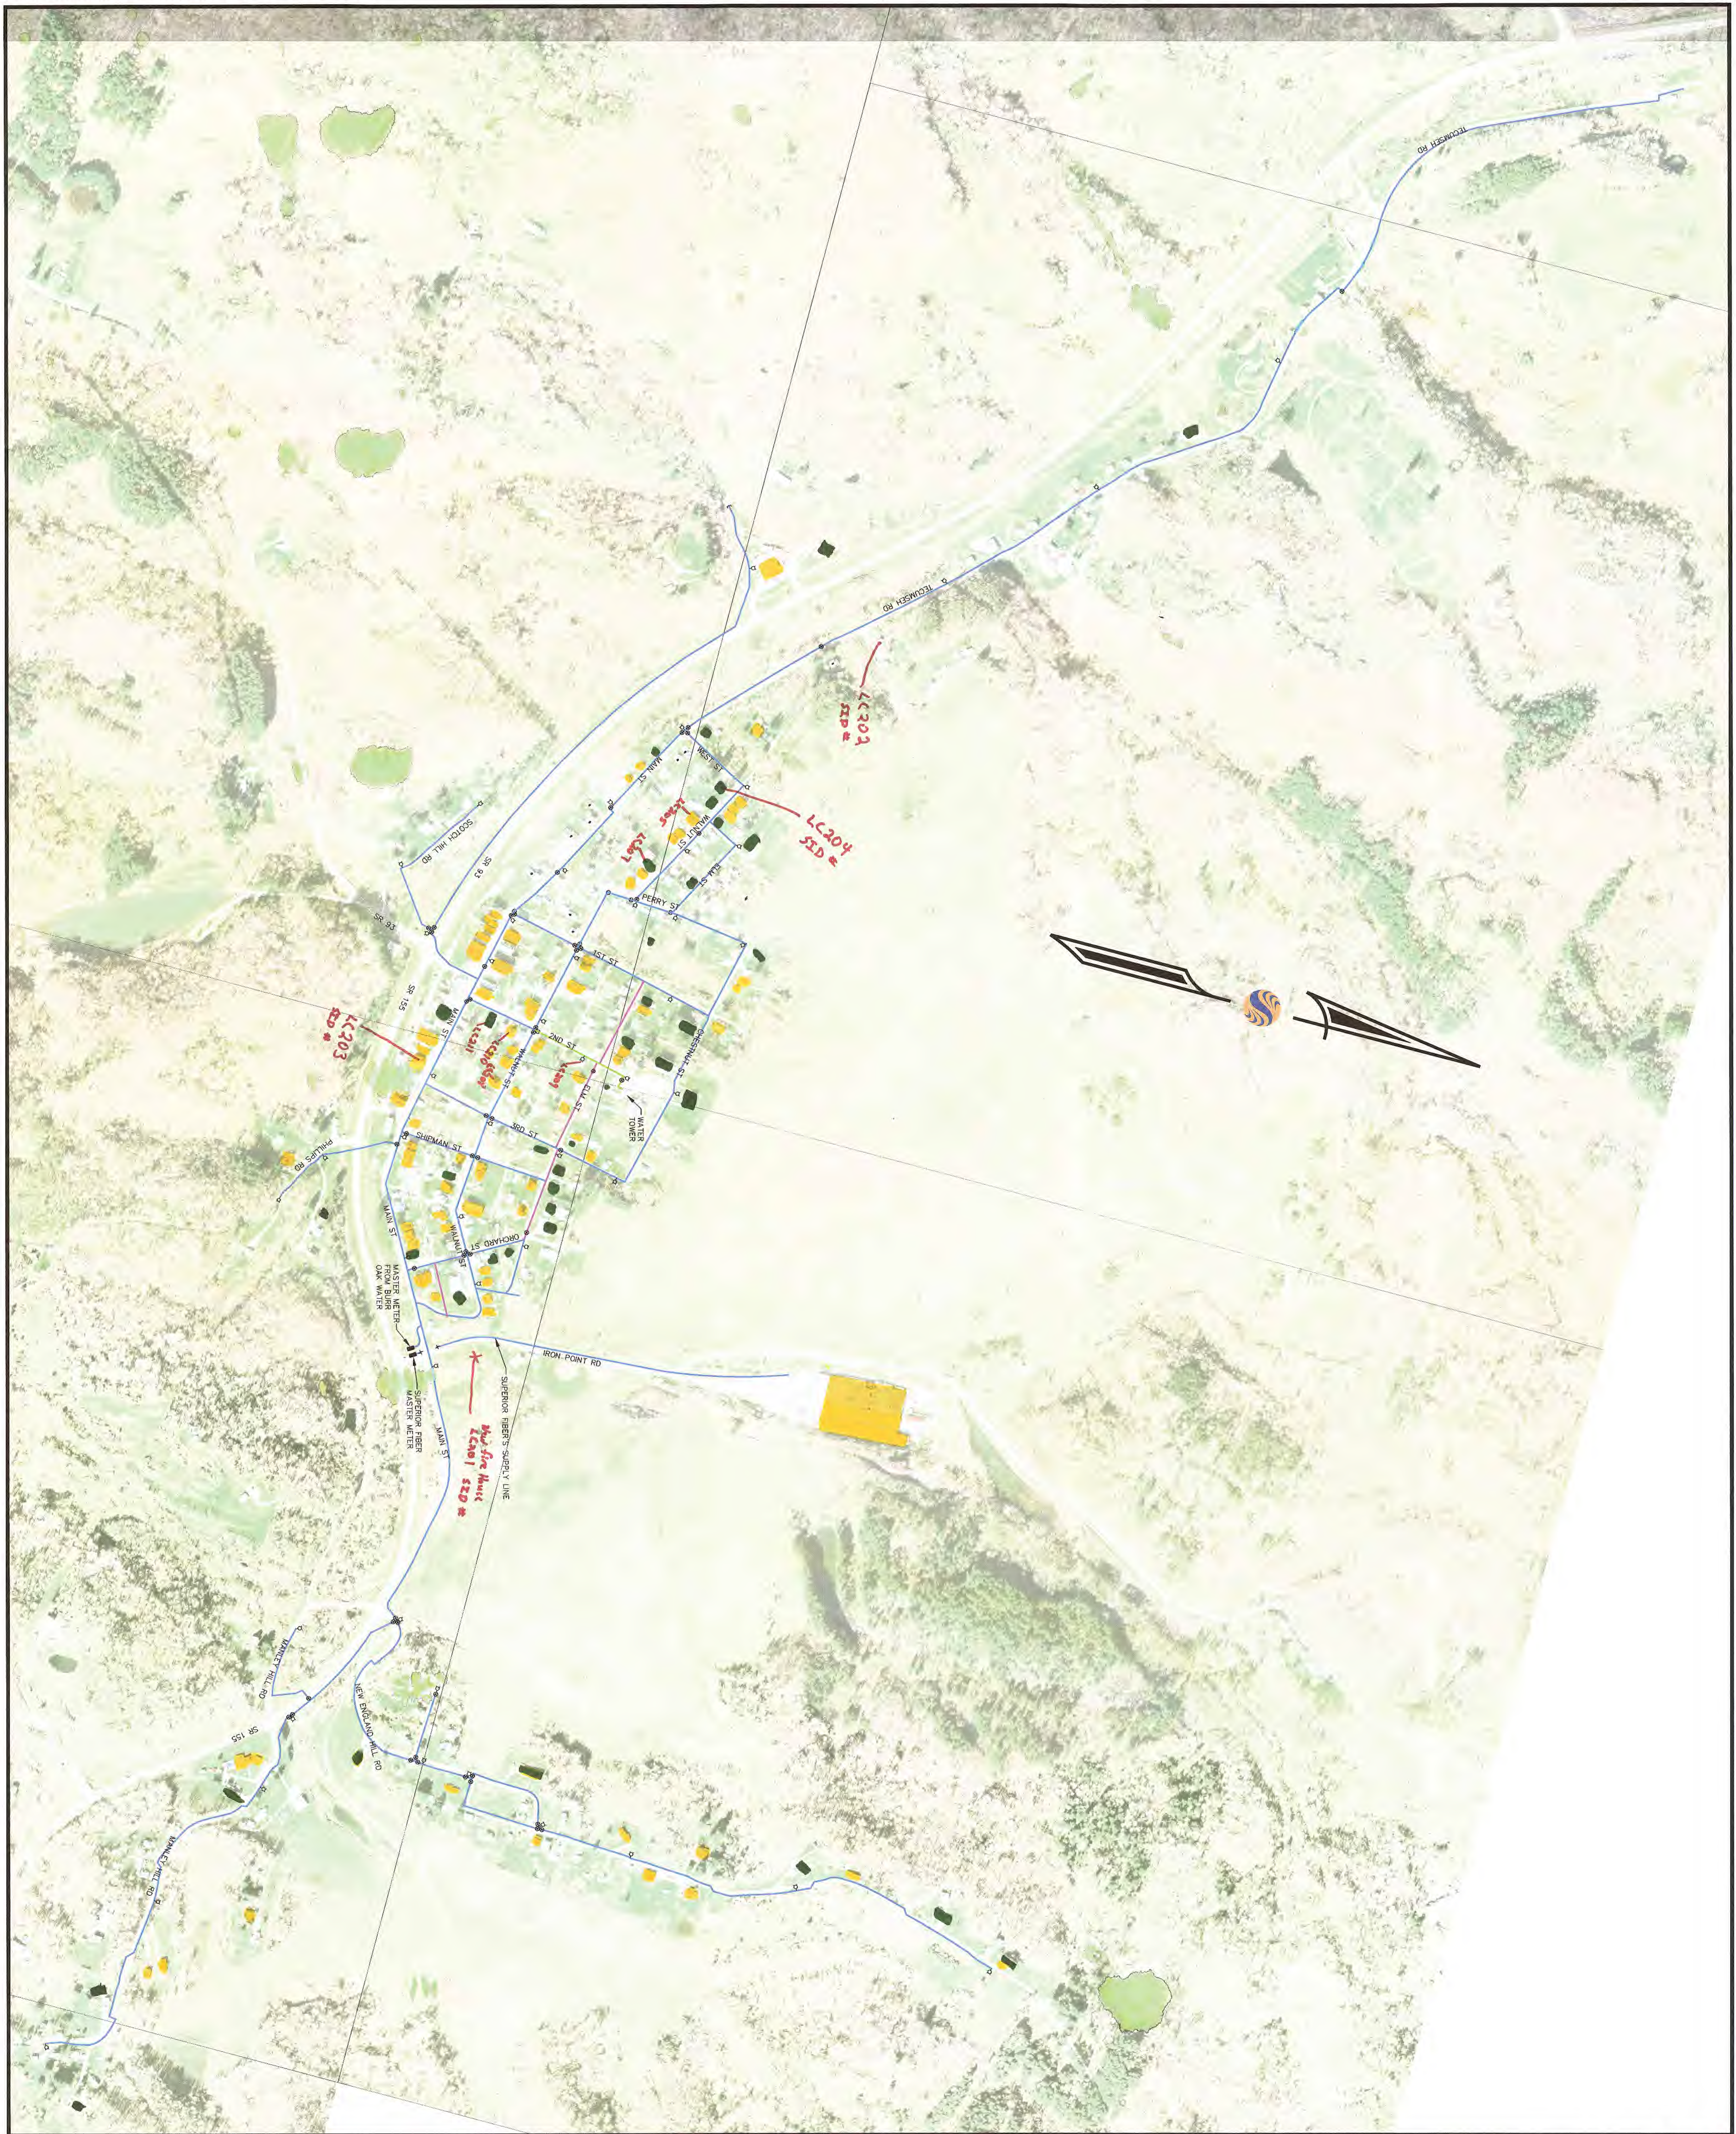
We went around door to door with our questionnaires with very little cooperation. People act like they don't care or they don't want to let us know what type of plumbing is in their homes. Most service lines from the meters to the houses and business' are either copper or galvanized.

I have located our lead and copper sample site with red, and I listed the sample site ID #s

Thank you,  
Jay Simons  
Village Administrator

-  Before 1983
-  After 1983
-  Lead and copper sample sites



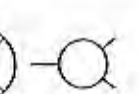

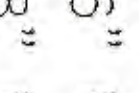
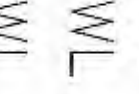



Copyright Reserved  
 The Contractor shall verify and be responsible for all dimensions. DO NOT scale dimensions from drawings or omissions shall be reported to Stantec without delay. All rights reserved. No part of this drawing may be reproduced or used for any purpose other than that authorized by Stantec or its subsidiaries.

DESIGN: MDB  
 DRAWN: RAE  
 SCALE: N.T.S.



**Stantec**  
 1311 W. HUNTER STREET LOGAN, OHIO 43138  
 (740) 380-2828 1-866-558-2828  
 FAX (740) 380-3535

**Legend:**  
 Hydrant:   
 Gate Valve:   
 4" WL   
 6" WL   
 8" WL 

# Village of Shawnee Water System Map

DATE: 03/25/2015

PROJECT NO. 173409059