

Boyd's Kinsman Home
PWS 7804712
community water system

7929 state route 5
kinsman, ohio 44428

LC 201-kitchen sink
LC 202-small kitchen sink -near restroom
LC 203-staff kitchen sink
LC 204-nurse's station sink
LC 205-second floor laundry sink



water room constructed 1970. plastic pipe (pvc) used in water room
well #1- directly behind main building - service line plastic
well #2- near office door - service line plastic

RECEIVED



MAR 08 2017

OHIO EPA NEDO

Boyd's
Kinsman Home
1st Floor

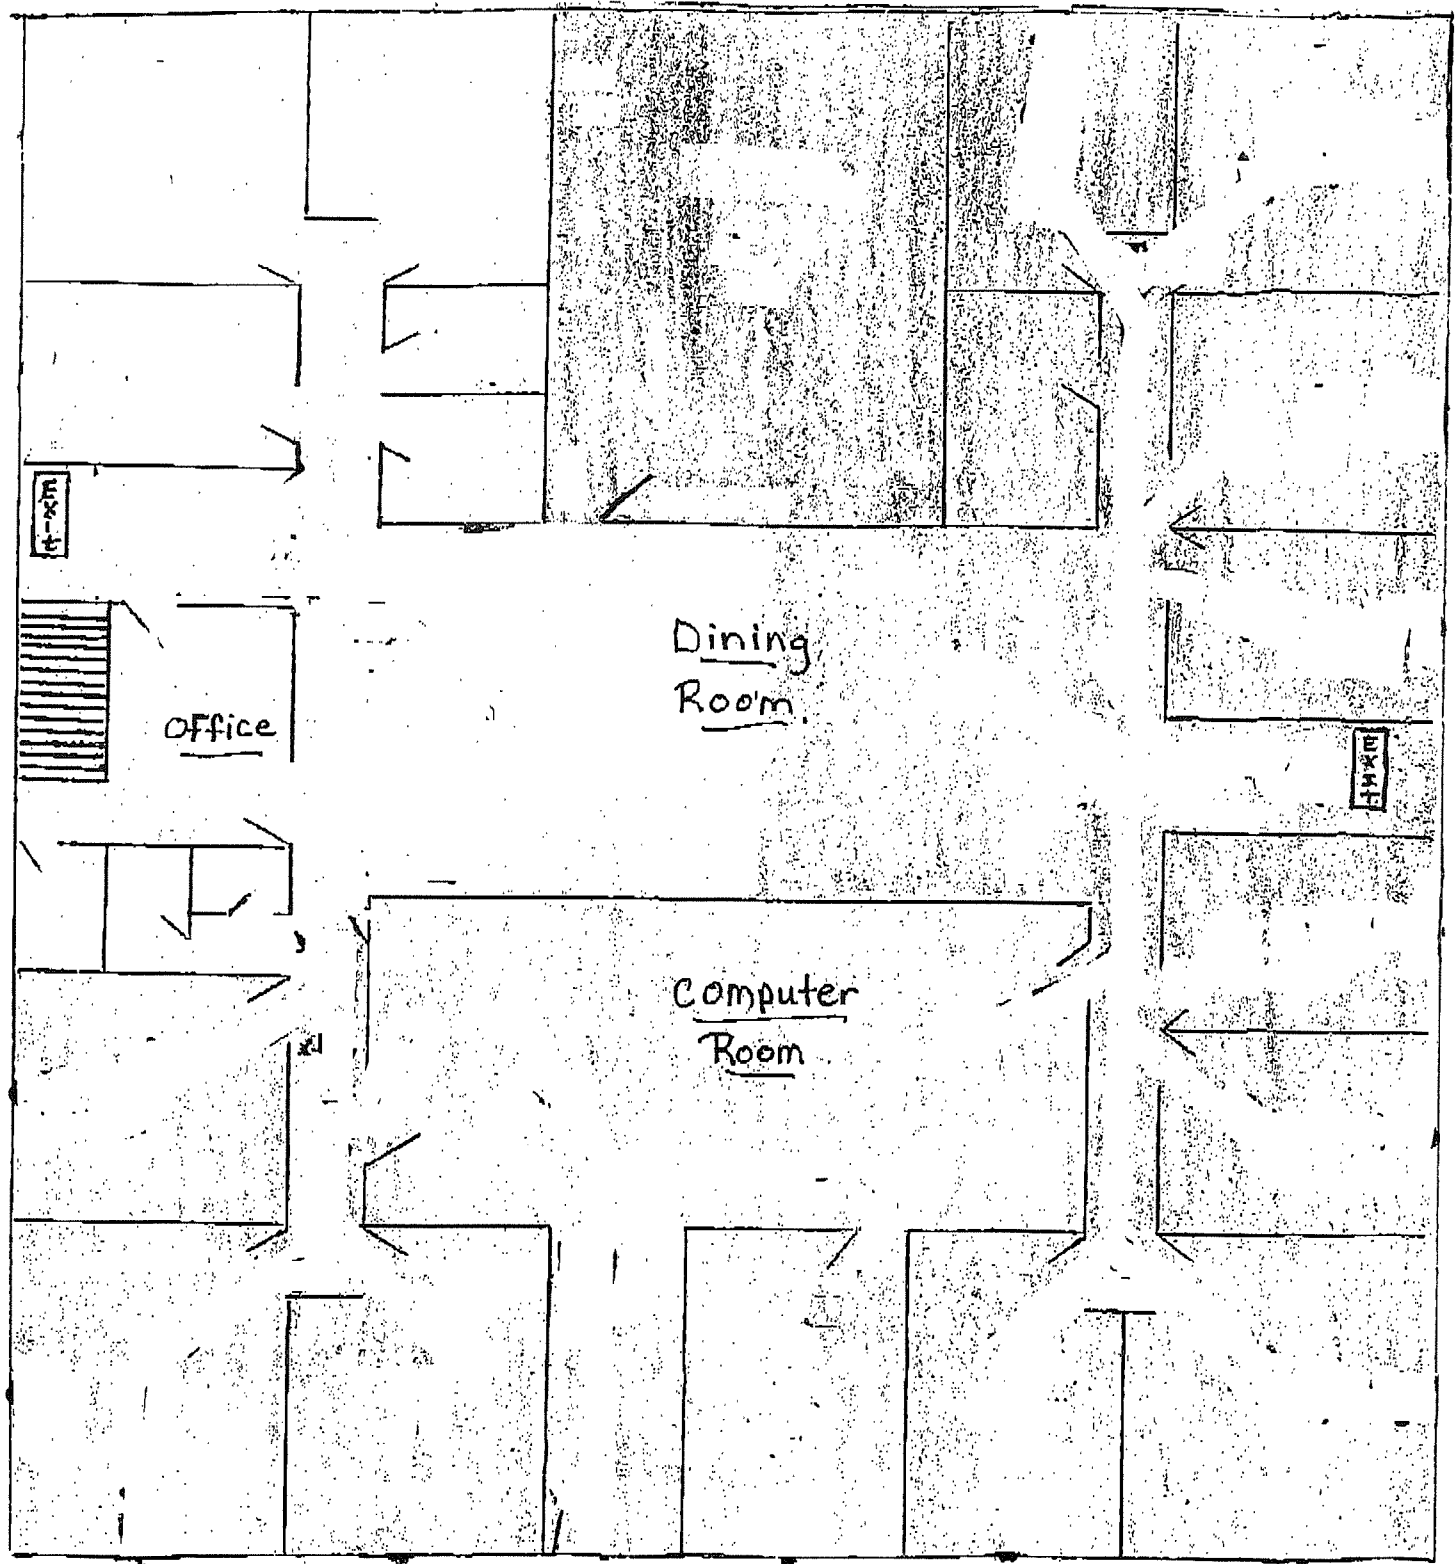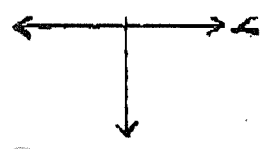


NOT DRAWN TO SCALE

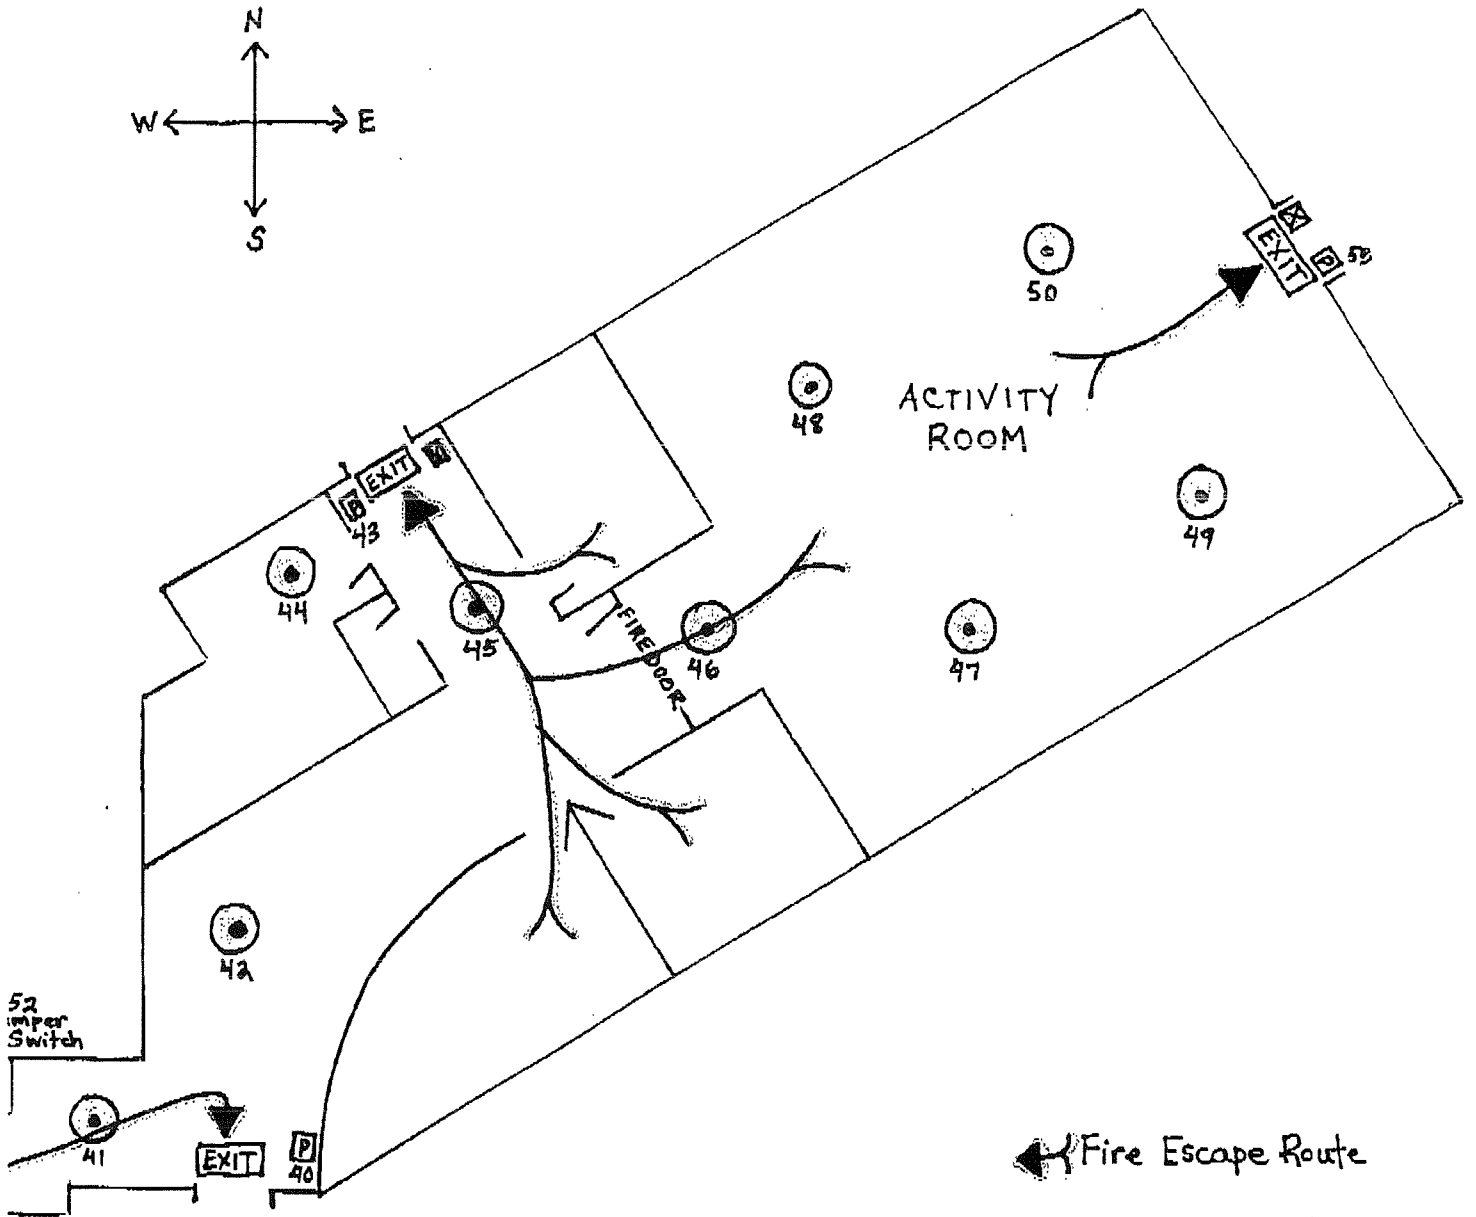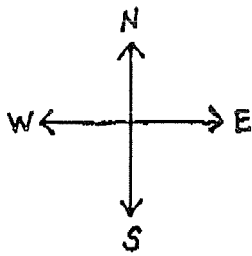

- ← Fire Escape Route
- ☒ Fire Extinguishers
- ☐ Pull Stations
- ⊙ Smoke Detectors

For severe weather drills, residents will congregate in the first floor south hallways of Main Building

The meeting place for the residents for fire drills is the South Side of the Bus Garage

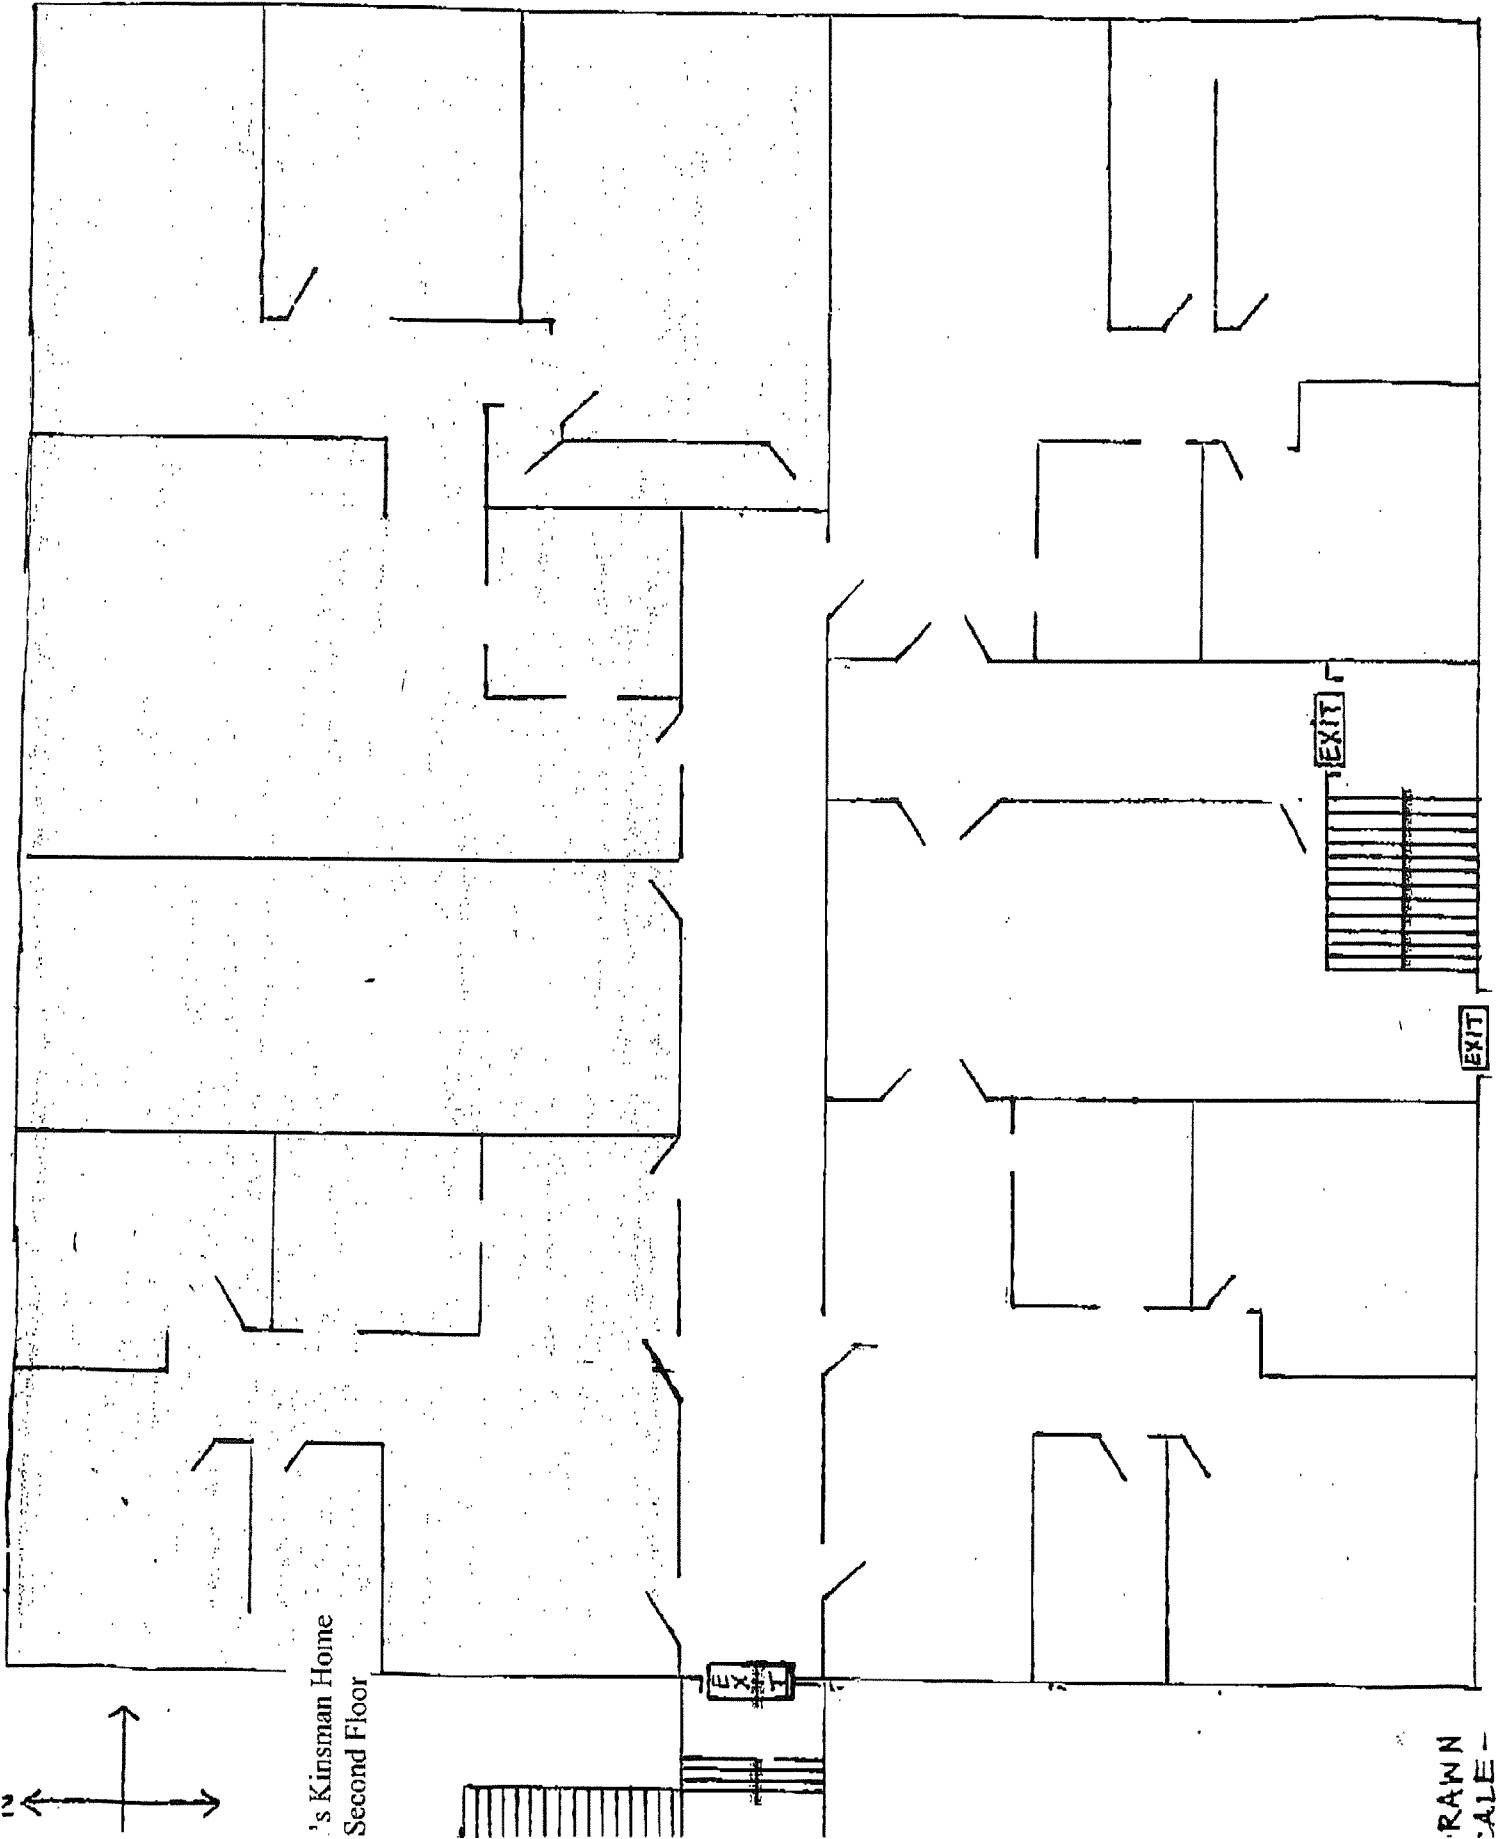

Boyd's Kinsman Home
Second Floor



F

RANN
SALES