




1	PLANT LAYOUT	3/11/15	MM
2	PLANT LAYOUT	3/11/15	MM
3	PLANT LAYOUT	3/11/15	MM
4	PLANT LAYOUT	3/11/15	MM

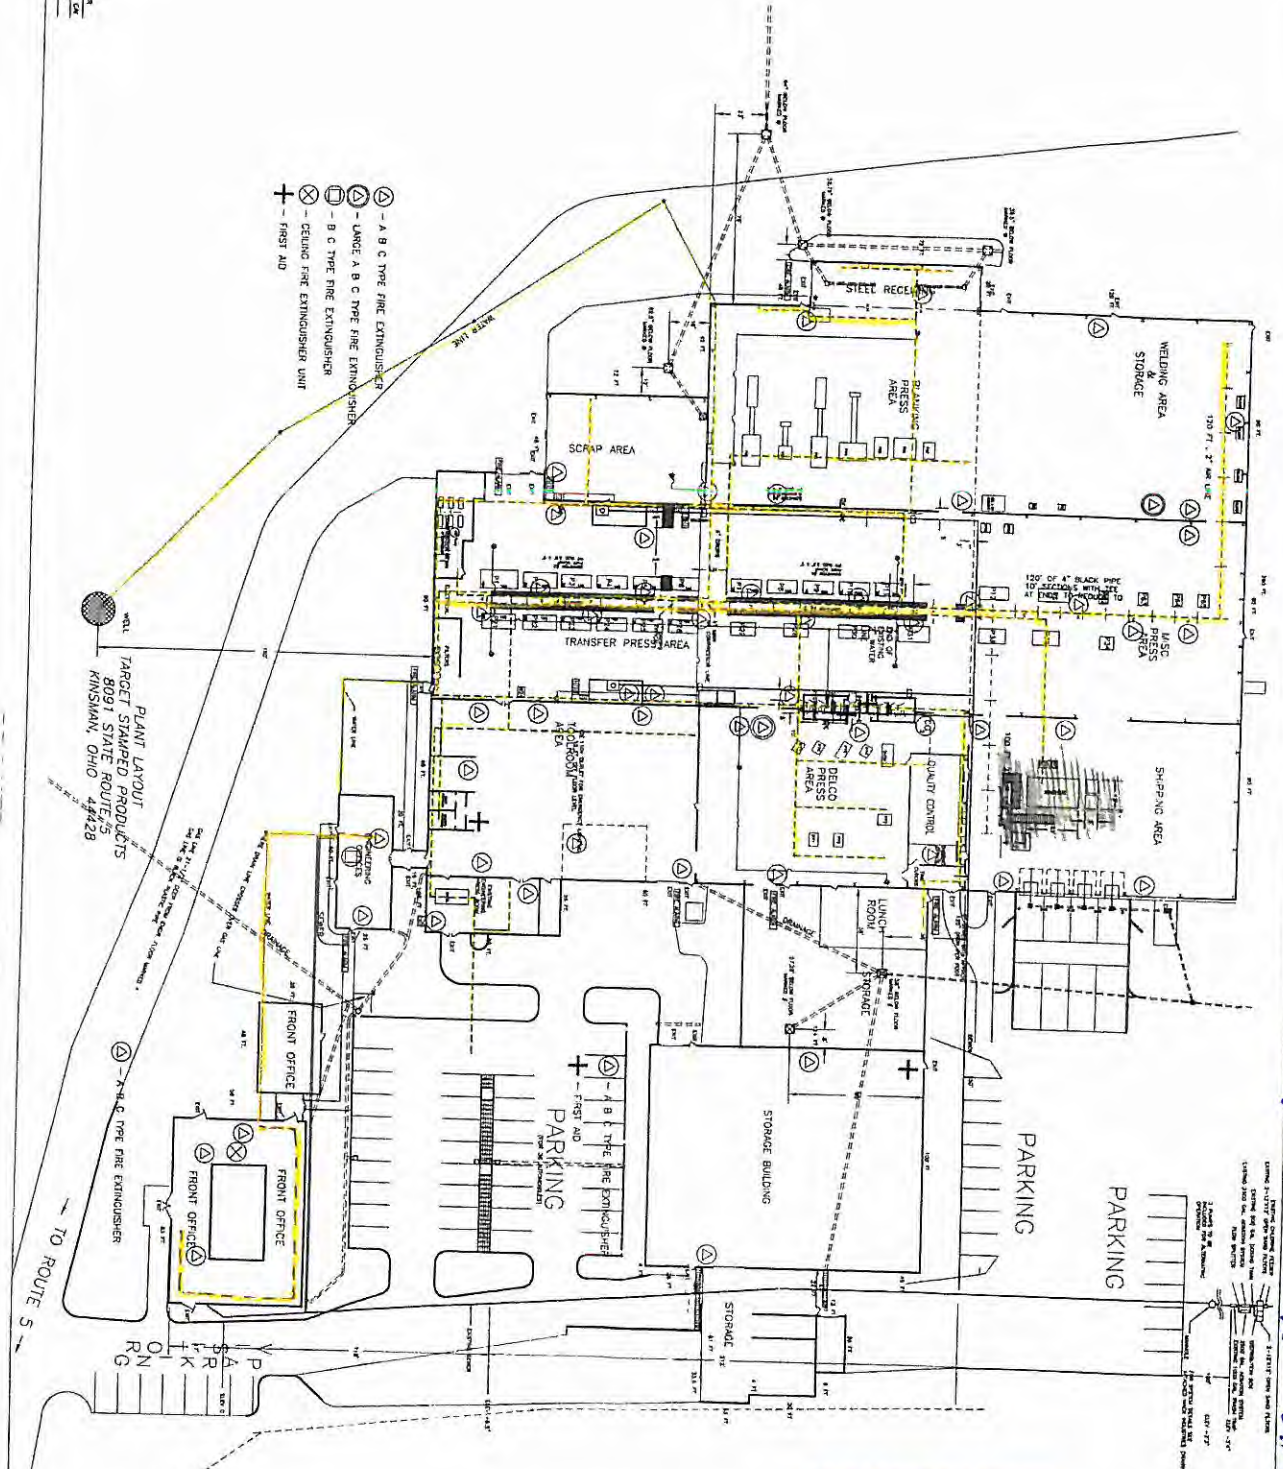

PLANT LAYOUT  
 TARGET STAMPED PRODUCTS  
 KINSMAN, OHIO 44428

- △ - A B C TYPE FIRE EXTINGUISHER
- - LARGE A B C TYPE FIRE EXTINGUISHER
- - B C TYPE FIRE EXTINGUISHER
- ⊗ - CEILING FIRE EXTINGUISHER UNIT
- +



*Boyle*

PWS

04 7850312

RECEIVED  
 MAR 08 2017  
 OHIO EPA NEDO