

VERIFICATION FORM FOR COMMUNITY PUBLIC WATER SYSTEMS CLAIMING NO LEAD SERVICE LINES

The owner or operator of all community public water systems must identify and map areas of their distribution system that are known or are likely to contain lead service lines. Systems must submit a copy of the applicable map to the Ohio Department of Health and the Ohio Department of Job and Family Services. Systems must also submit a report to the director containing at least both of the following: (1) The applicable map with narrative, and (2) A list of sampling locations used to collect samples as required by Ohio Revised Code (ORC) Section 6109.121 and any rules adopted thereunder, including contact information for the owner and occupant of each sampling site.

Should a water system determine no lead service lines exist in their distribution system, they must provide information stating they reviewed, at the minimum, historical permit records and local ordinances, distribution maintenance records and information pertaining to installation dates or materials for all services lines. This information must be verified below.

I HEREBY CERTIFY THAT THE FOLLOWING METHOD(S) WERE USED TO DETERMINE NO LEAD SERVICE LINES EXIST IN THIS WATER SYSTEM'S DISTRIBUTION SYSTEM, AS REQUIRED BY ORC 6109.121(F):

LEAD SERVICE LINE VERIFICATION
<p>This PWS states they have no lead service lines and has reviewed the following information (select one or more of the following):</p> <ul style="list-style-type: none"> <input type="checkbox"/> Historical permit records and/or local ordinances <input checked="" type="checkbox"/> Distribution maintenance records (i.e. meter replacement, waterline break repairs) <input type="checkbox"/> Information pertaining to installation dates for all service lines (i.e. after 1986 when lead services lines were banned) <input type="checkbox"/> Service line material of all service lines is known (i.e. all service lines are known to be PVC)

Entity: Pleasant Valley Ch
 Doc Type: Report
 Doc Subtype:
 Program: DDAEW
 County: Trumbull
 Secondary ID: OH 7854312

Edward Mosko 3-6-2017
 Signature of Responsible Person Date
 Edward Mosko
 Printed Name and Title of Responsible Person

PWS NAME: _Pleasant Valley Church_____
PWS ID: OH_7854312_____
COUNTY: __Trumbull_____

<p><u>For Ohio EPA use only:</u></p> <p>Date Verification Rec'd: _____</p>

RECEIVED
 MAR 08 2017
 OHIO EPA NEDO

Pleasant Valley
PWS 7854312
nontransient noncommunity water system

2055 Pleasant Valley road
Niles, Ohio 44446

LC 201- reception sink - tier 2
LC 202- men's locker room - sink #4 - tier 2
LC 203- men's locker room - sink #1 - tier 2
LC 204- ladies locker room - sink #3 - tier 2
LC 205- ladies locker room - sink #3 - tier 2

plastic pipe (pvc) used in water room
well #1- located at southeast of building - service line plastic
well #2- located at southeast of building - service line plastic


water line enters the corner of room 106
changes from plastic to copper with solder fitting.

water room is between men's locker and ladies locker room on the first floor.
once in the water room, the water line changes back to pvc.

in the water room sodium hypochlorite and phosphate is injected into the water.
next comes the bladder tanks (3 -40 gallons). then a chlorine contact (250
gallons). then it goes to iron filters. after the iron filters are softeners,

also in the water room is a RO unit that is supplied water after the softeners for
the drinking water fountains in the building. the drinking water fountains water
lines are pvc. a single 40 gallons bladder tank for the water after the RO unit.

water lines for the restrooms changes back to copper with solder fitting once
they leave the water room

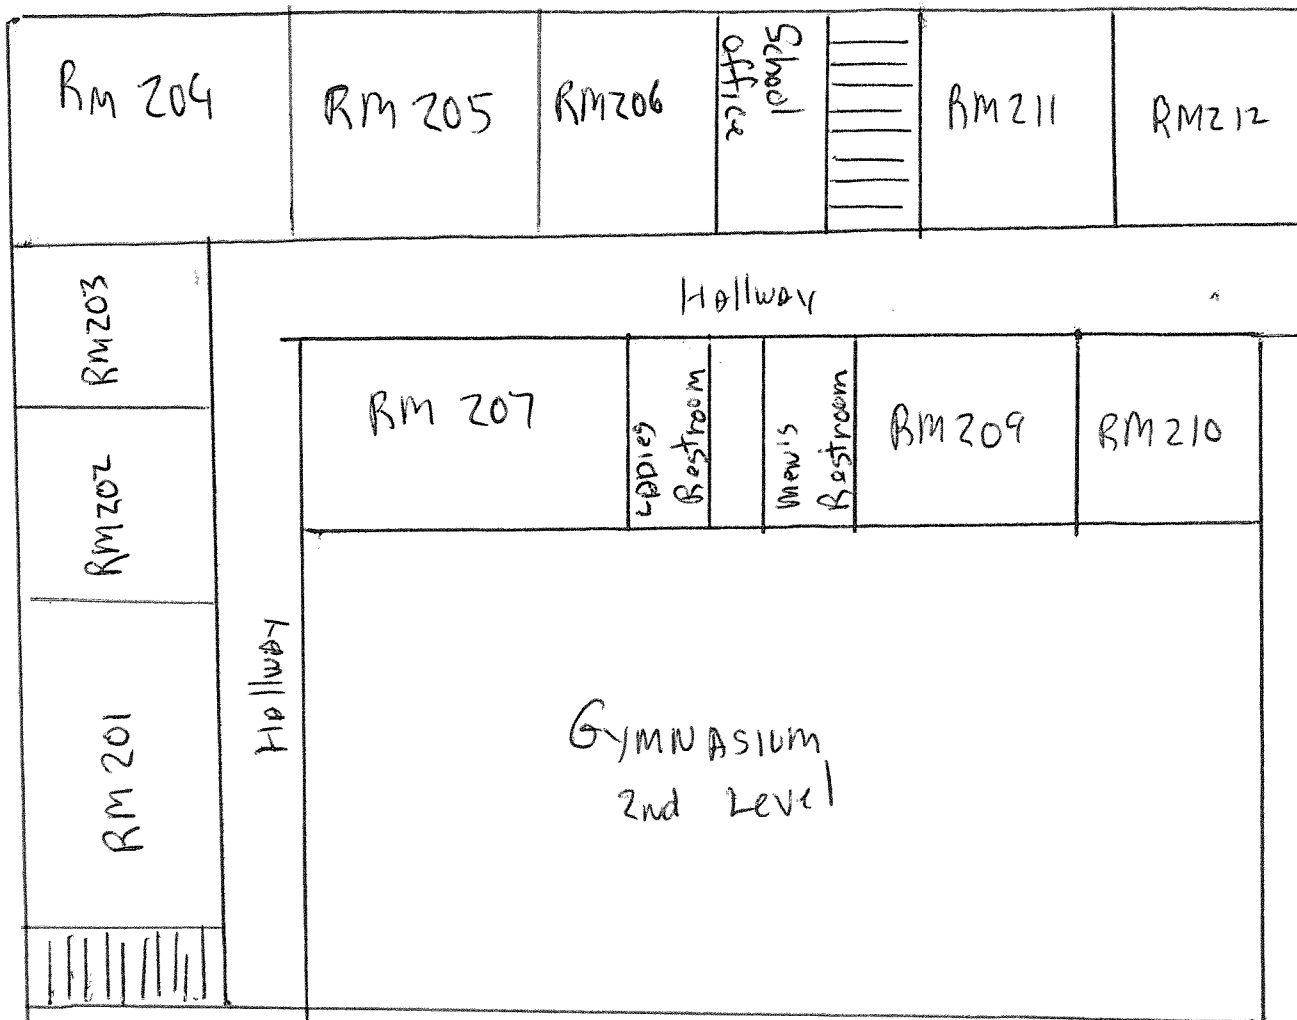

Pleasant Valley Church
 PWS 7854312
 (Second Floor)

RECEIVED

MAR 08 2017

OHIO EPA NEDO

