

VERIFICATION FORM FOR COMMUNITY PUBLIC WATER SYSTEMS CLAIMING NO LEAD SERVICE LINES

The owner or operator of all community public water systems must identify and map areas of their distribution system that are known or are likely to contain lead service lines. Systems must submit a copy of the applicable map to the Ohio Department of Health and the Ohio Department of Job and Family Services. Systems must also submit a report to the director containing at least both of the following: (1) The applicable map with narrative, and (2) A list of sampling locations used to collect samples as required by Ohio Revised Code (ORC) Section 6109.121 and any rules adopted thereunder, including contact information for the owner and occupant of each sampling site.

Should a water system determine no lead service lines exist in their distribution system, they must provide information stating they reviewed, at the minimum, historical permit records and local ordinances, distribution maintenance records and information pertaining to installation dates or materials for all services lines. This information must be verified below.

I HEREBY CERTIFY THAT THE FOLLOWING METHOD(S) WERE USED TO DETERMINE NO LEAD SERVICE LINES EXIST IN THIS WATER SYSTEM'S DISTRIBUTION SYSTEM, AS REQUIRED BY ORC 6109.121(F):

LEAD SERVICE LINE VERIFICATION
<p>This PWS states they have no lead service lines and has reviewed the following information (select one or more of the following):</p> <ul style="list-style-type: none"> <input checked="" type="checkbox"/> Historical permit records and/or local ordinances <input checked="" type="checkbox"/> Distribution maintenance records (i.e. meter replacement, waterline break repairs) <input type="checkbox"/> Information pertaining to installation dates for all service lines (i.e. after 1986 when lead services lines were banned) <input checked="" type="checkbox"/> Service line material of all service lines is known (i.e. all service lines are known to be PVC)

Entity: Wilmot Village
 Doc Type: Report
 Doc Subtype: DDAGW
 Program: Stark
 County: Stark
 Secondary ID: OH 7606012

John Weyandt 3-3-17
 Signature of Responsible Person Date
John Weyandt OPERATOR
 Printed Name and Title of Responsible Person

WILMOT VILLAGE OF

PWS NAME: WILMOT WATER
 PWS ID: OH 7606012
 COUNTY: STARK

For Ohio EPA use only:

Date Verification Rec'd: _____


RECEIVED
 MAR 08 2017
 OHIO EPA NEDO

WILMOT WATER
PWS ID 7606012

WILMOT INCORPORATED

SUGAR CREEK P.B. 3 P. 196 PT. SE
WNSHIP 32 & 33
SCALE - 1"=100'

Note: see sugar creek see 32 N.E.Q

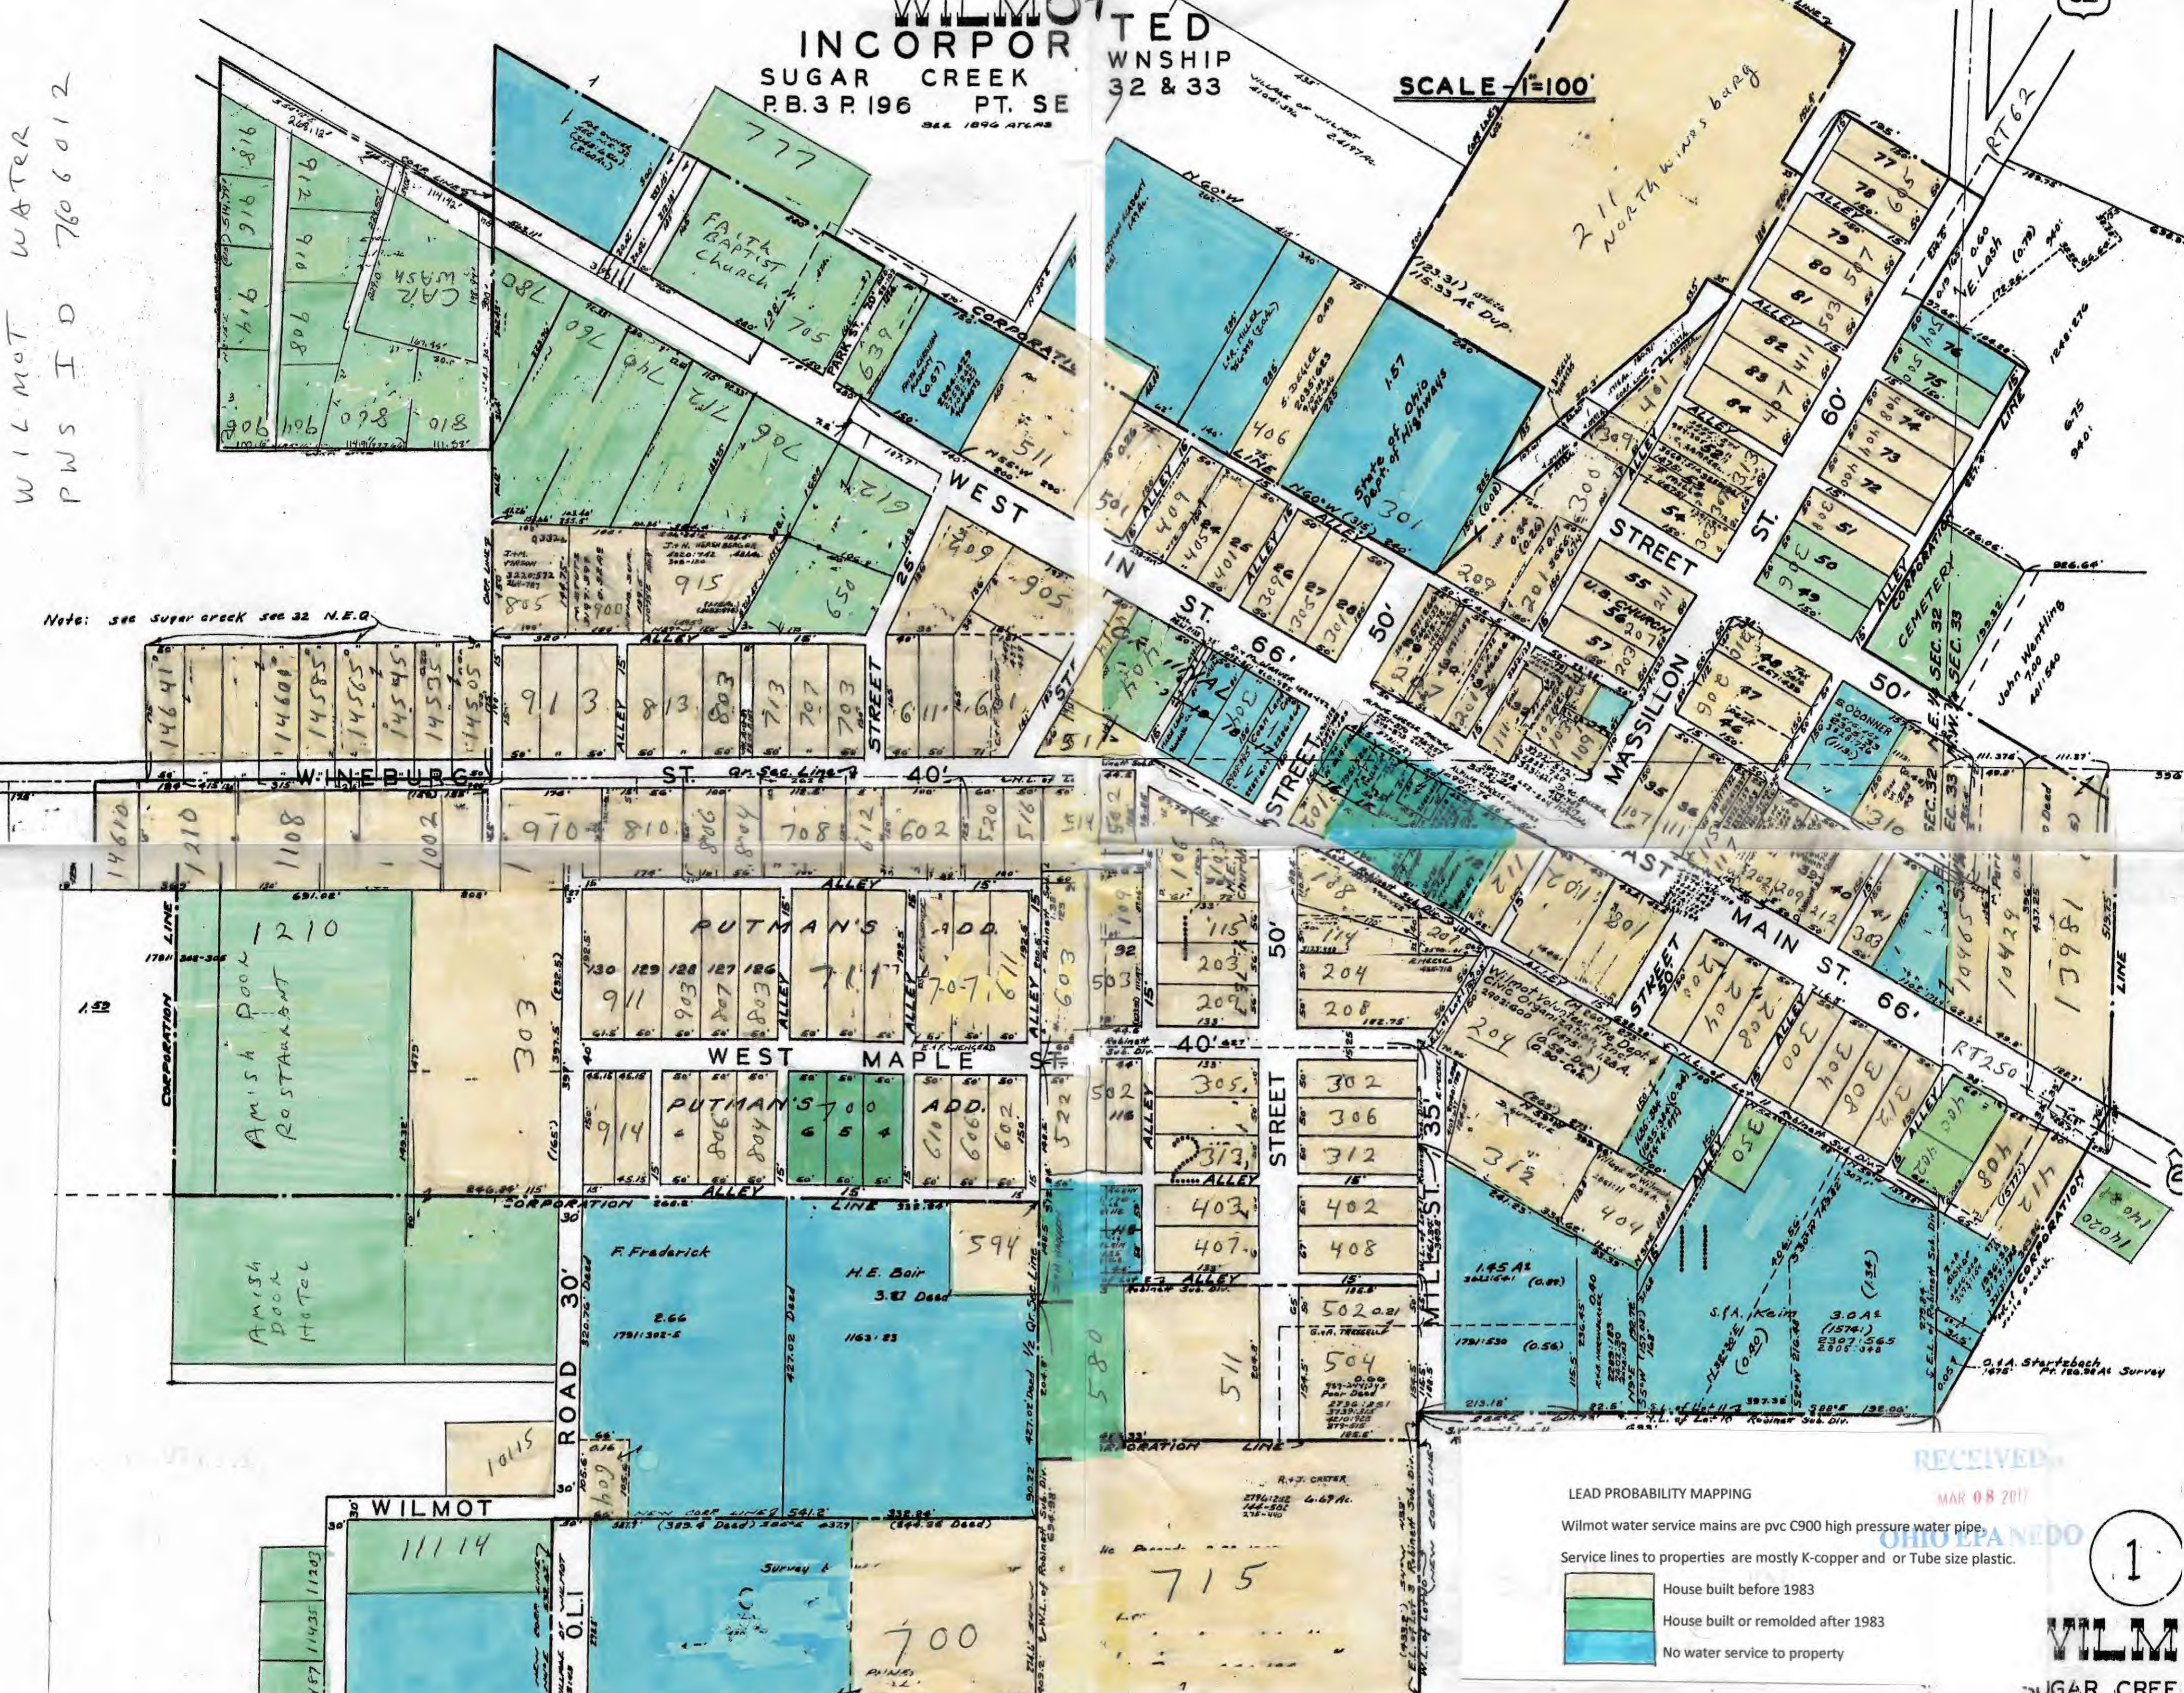

LEAD PROBABILITY MAPPING
Wilmot water service mains are pvc C900 high pressure water pipe.
Service lines to properties are mostly K-copper and or Tube size plastic.

- House built before 1983
- House built or remodeled after 1983
- No water service to property

RECEIVED
MAR 08 2017

OHIO EPA NEDD
1

WILMOT
SUGAR CREEK