
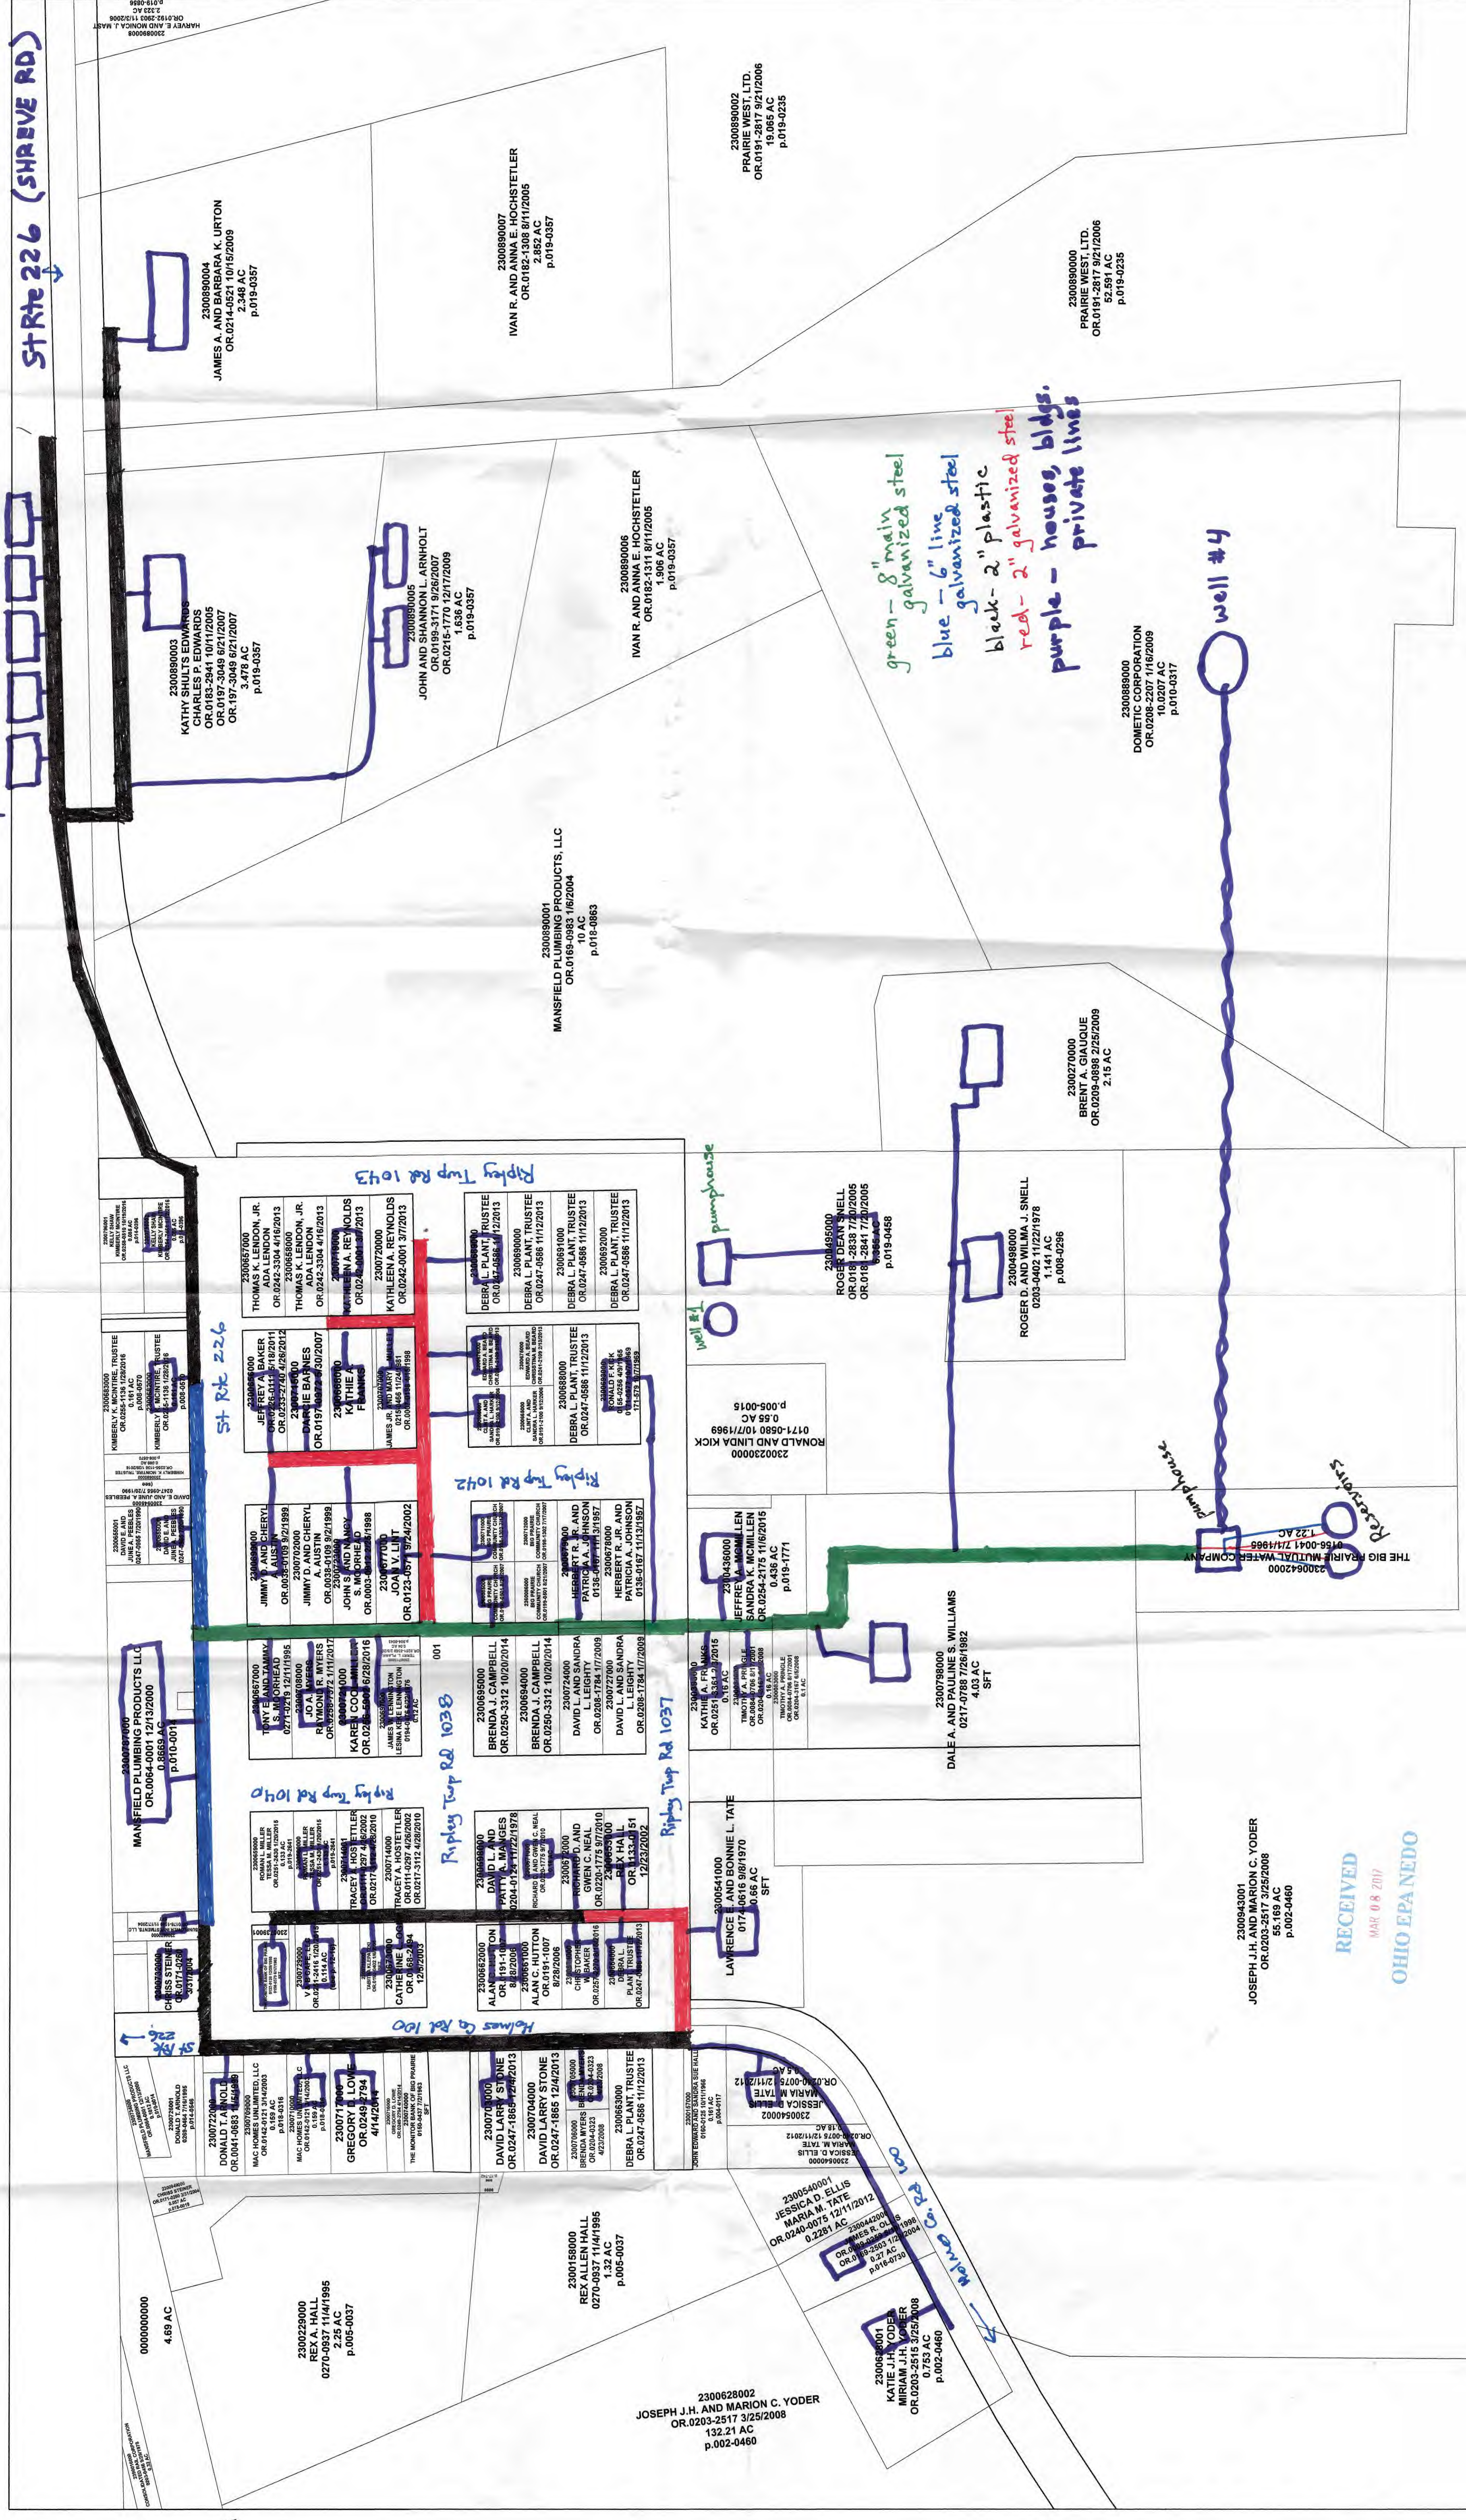


St Rte 226 (SHARVE RD)

Big Prairie Water Co.  
04380012

Print Date: 2/21/2017  
1 inch = 86 feet

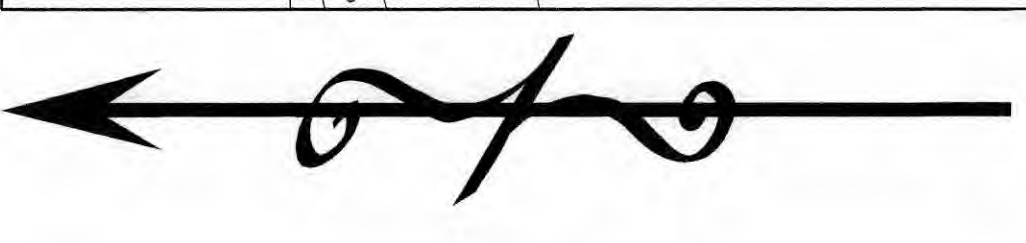

Entity: Big Prairie Water Co  
 Doc Type: HOA  
 Doc Subtype:  
 Program: OWNER  
 County: Holmes  
 Secondary ID: 04380012

RECEIVED  
 MAR 08 2017  
 OHIO SPANED

2300943001  
 JOSEPH J.H. AND MARION C. YODER  
 OR.0203-2517 3/25/2008  
 55.189 AC  
 p.002-0460

2300628002  
 JOSEPH J.H. AND MARION C. YODER  
 OR.0203-2517 3/25/2008  
 132.21 AC  
 p.002-0460

2300680001  
 MARIAM J.H. YODER  
 OR.0203-2515 3/25/2008  
 0.753 AC  
 p.002-0460

2300540001  
 JESSICA D. ELLIS  
 MARIA M. TATE  
 OR.0240-0075 12/11/2012  
 0.2281 AC

2300158000  
 REX ALLEN HALL  
 0270-0937 1/14/1995  
 1.32 AC  
 p.005-0037

2300704000  
 DAVID LARRY STONE  
 OR.0247-1865 12/4/2013

2300229000  
 REX A. HALL  
 0270-0937 1/14/1995  
 2.26 AC  
 p.005-0037

0000000000  
 4.69 AC

2300714000  
 DONALD T. ANELLI  
 OR.0041-6853  
 0.189 AC

2300714000  
 GREGORY J. LOWE  
 4/18/2008  
 0.189 AC

2300642000  
 THE BIG PRAIRIE MUTUAL WATER COMPANY  
 0158-0041 7/14/1985  
 1.22 AC

2300798000  
 DALE A. AND PAULINE S. WILLIAMS  
 0217-0788 7/26/1982  
 4.03 AC  
 SFT

2300436000  
 JEFFREY A. MOMMLLEN  
 SANDRA K. MCMLLEN  
 OR.0254-2175 11/6/2015  
 0.438 AC  
 p.019-1771

2300230000  
 RONALD AND LINDA KICK  
 0171-0588 1/17/1969  
 0.55 AC  
 p.005-0015

2300270000  
 BRENT A. GIAUQUE  
 OR.0209-0988 2/25/2009  
 2.19 AC

2300488000  
 ROGER D. AND WILMA J. SNELL  
 0203-0402 11/22/1978  
 1.141 AC  
 p.008-0286

2300495000  
 ROGER DEAY SNELL  
 OR.0119-2838 7/20/2005  
 0.168 AC  
 p.019-0488

2300889000  
 DOMETIC CORPORATION  
 p.010-0317

2300890000  
 MANSFIELD PLUMBING PRODUCTS, LLC  
 OR.0169-0983 1/6/2004  
 10 AC  
 p.016-0983

2300890006  
 IVAN R. AND ANNA E. HOCHSTETLER  
 OR.0162-1311 8/11/2005  
 p.019-0367

2300890005  
 JOHN AND SHANNON L. ARNHOLT  
 OR.0199-3171 9/26/2007  
 1.636 AC  
 p.019-0367

2300890003  
 KATHY S. EDWARDS  
 CHARLES P. EDWARDS  
 OR.0183-2941 10/11/2005  
 OR.0197-3049 6/21/2007  
 OR.197-3049 6/21/2007  
 3.478 AC  
 p.019-0367

2300890004  
 JAMES A. AND BARBARA K. URTON  
 OR.0214-0521 10/15/2009  
 2.388 AC  
 p.019-0367

2300890002  
 PRAIRIE WEST, LTD.  
 OR.0191-2817 9/21/2006  
 19.066 AC  
 p.019-0239

2300890000  
 PRAIRIE WEST, LTD.  
 OR.0191-2817 9/21/2006  
 p.019-0239

2300890007  
 IVAN R. AND ANNA E. HOCHSTETLER  
 OR.0162-1311 8/11/2005  
 p.019-0367

 p.019-0884