
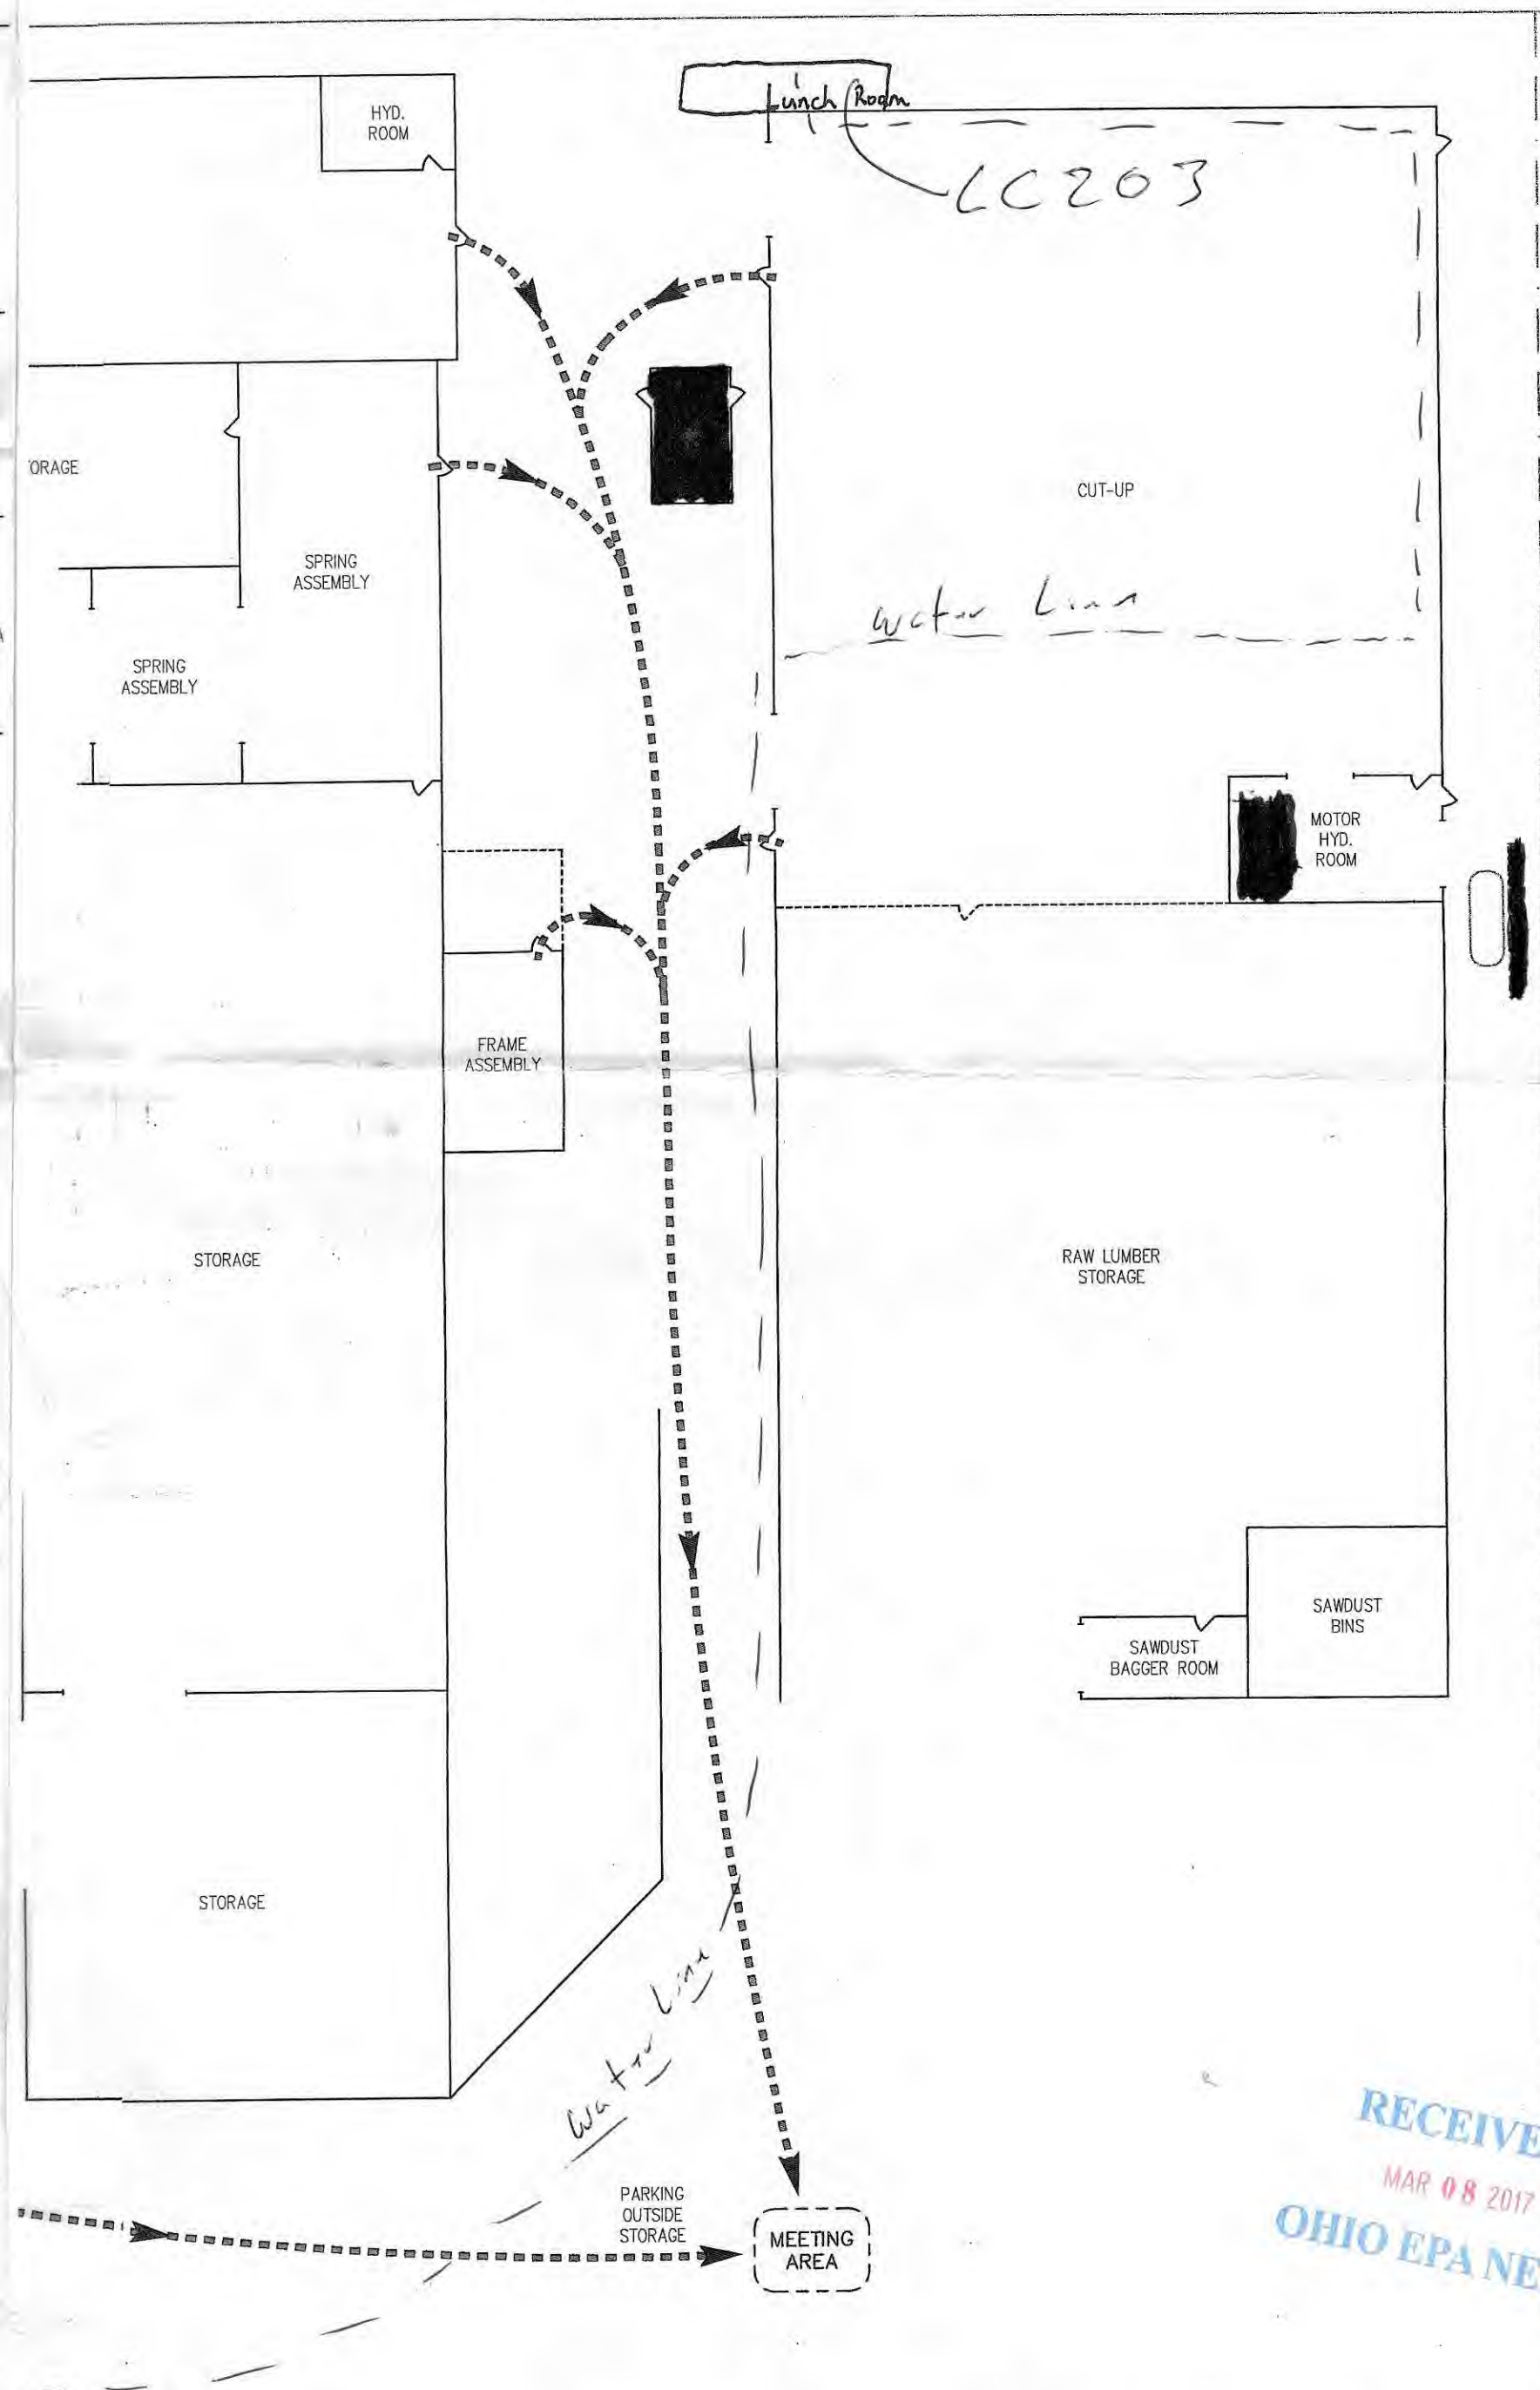


PRIVATE DRIVE
E DRIVE

KOHLER ROAD

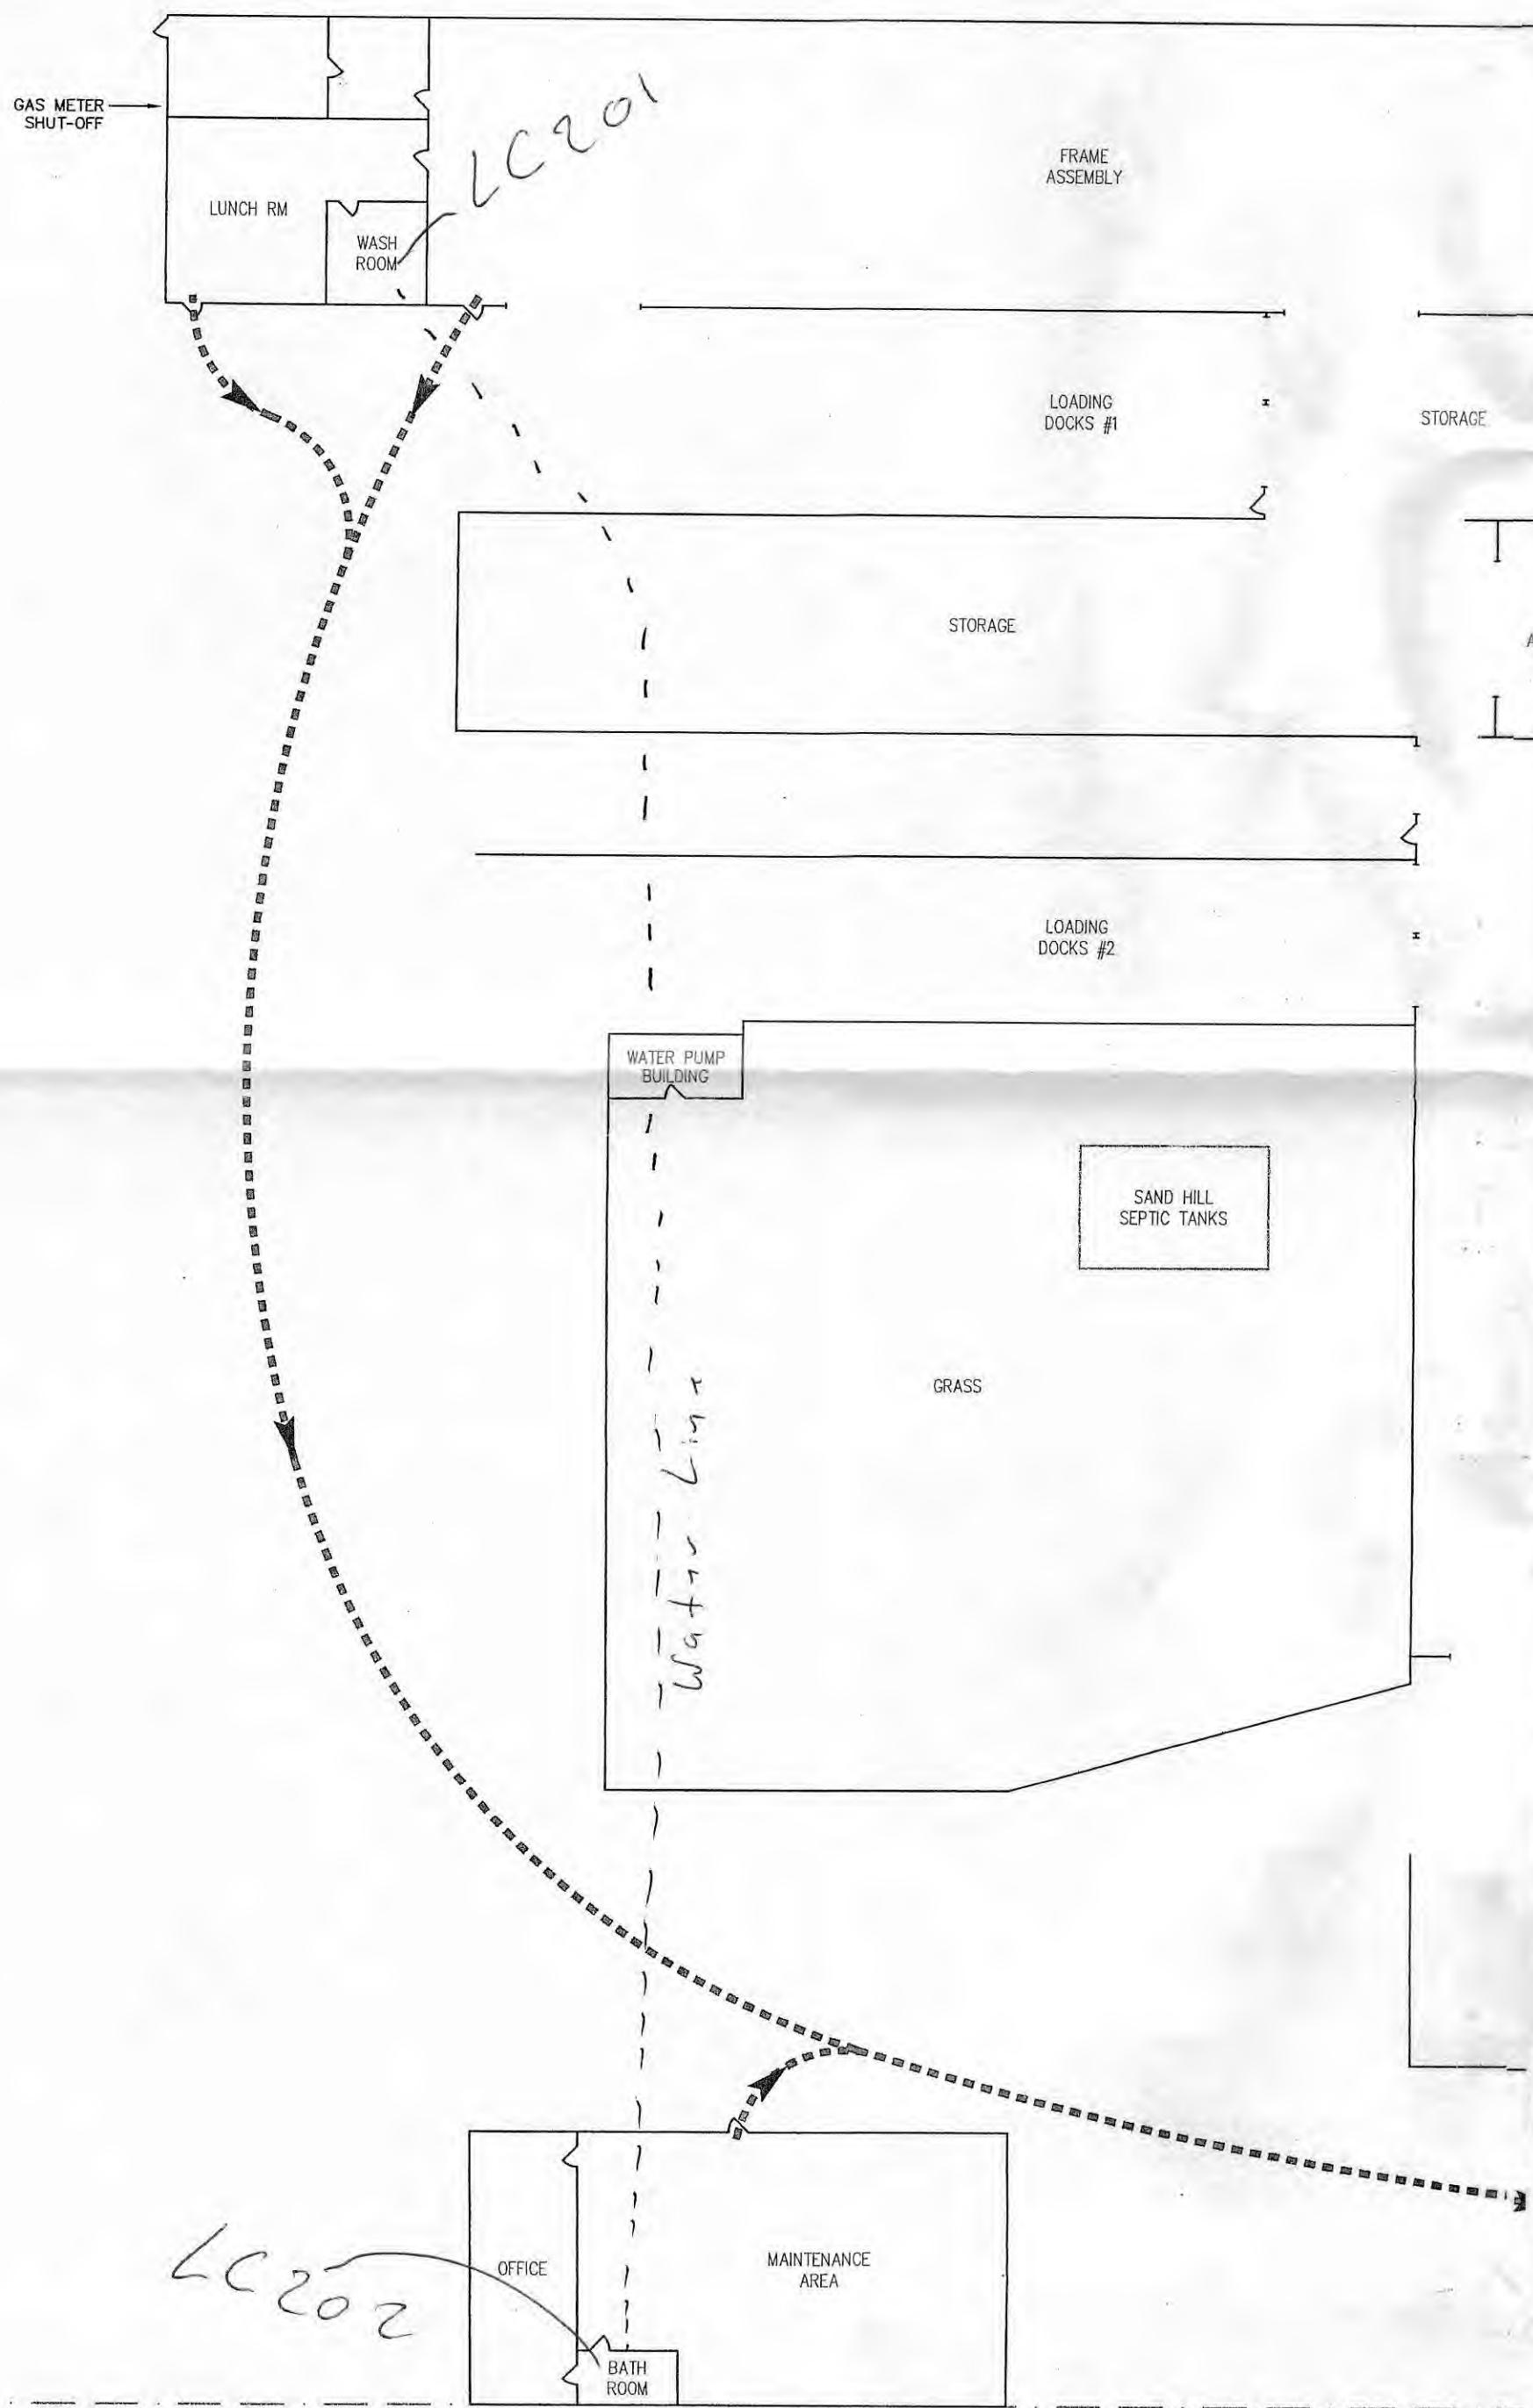

Entity: Eastwood MFG
 Doc Type: ASSET
 Doc Subtype: ASSET
 Program: WATER
 County: WARREN
 Secondary ID: 01651631A

RECEIVED
 MAR 08 2017
 OHIO EPA NEDO

Site Plan