


John Feather Plant Manager	Dan Wing EHS Coordinator
Date Map Created On:	March 7th, 2017
Ph: 740-962-2040	Fax: 740-962-6580


MAHLE - MCC Plumbing Site Map Bird's Eye




5130 North State Route 60 McConnelsville, Ohio 43756

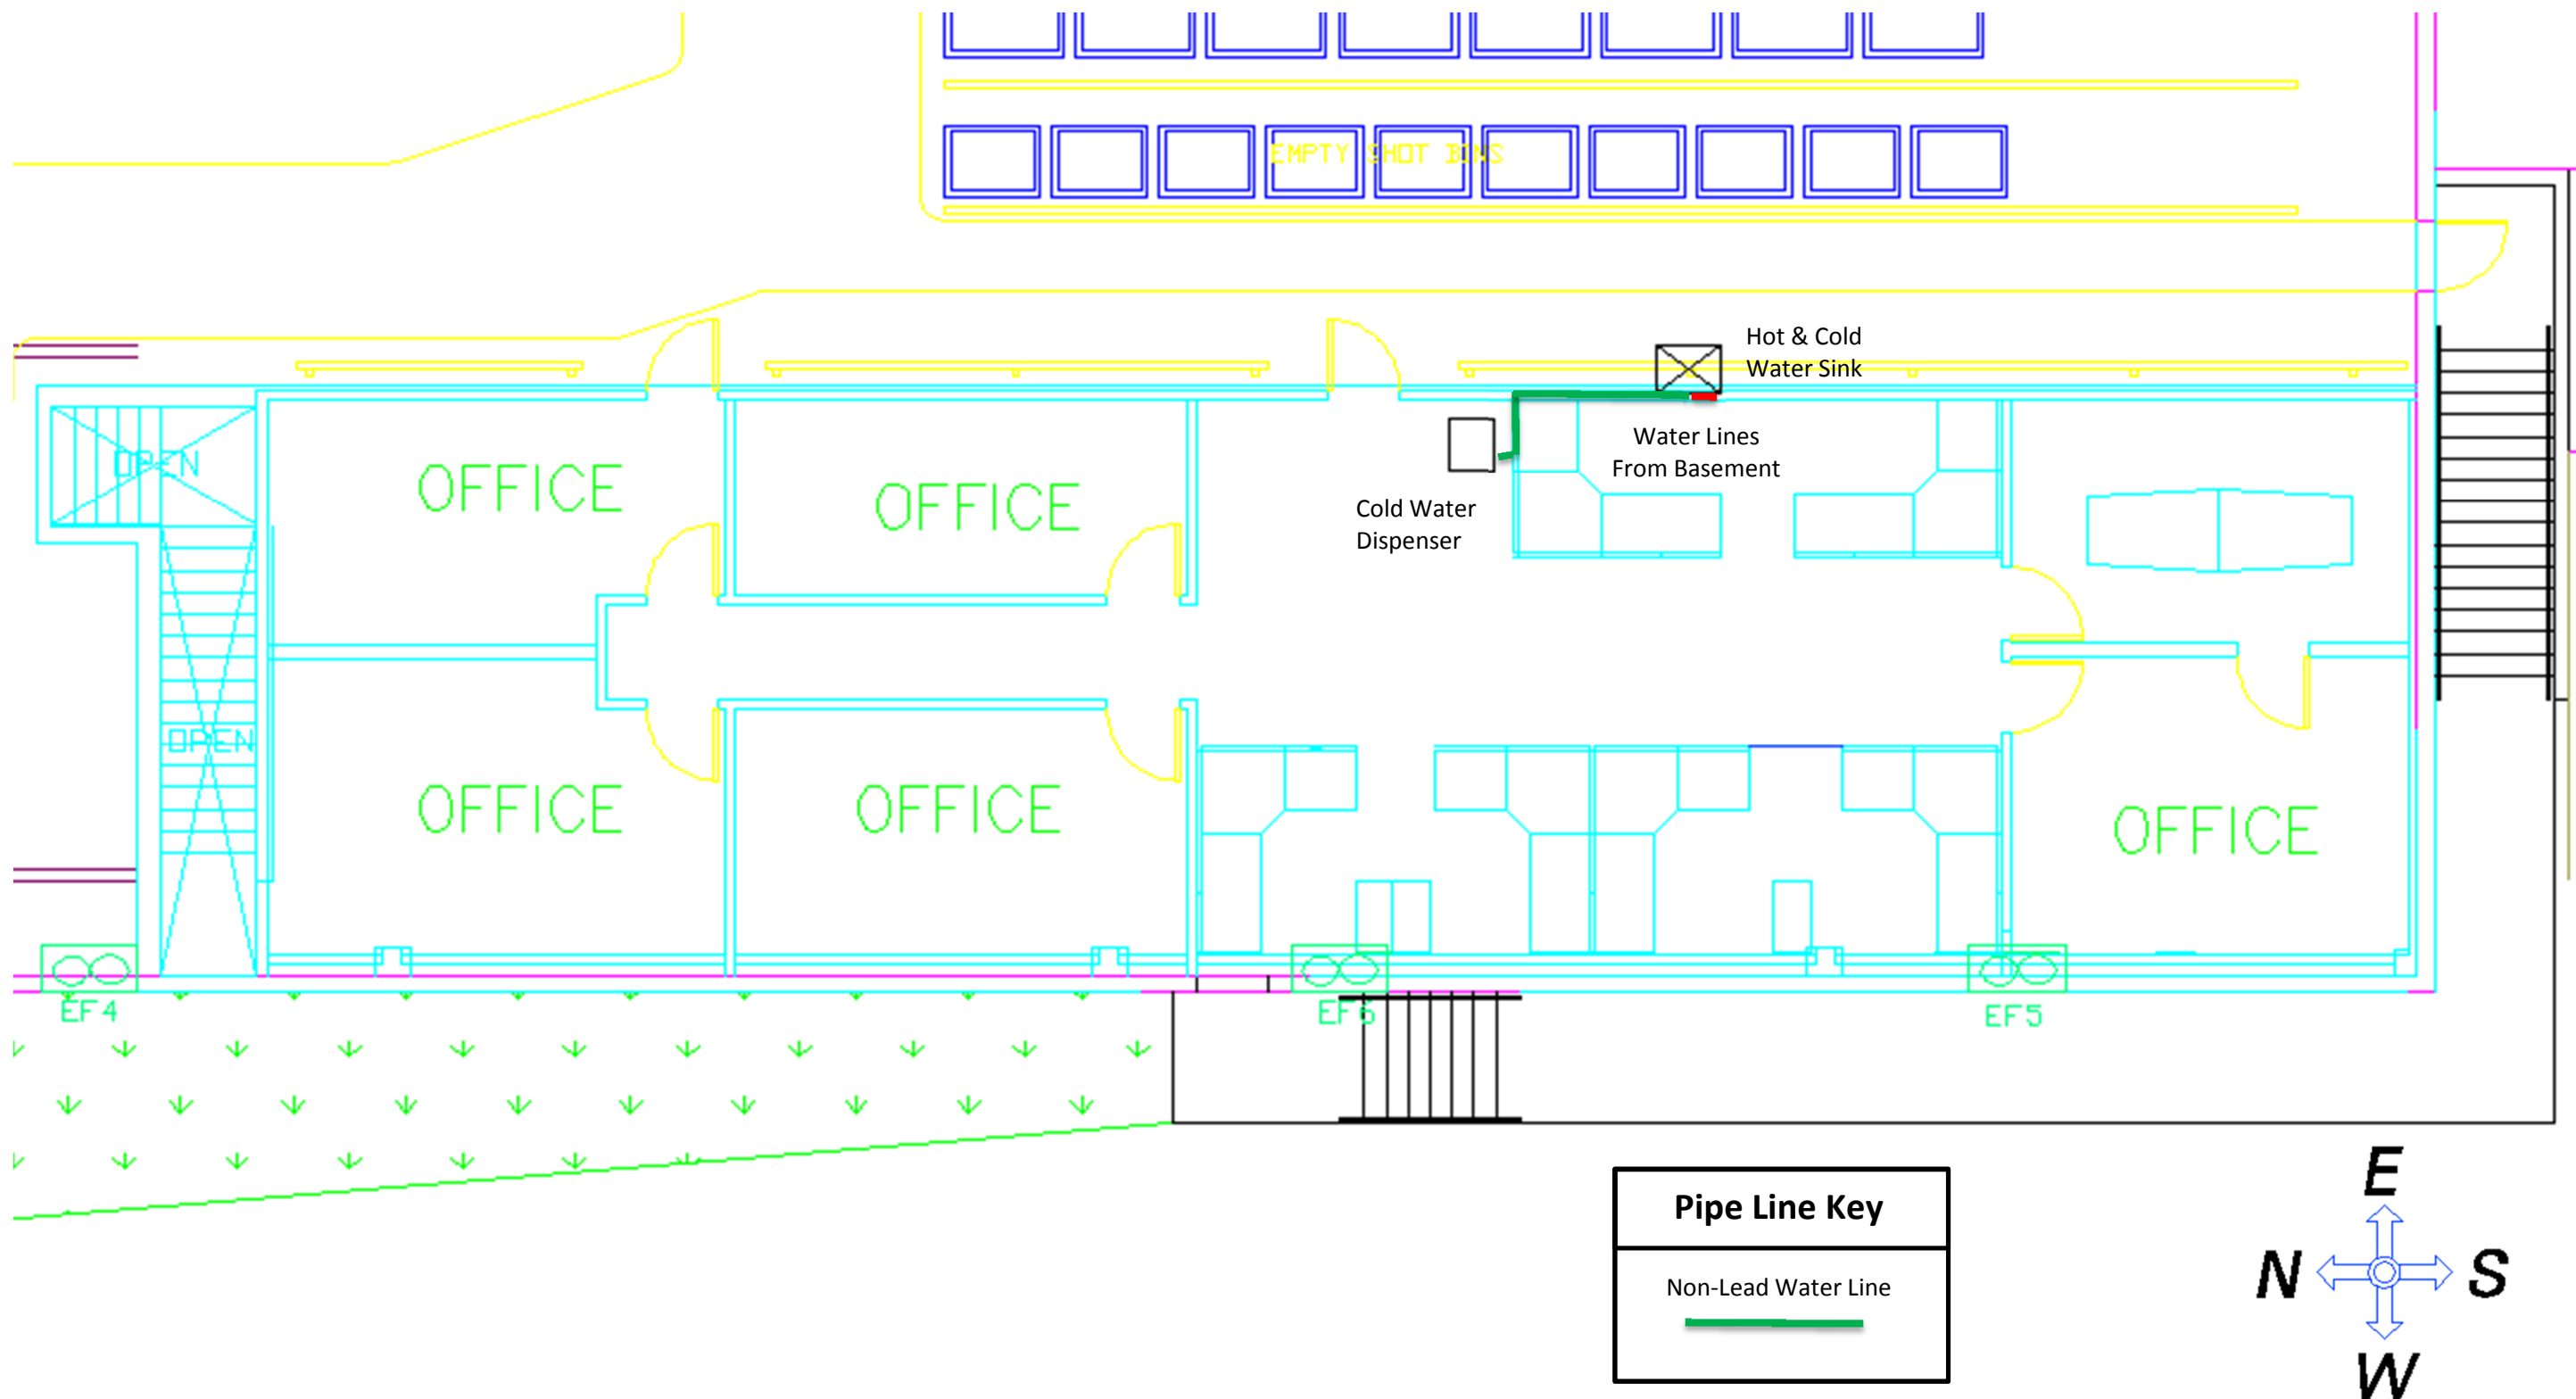


<p>John Feather Plant Manager</p> <p>Date Map Created On: Ph: 740-962-2040</p>	<p>Dan Wing EHS Coordinator</p> <p>March 7th, 2017 Fax: 740-962-6580</p>	<p>MCC Plumbing Site Map - South Building Office</p>	<div data-bbox="2268 1693 2797 1824"> </div> <p>5130 North State Route 60 McConnelsville, Ohio 43756</p>
--	--	---	---

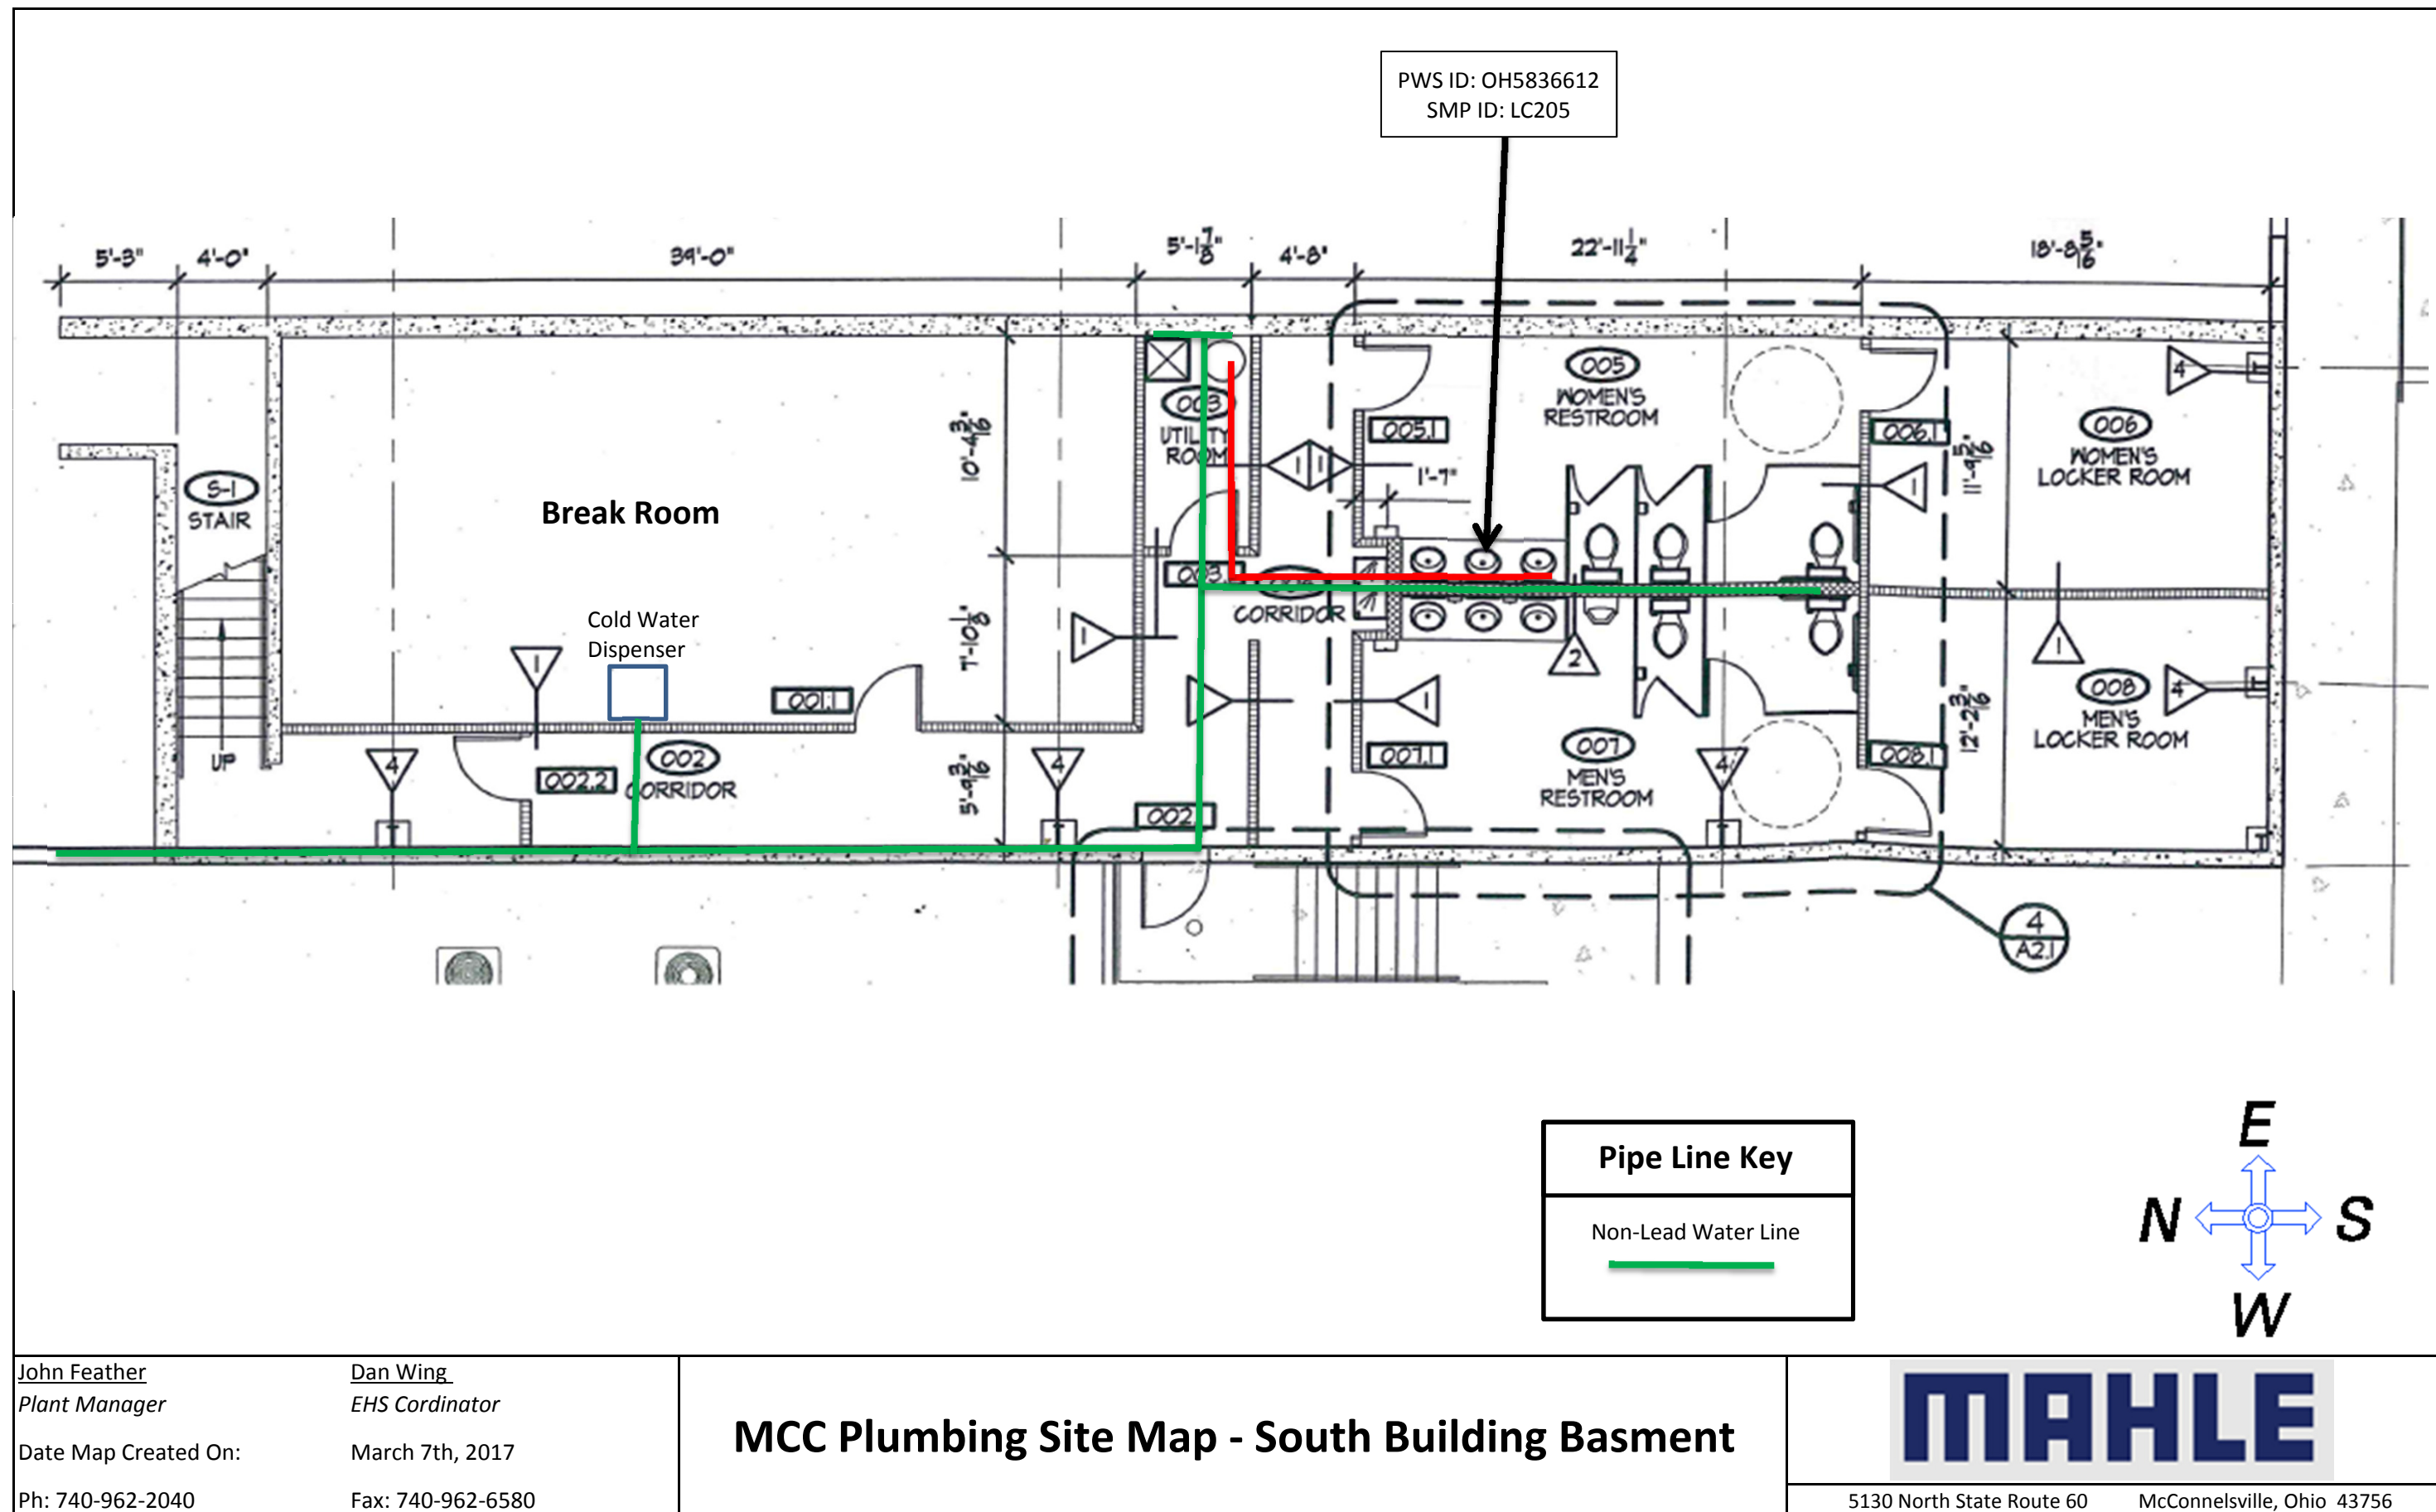

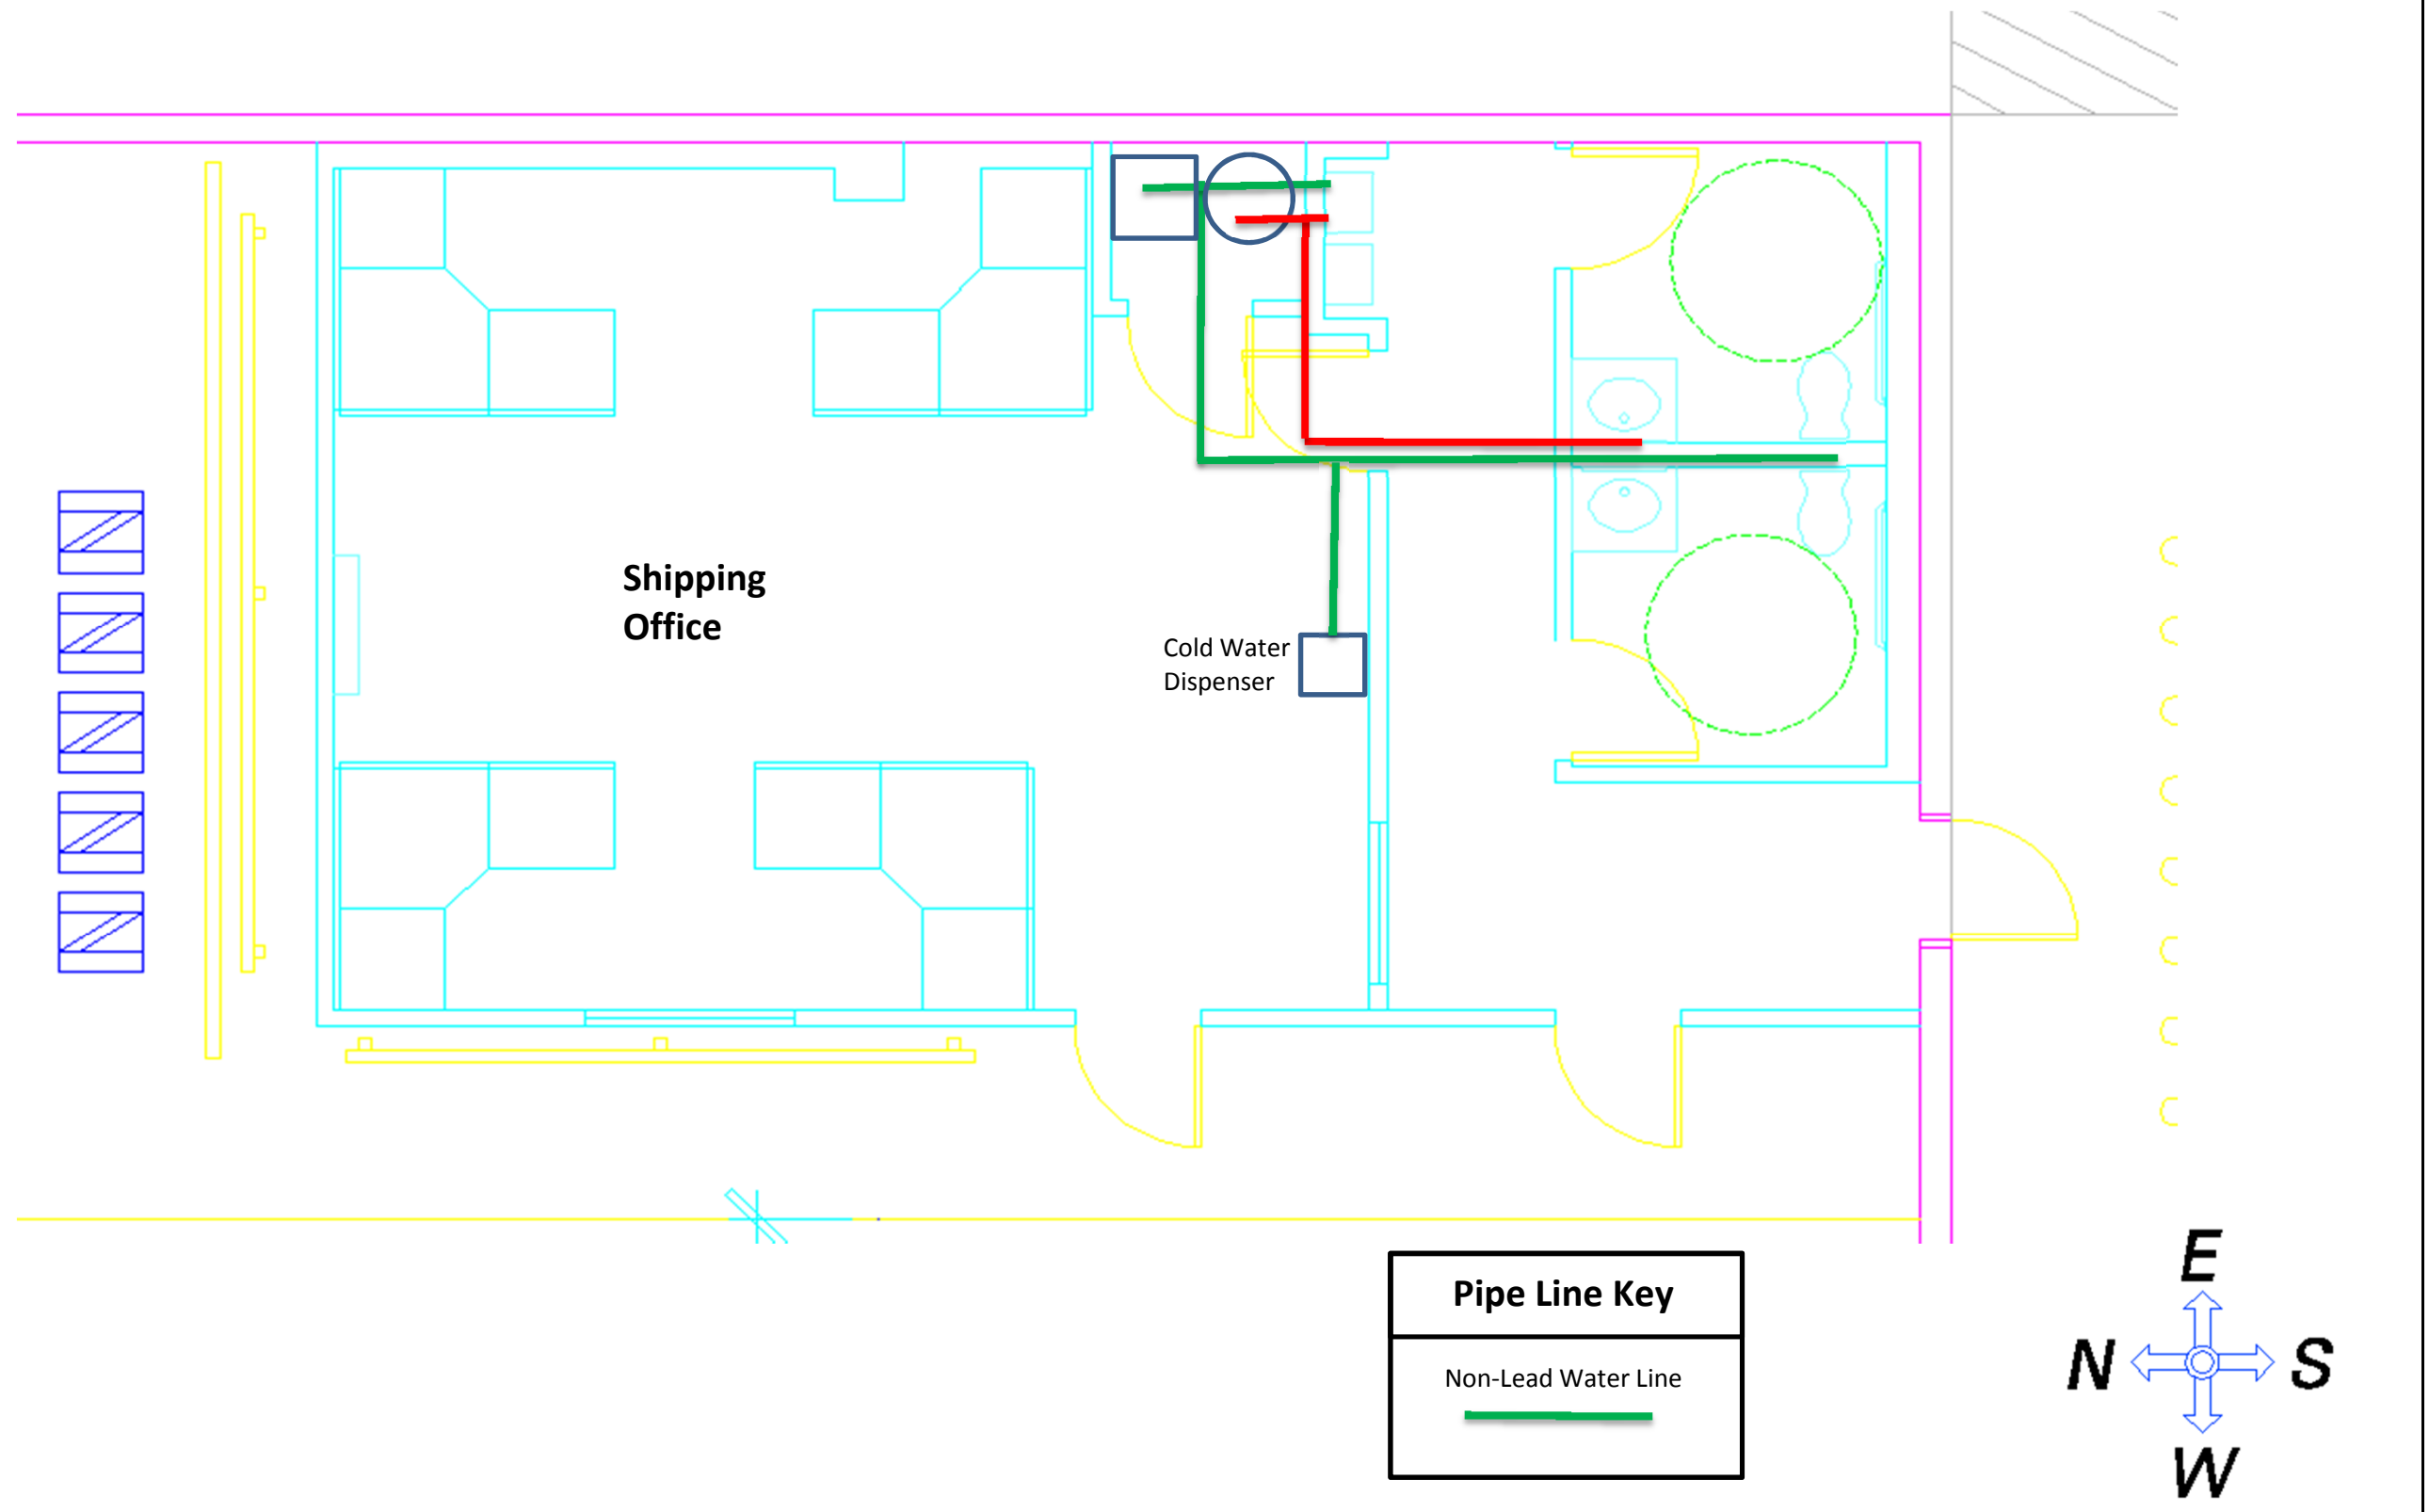

<u>John Feather</u> Plant Manager Date Map Created On: Ph: 740-962-2040	<u>Dan Wing</u> EHS Cordinator March 7th, 2017 Fax: 740-962-6580	MCC Plumbing Site Map - South Building Basment	<div data-bbox="2284 1703 2781 1824">MAHLE</div> <div data-bbox="2222 1834 2874 1874">5130 North State Route 60 McConnelsville, Ohio 43756</div>
--	---	---	--

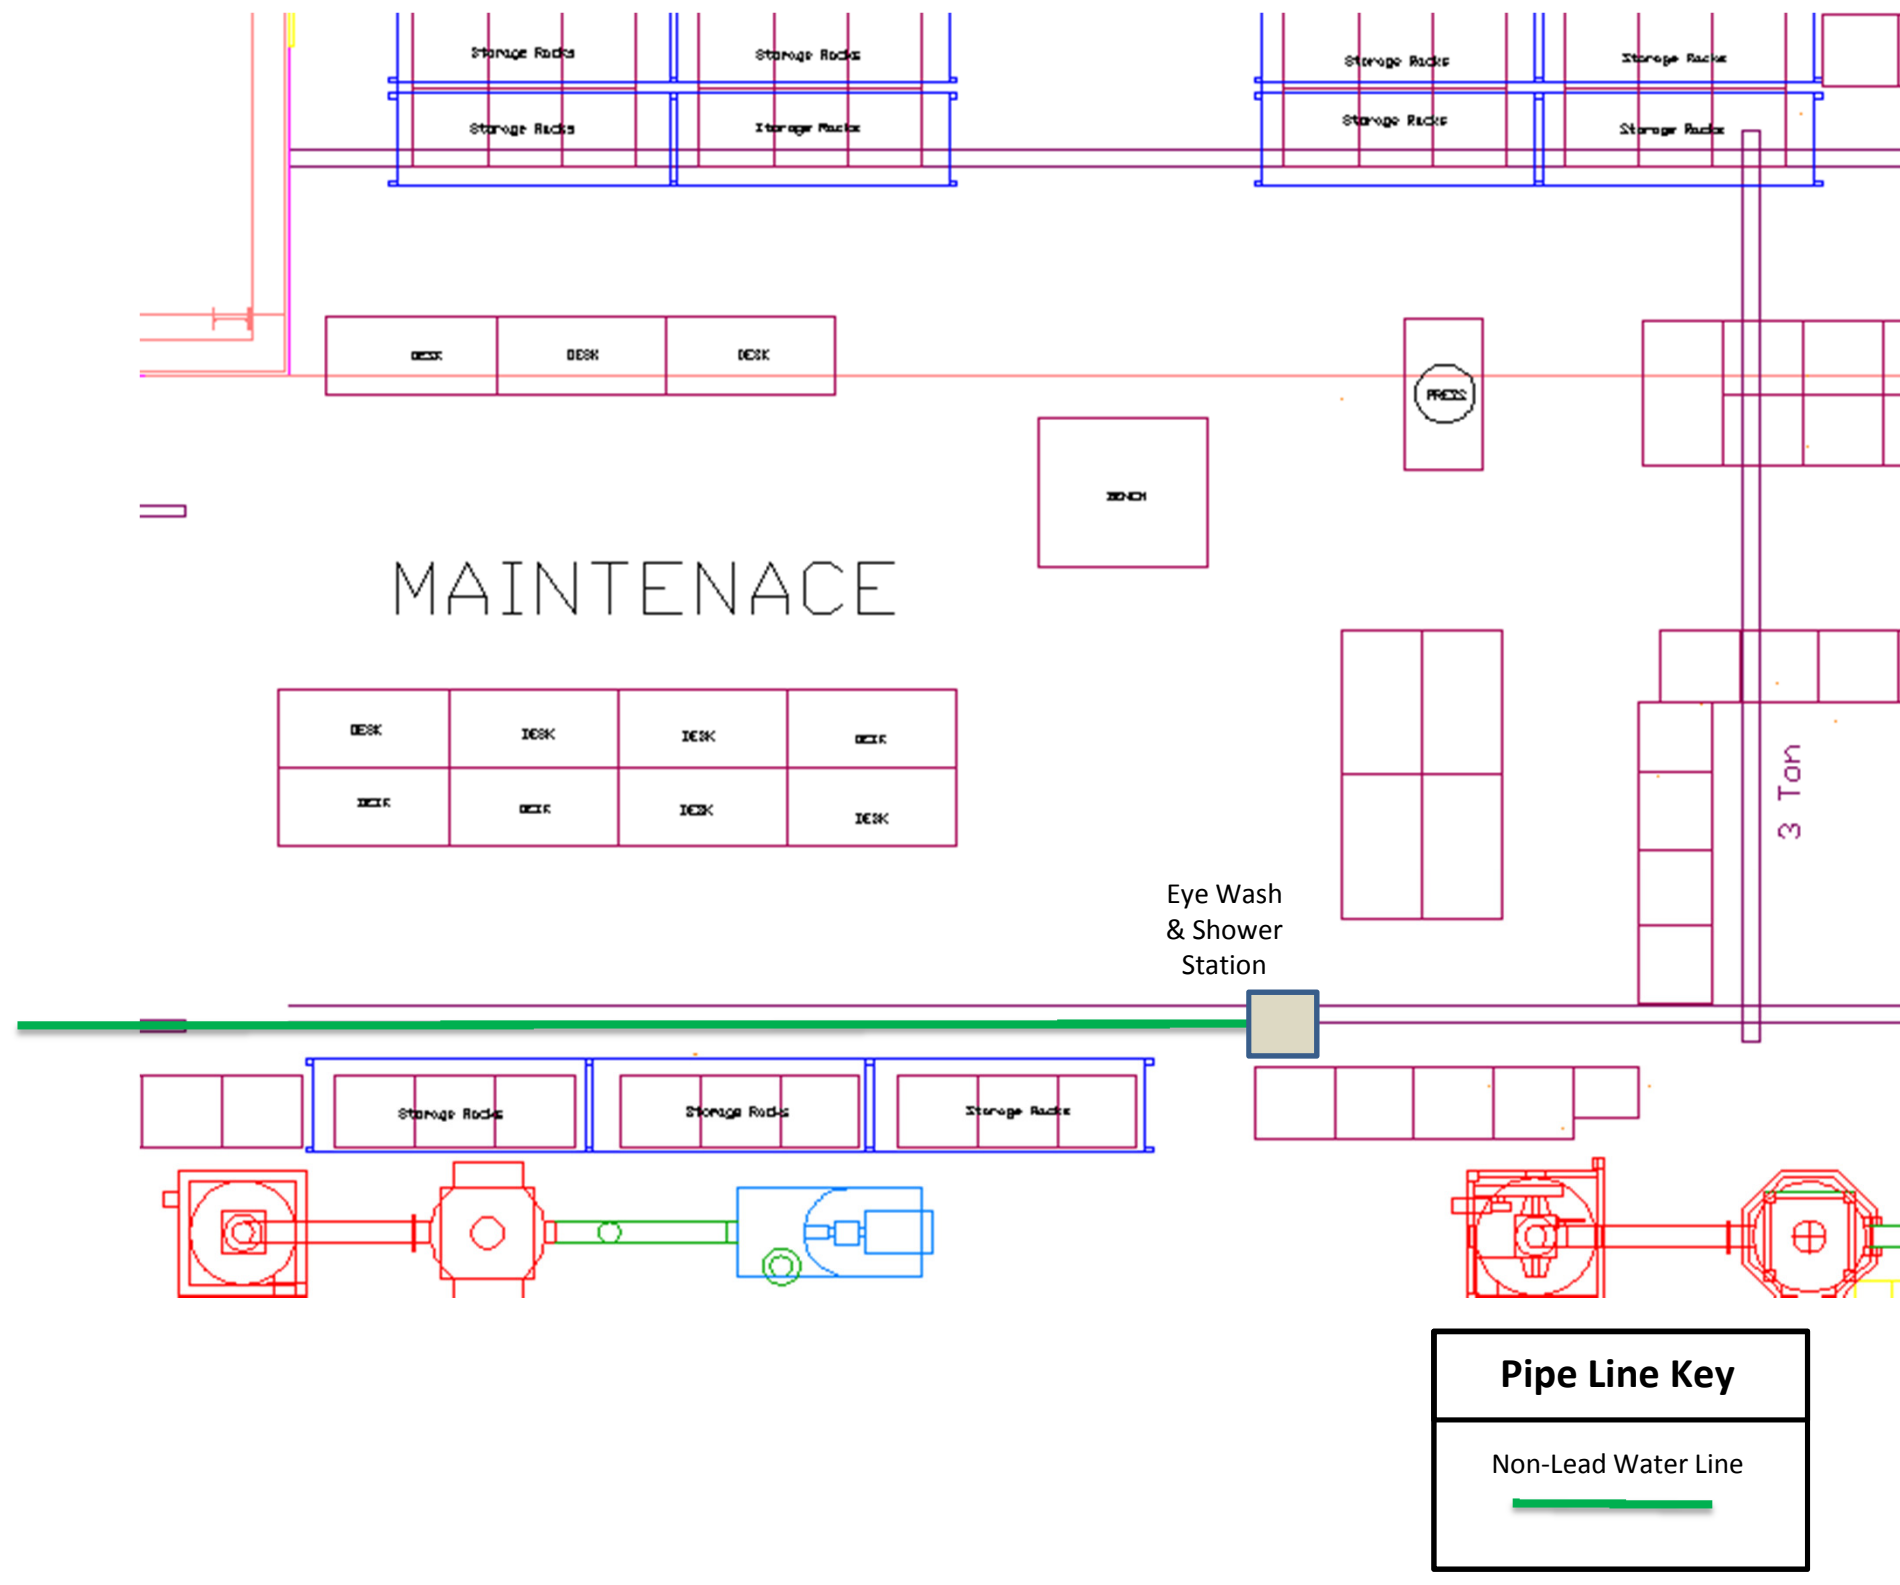

John Feather
Plant Manager

Dan Wing
EHS Cordinator

Date Map Created On:

March 7th, 2017

Ph: 740-962-2040




Fax: 740-962-6580

MCC Plumbing Site Map - South Building Maintenance

MAHLE

5130 North State Route 60

McConnelsville, Ohio 43756

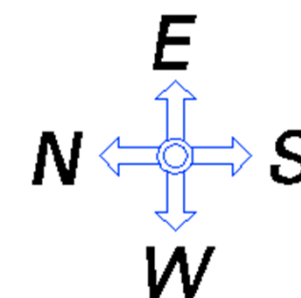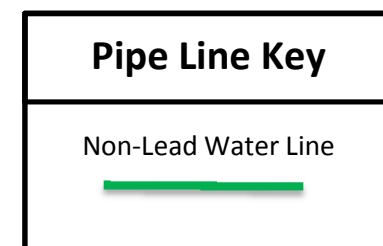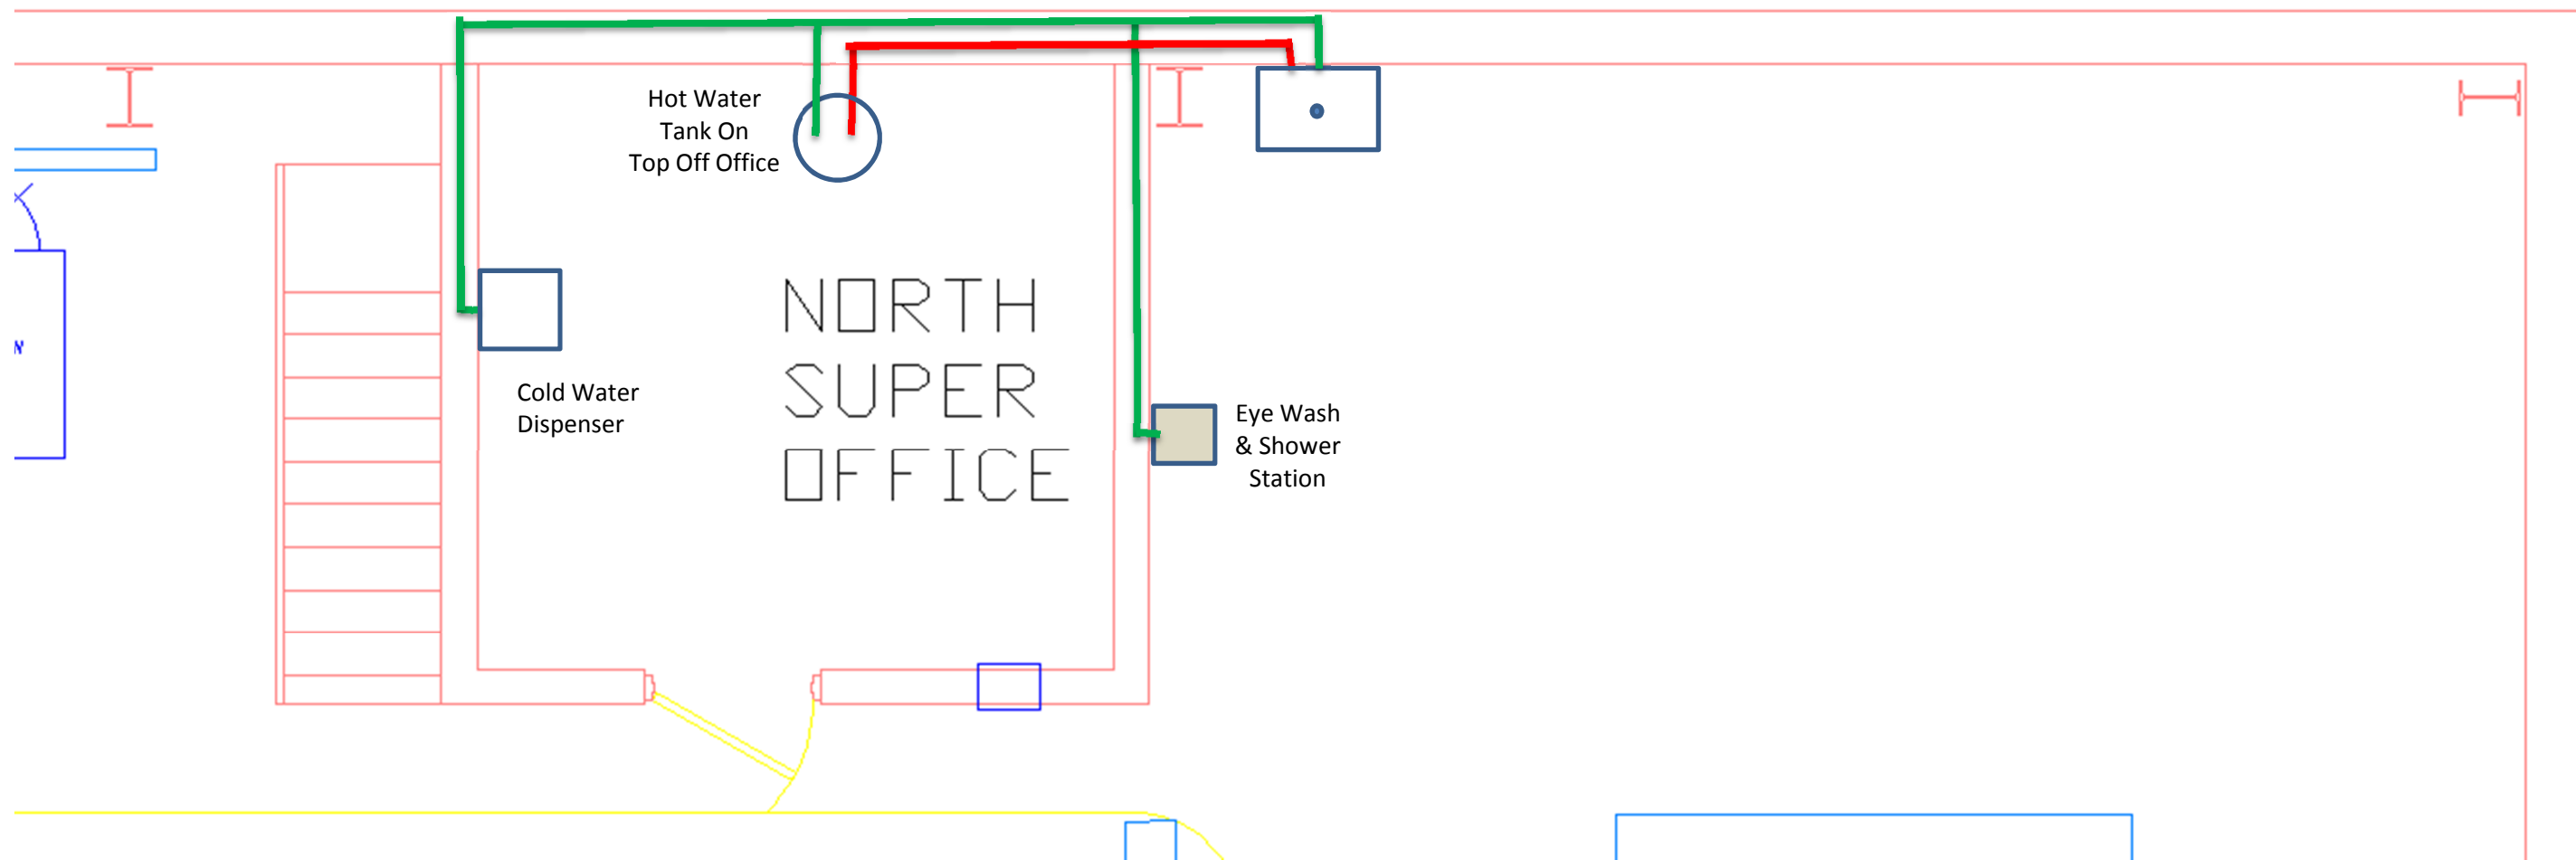

John Feather
Plant Manager

Dan Wing
EHS Cordinator

Date Map Created On:

March 7th, 2017

Ph: 740-962-2040




Fax: 740-962-6580

MCC Plumbing Site Map - North Building Supervisor

MAHLE

5130 North State Route 60

McConnelsville, Ohio 43756

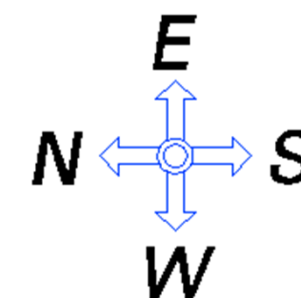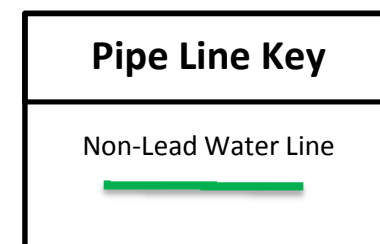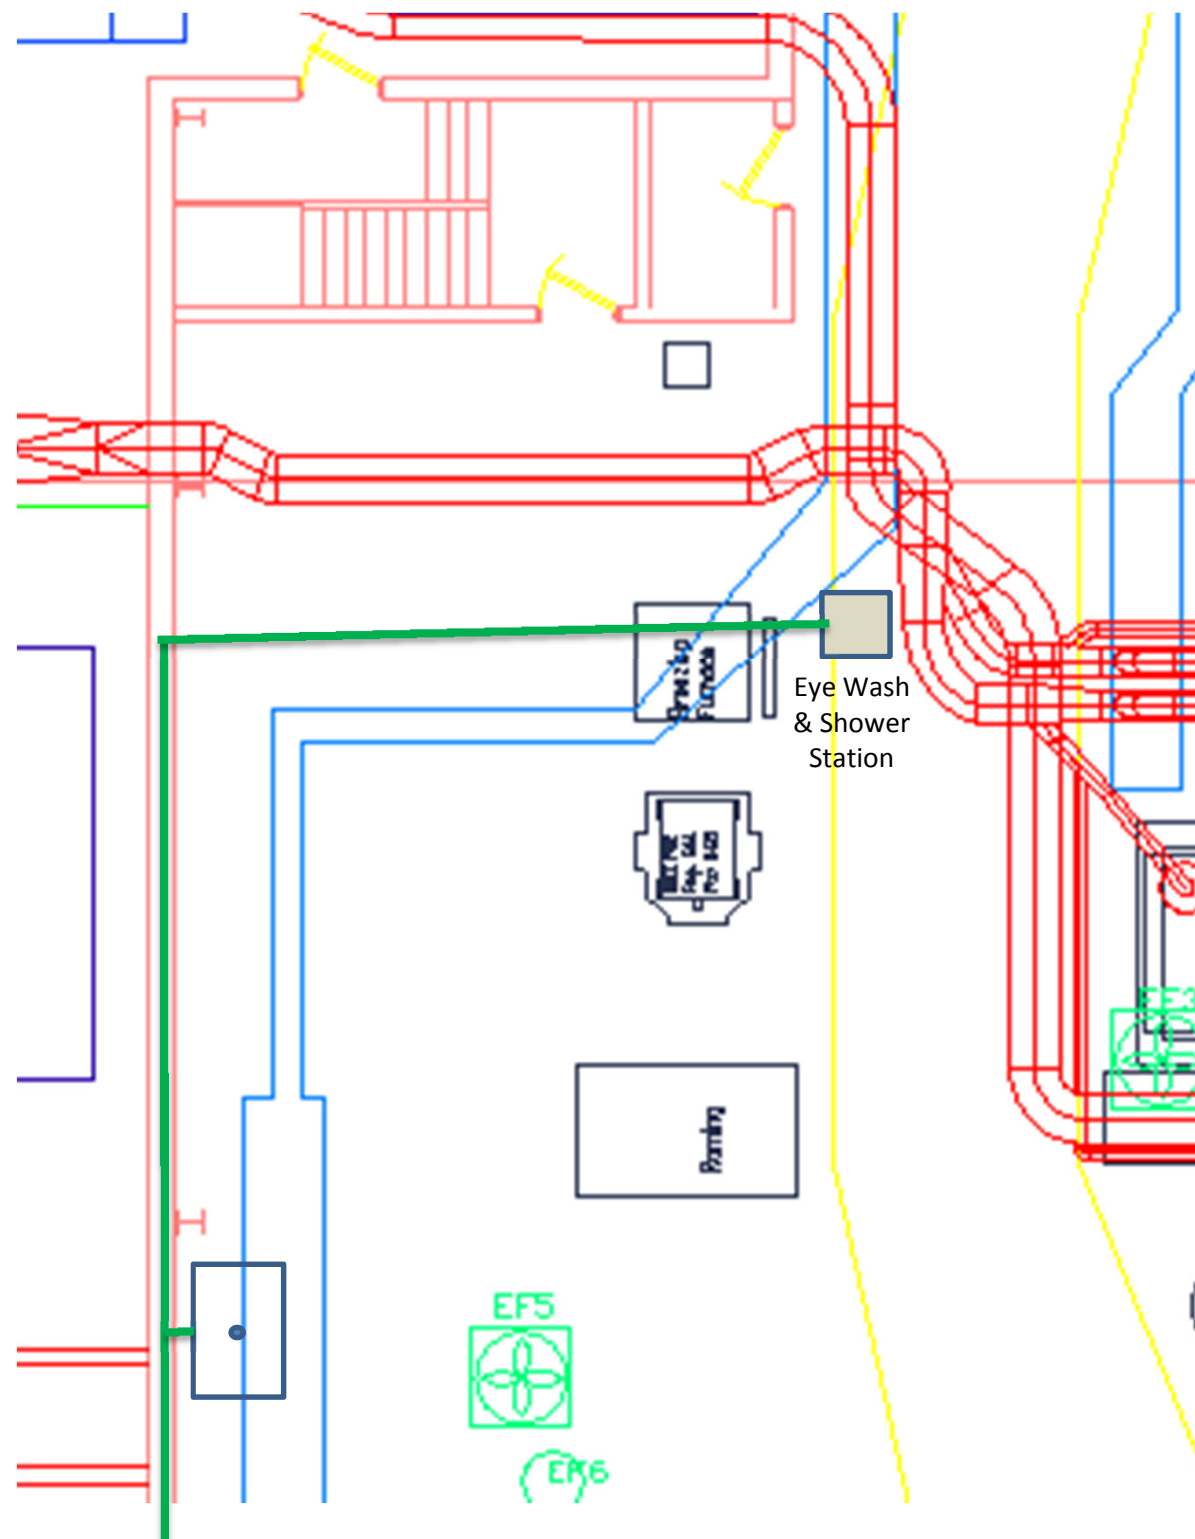

John Feather
Plant Manager

Dan Wing
EHS Coordinator

Date Map Created On:

March 7th, 2017

Ph: 740-962-2040





Fax: 740-962-6580

MCC Plumbing Site Map - North Building Furnace Repair




MAHLE

5130 North State Route 60

McConnelsville, Ohio 43756

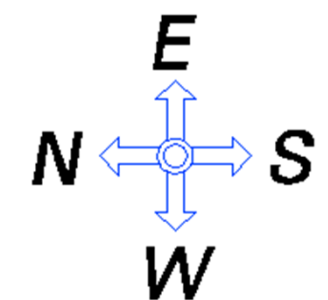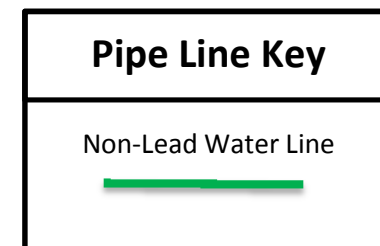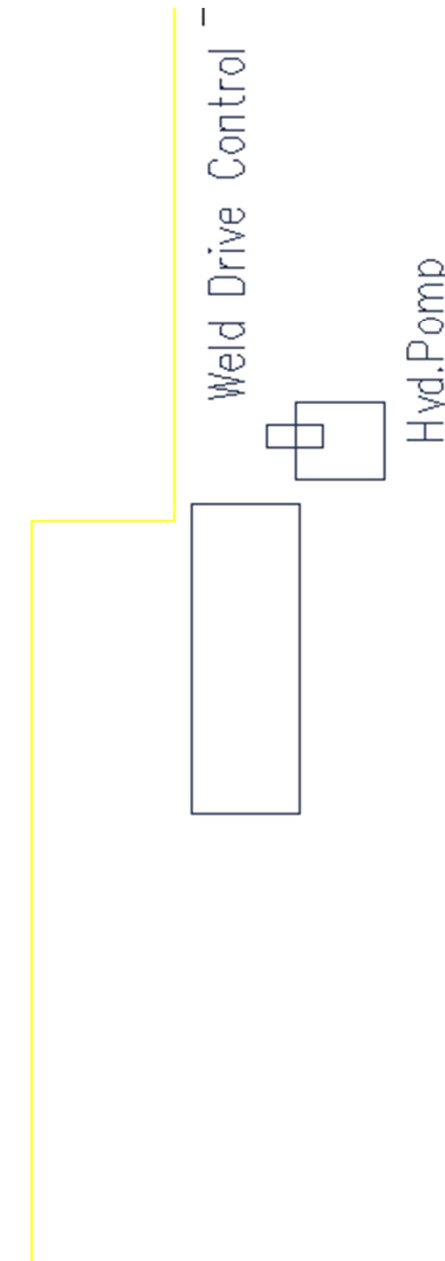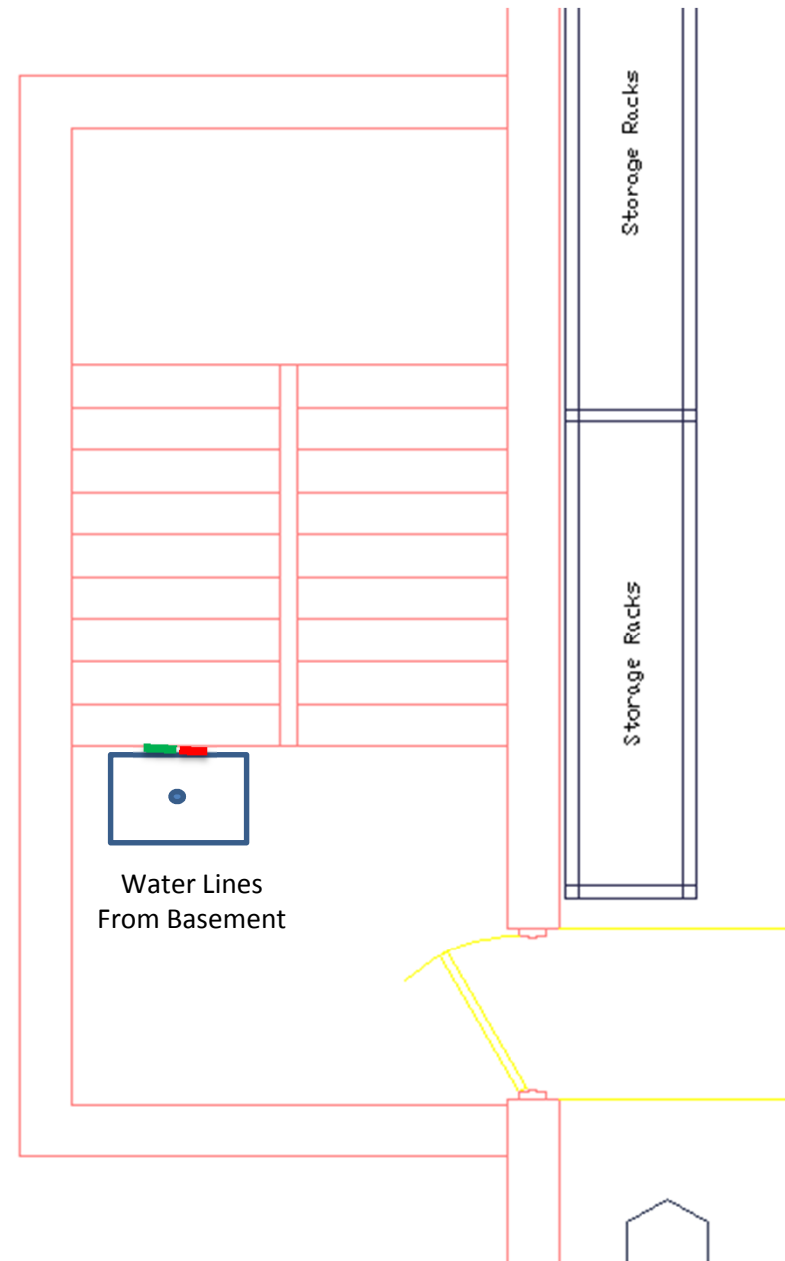

<u>John Feather</u> Plant Manager Date Map Created On: Ph: 740-962-2040	<u>Dan Wing</u> EHS Cordinator March 7th, 2017 Fax: 740-962-6580	MCC Plumbing Site Map - North Building Stairwell	<div data-bbox="2271 1695 2790 1830" data-label="Image"> </div> <div data-bbox="2216 1836 2868 1870" data-label="Text"> 5130 North State Route 60 McConnelsville, Ohio 43756 </div>

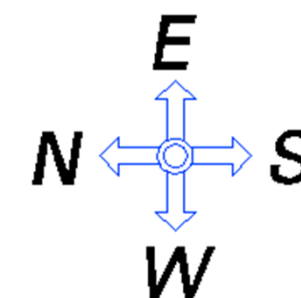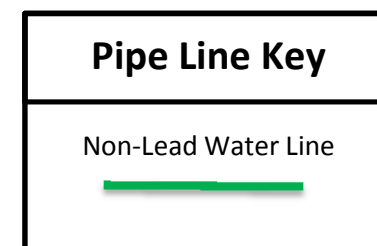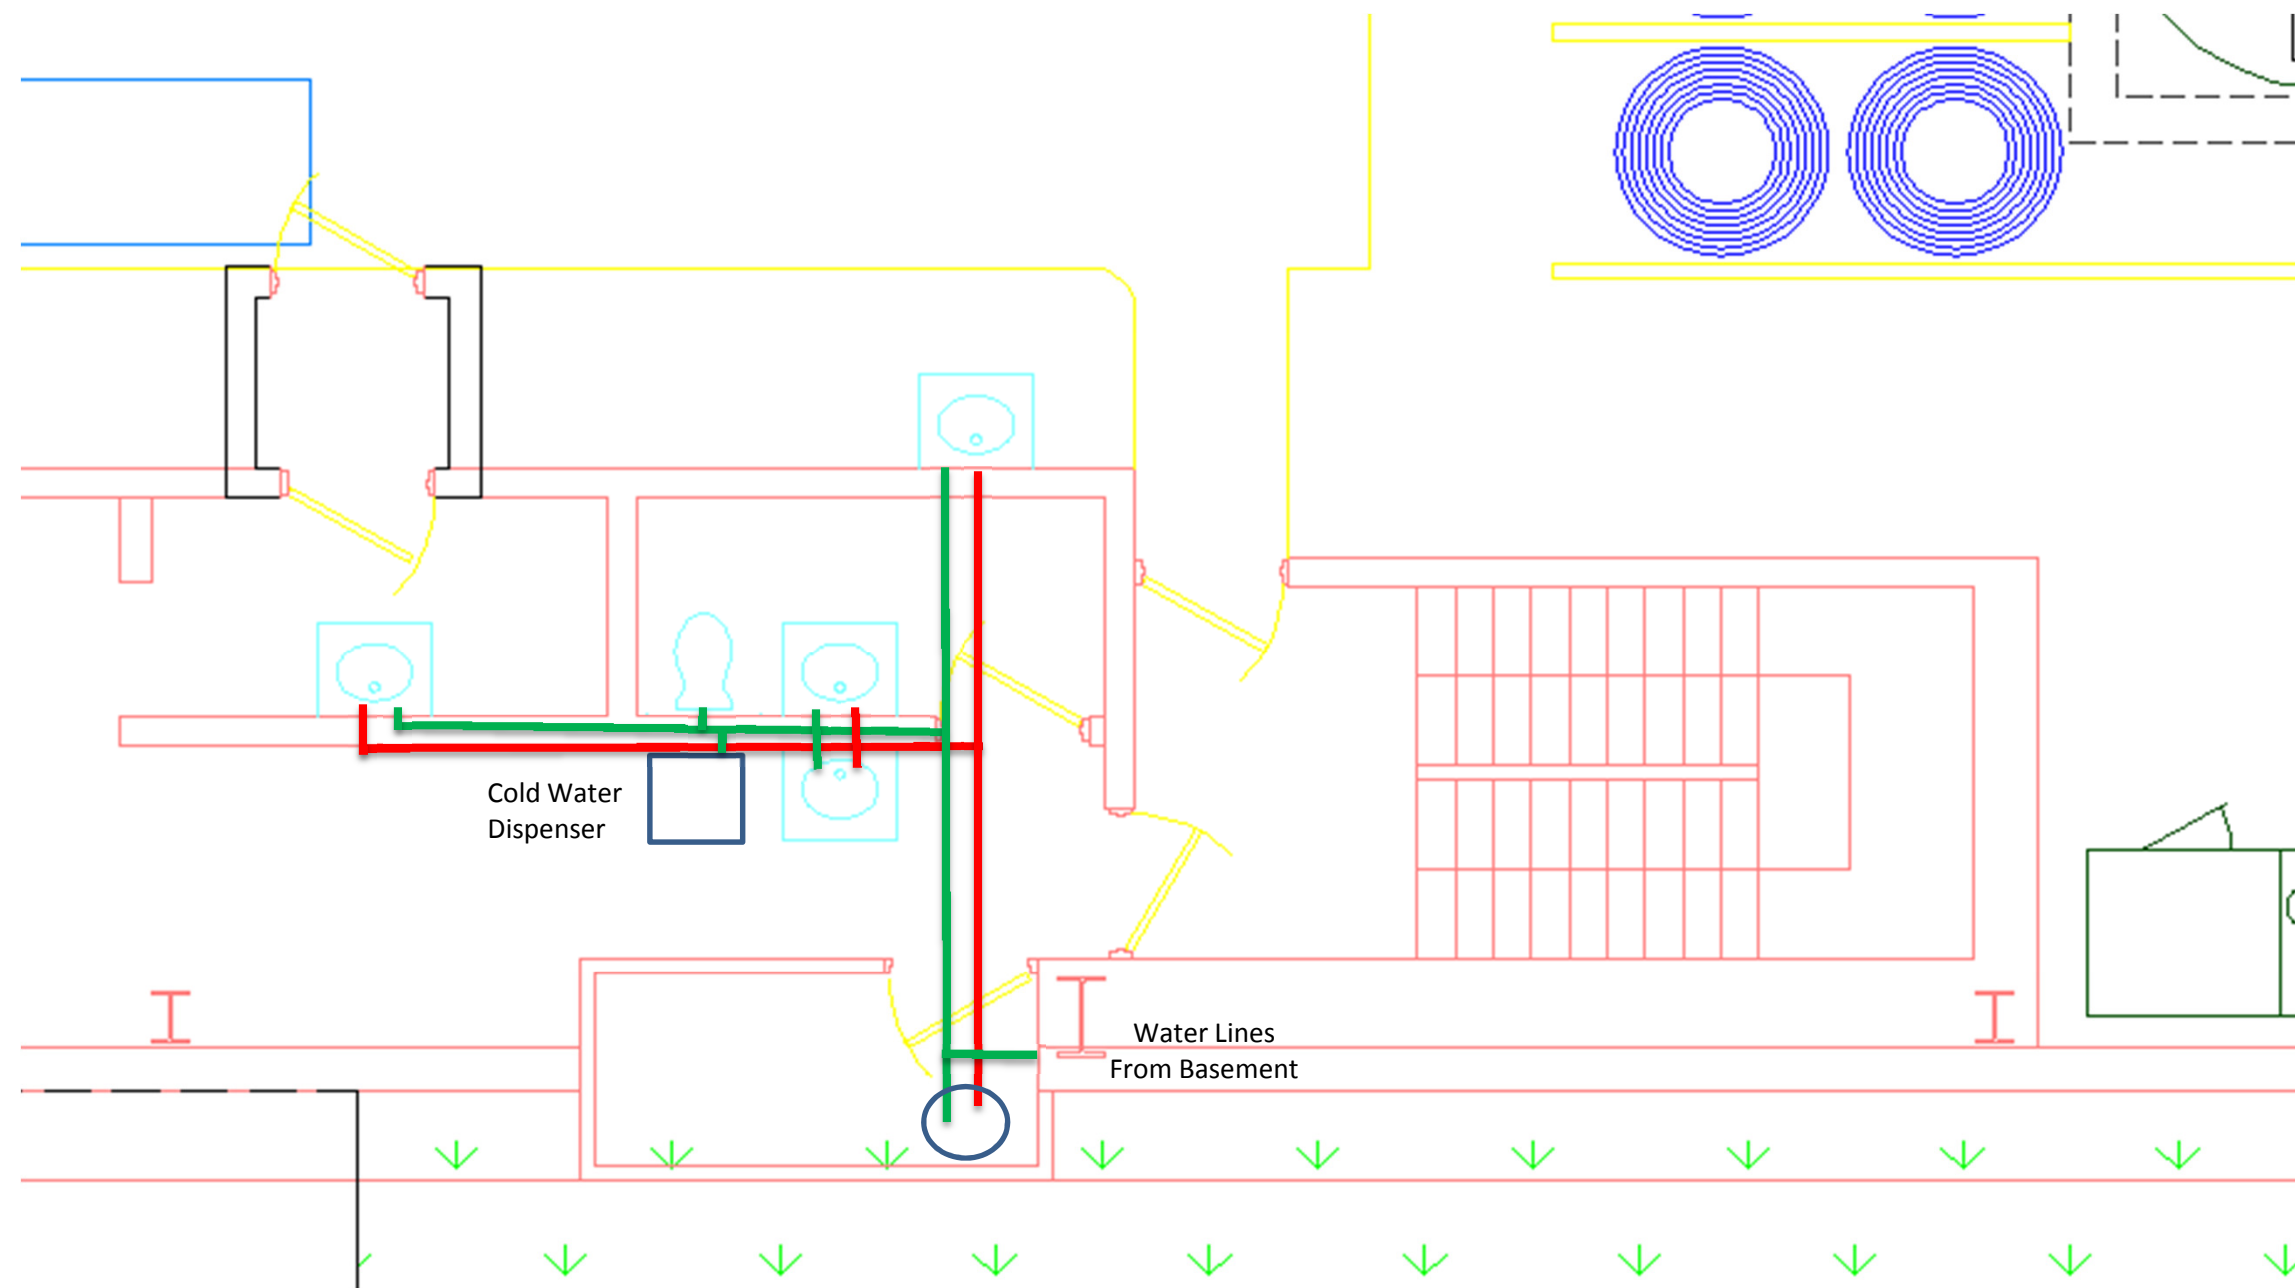

John Feather
Plant Manager

Dan Wing
EHS Coordinator

Date Map Created On:

March 7th, 2017

Ph: 740-962-2040


Fax: 740-962-6580

MCC Plumbing Site Map - North Building Decon #1

MAHLE


5130 North State Route 60

McConnelsville, Ohio 43756

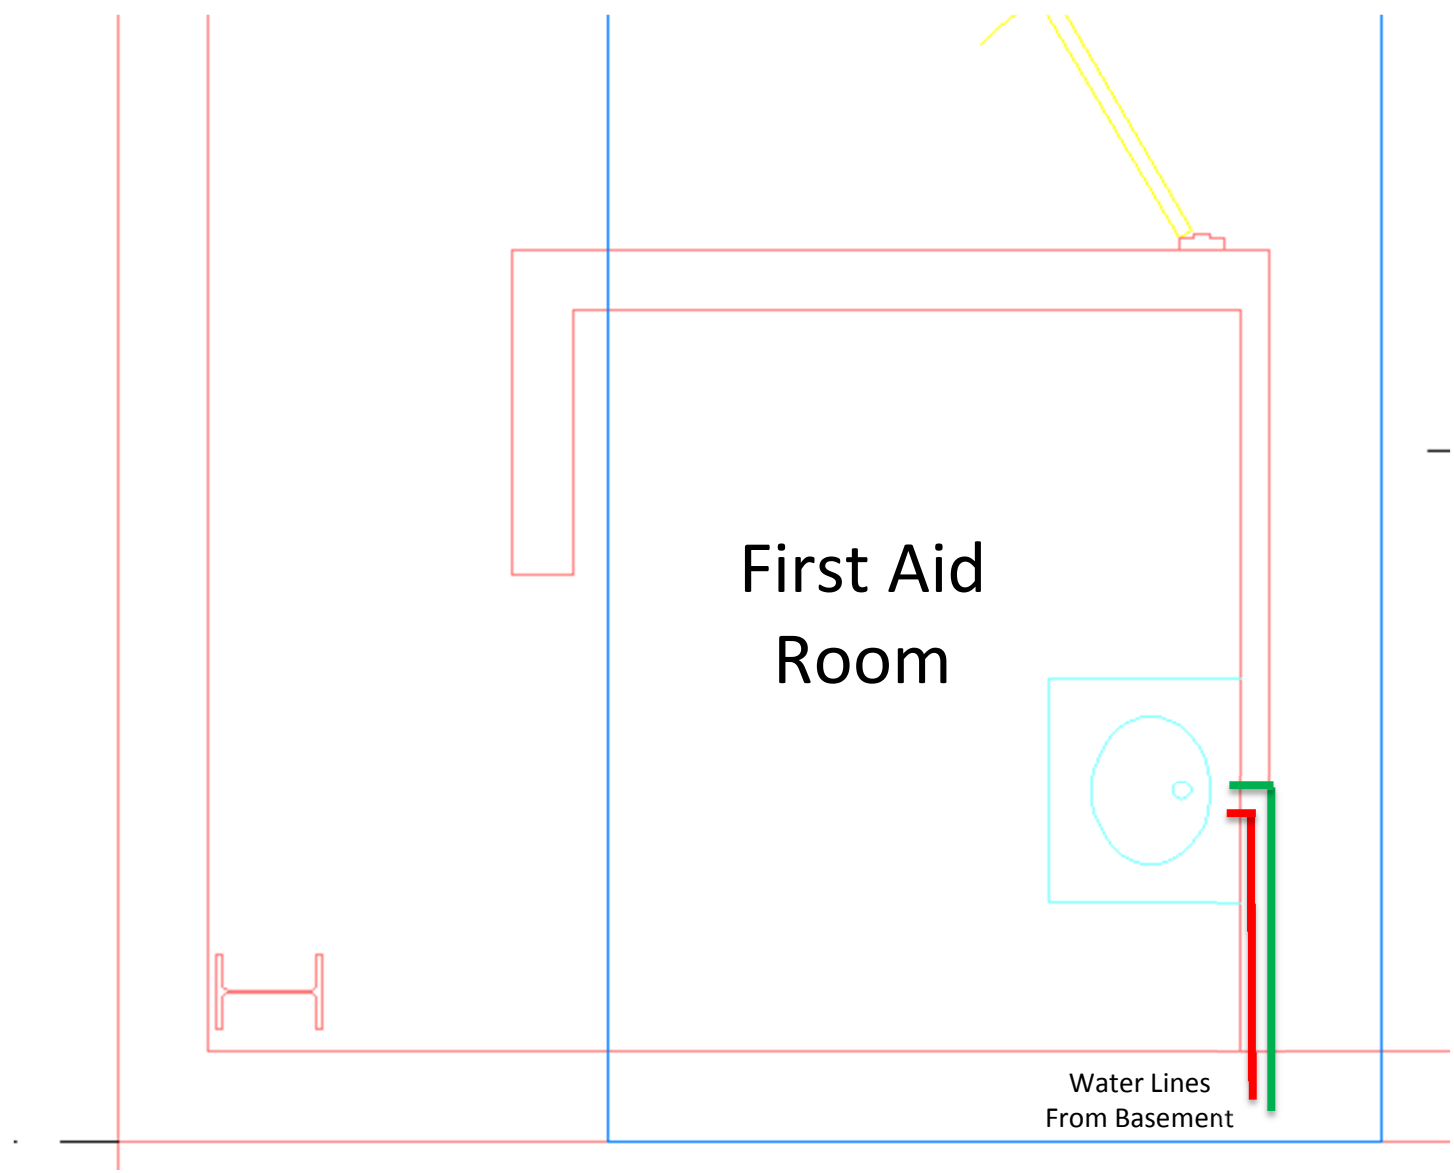



Pipe Line Key

Non-Lead Water Line

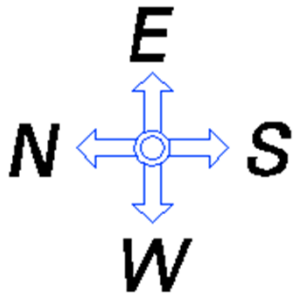


<u>John Feather</u> <i>Plant Manager</i> Date Map Created On: Ph: 740-962-2040	<u>Dan Wing</u> <i>EHS Cordinator</i> March 7th, 2017 Fax: 740-962-6580	MCC Plumbing Site Map - North Building First Aid	<div></div> <div>5130 North State Route 60 McConnelsville, Ohio 43756</div>
---	--	---	--

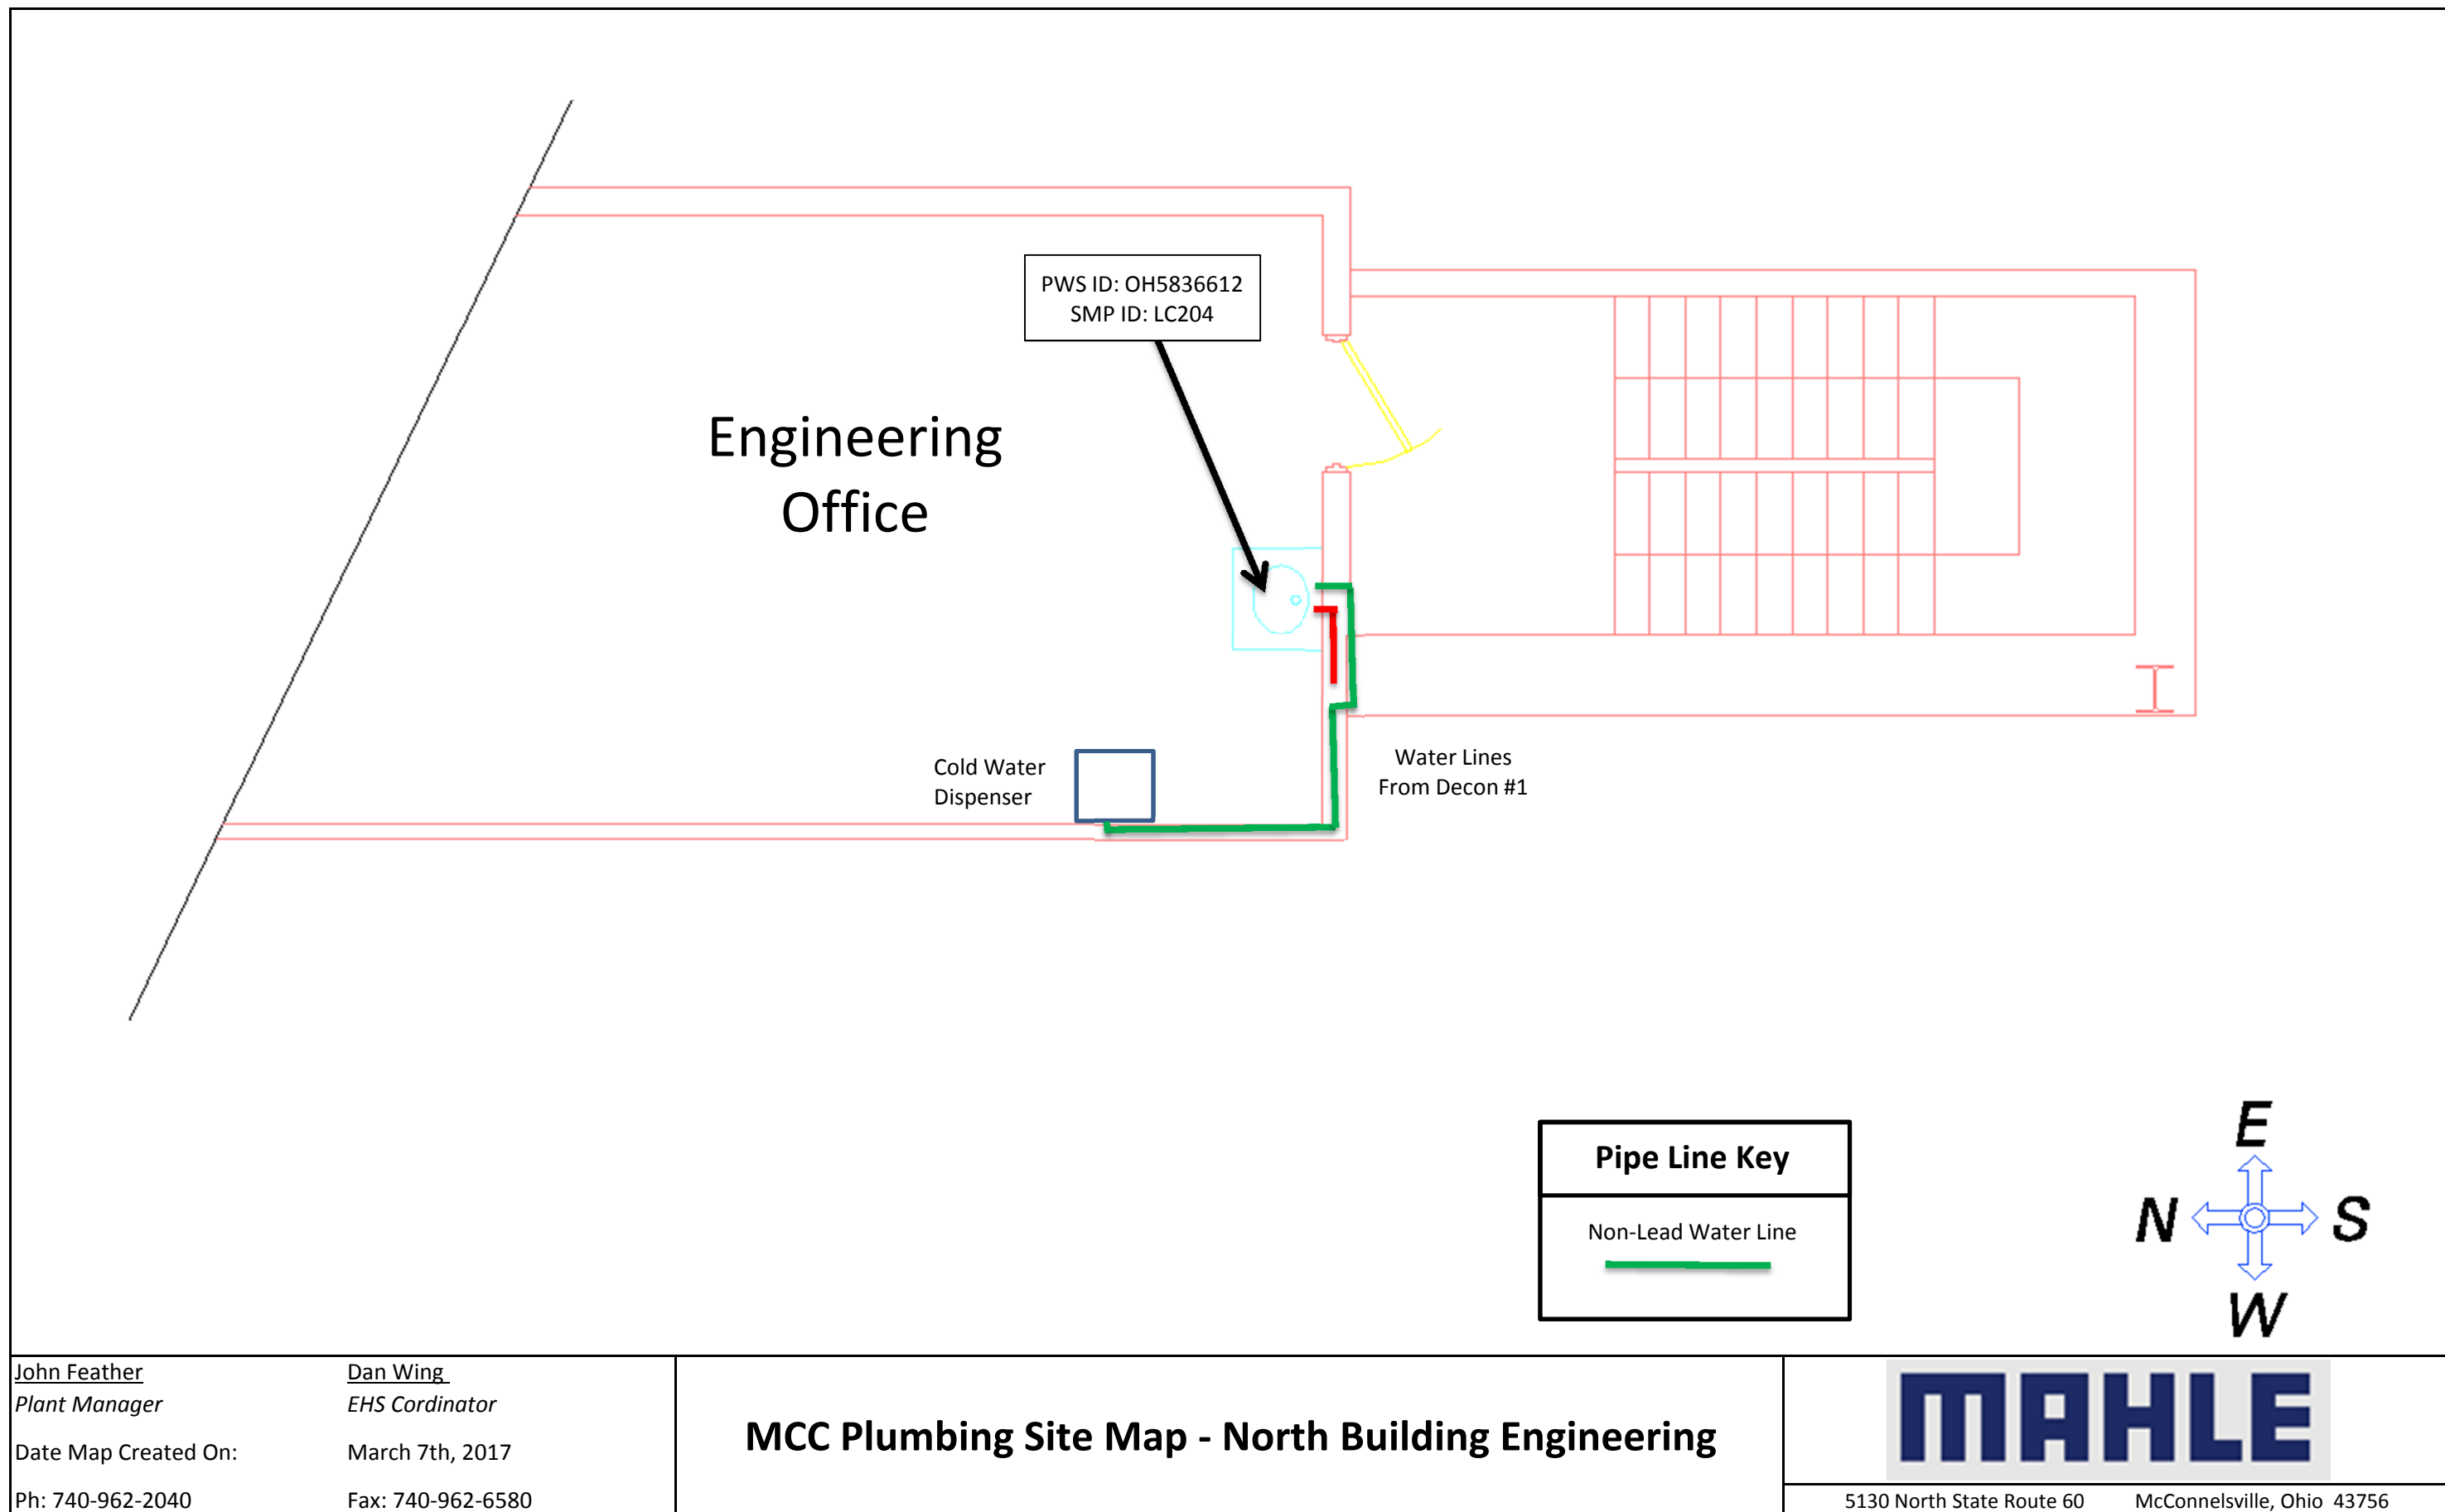

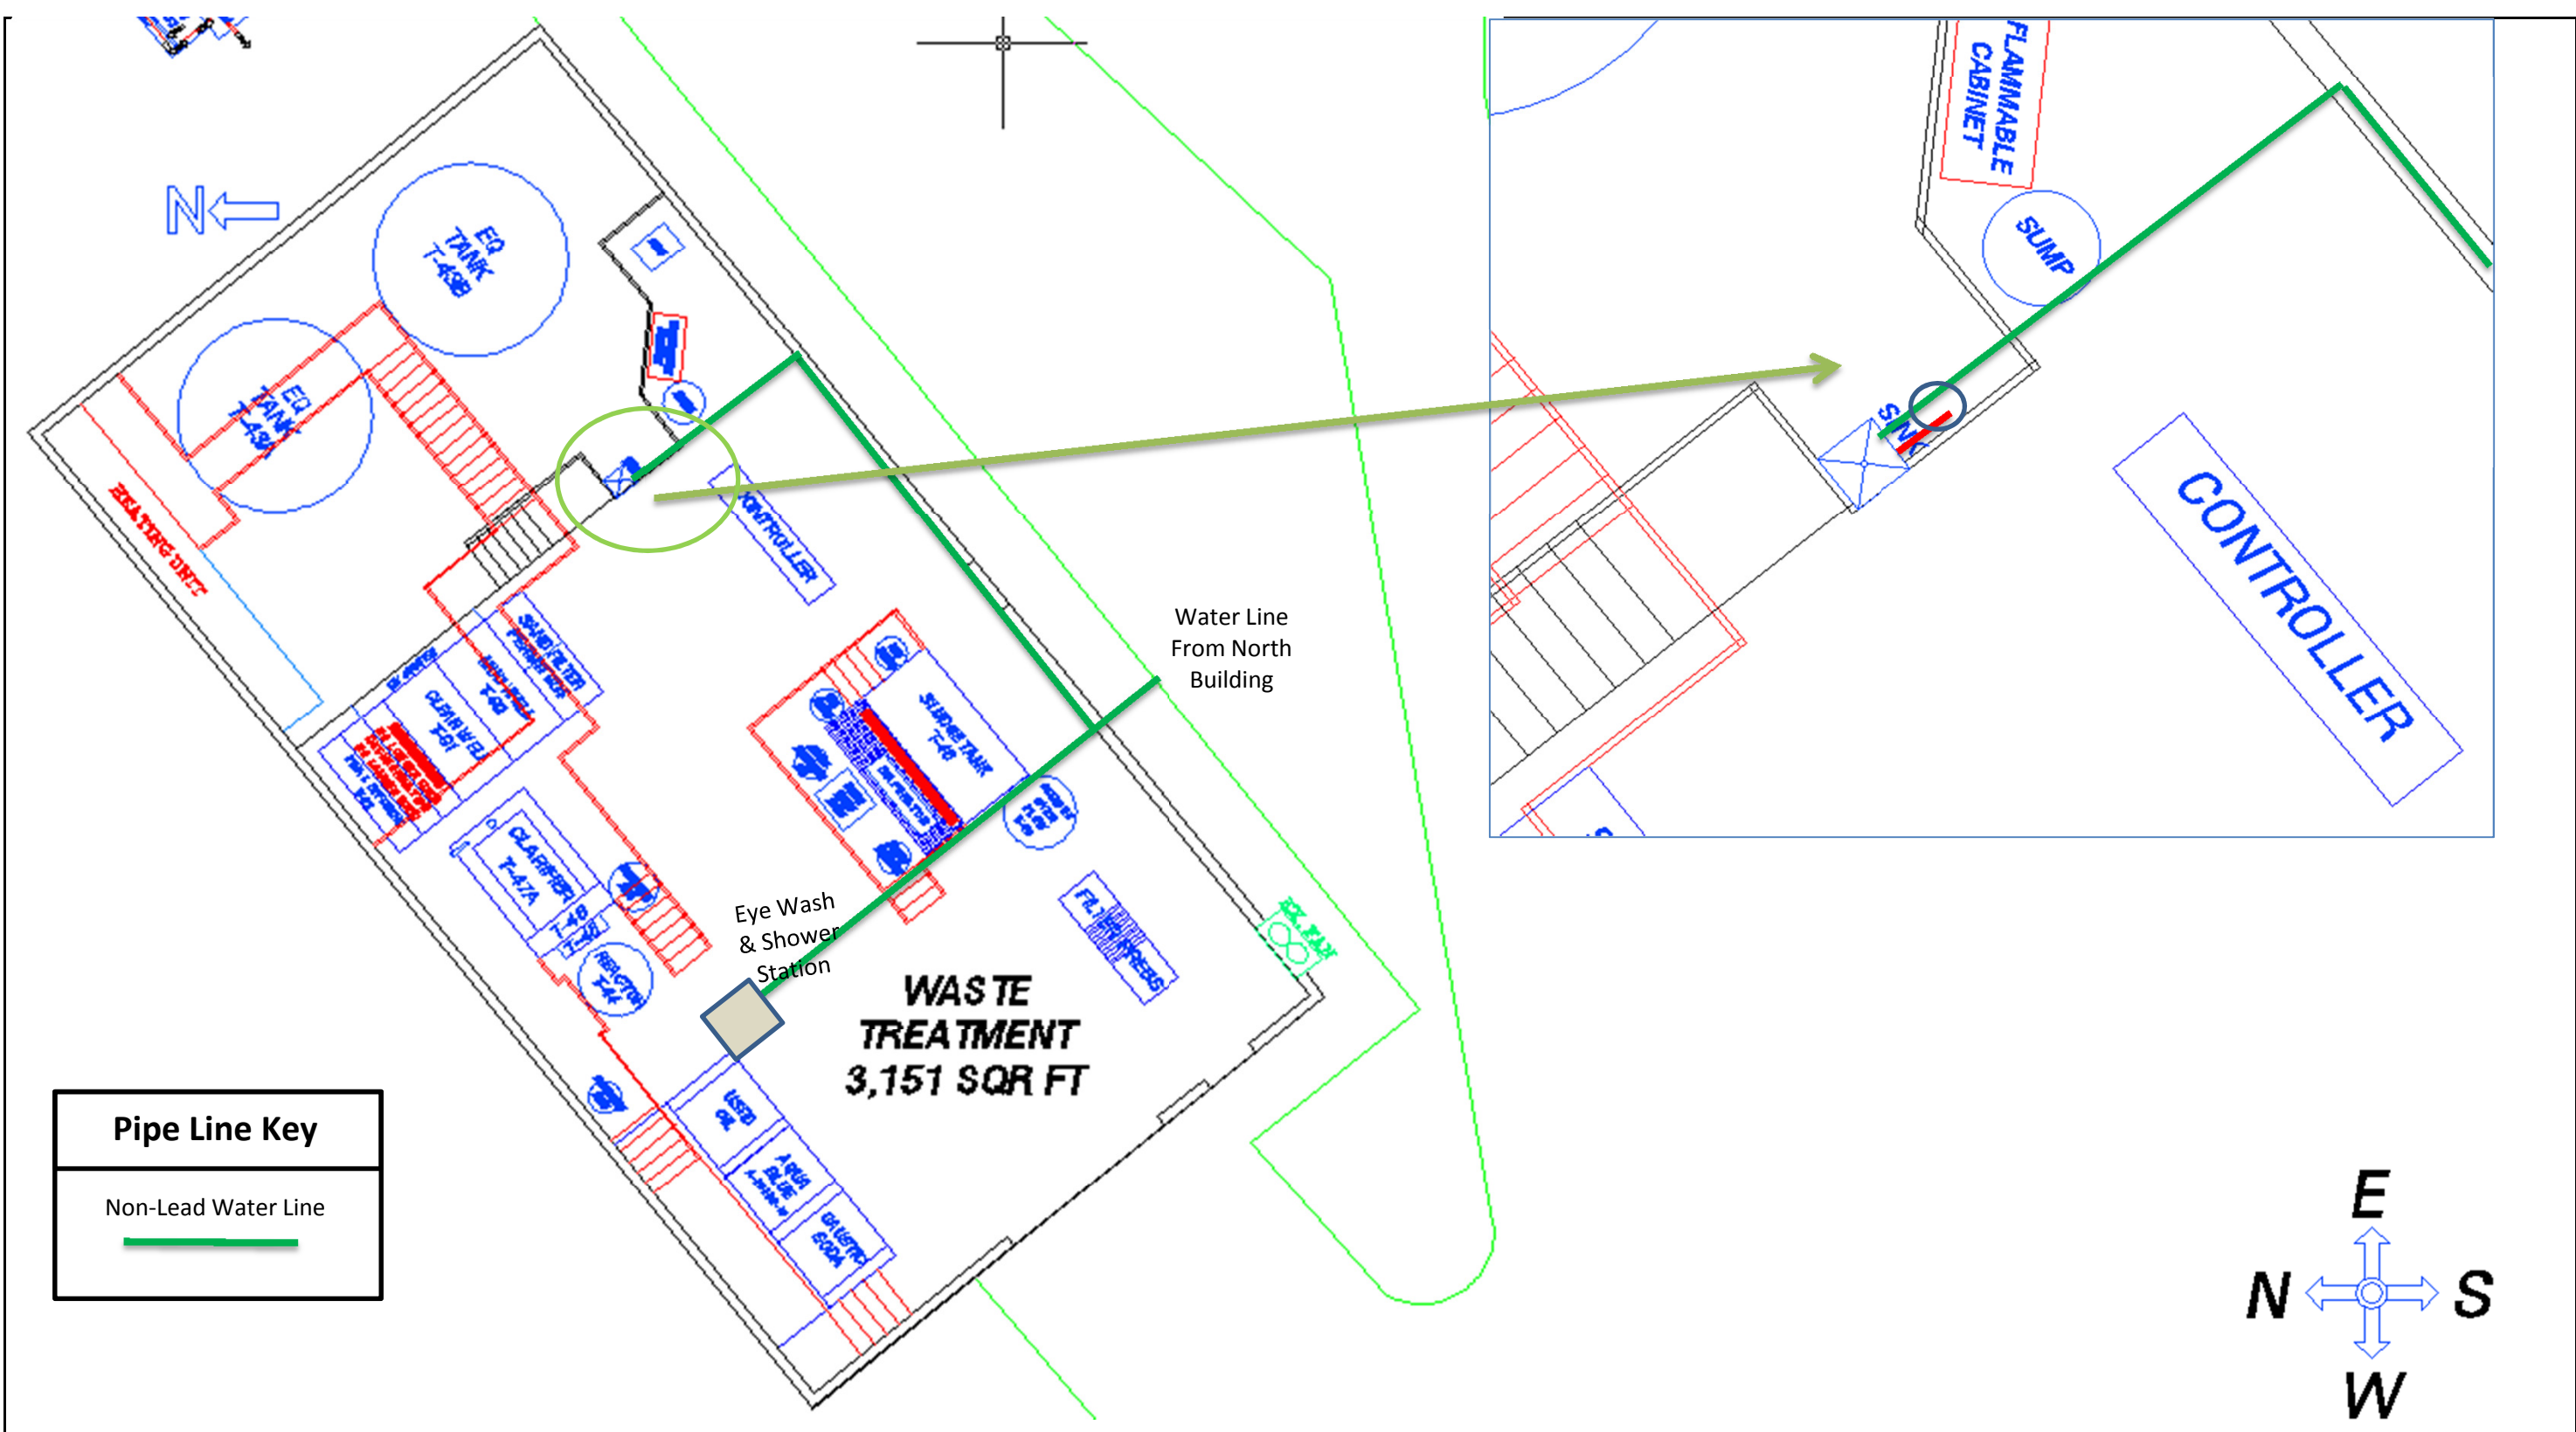

Pipe Line Key

Non-Lead Water Line

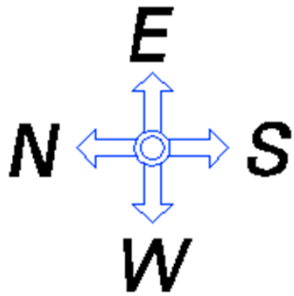


John Feather Plant Manager	Dan Wing EHS Coordinator
Date Map Created On:	March 7th, 2017
Ph: 740-962-2040	Fax: 740-962-6580

MCC Plumbing Site Map - Waste Treat



5130 North State Route 60 McConnelsville, Ohio 43756

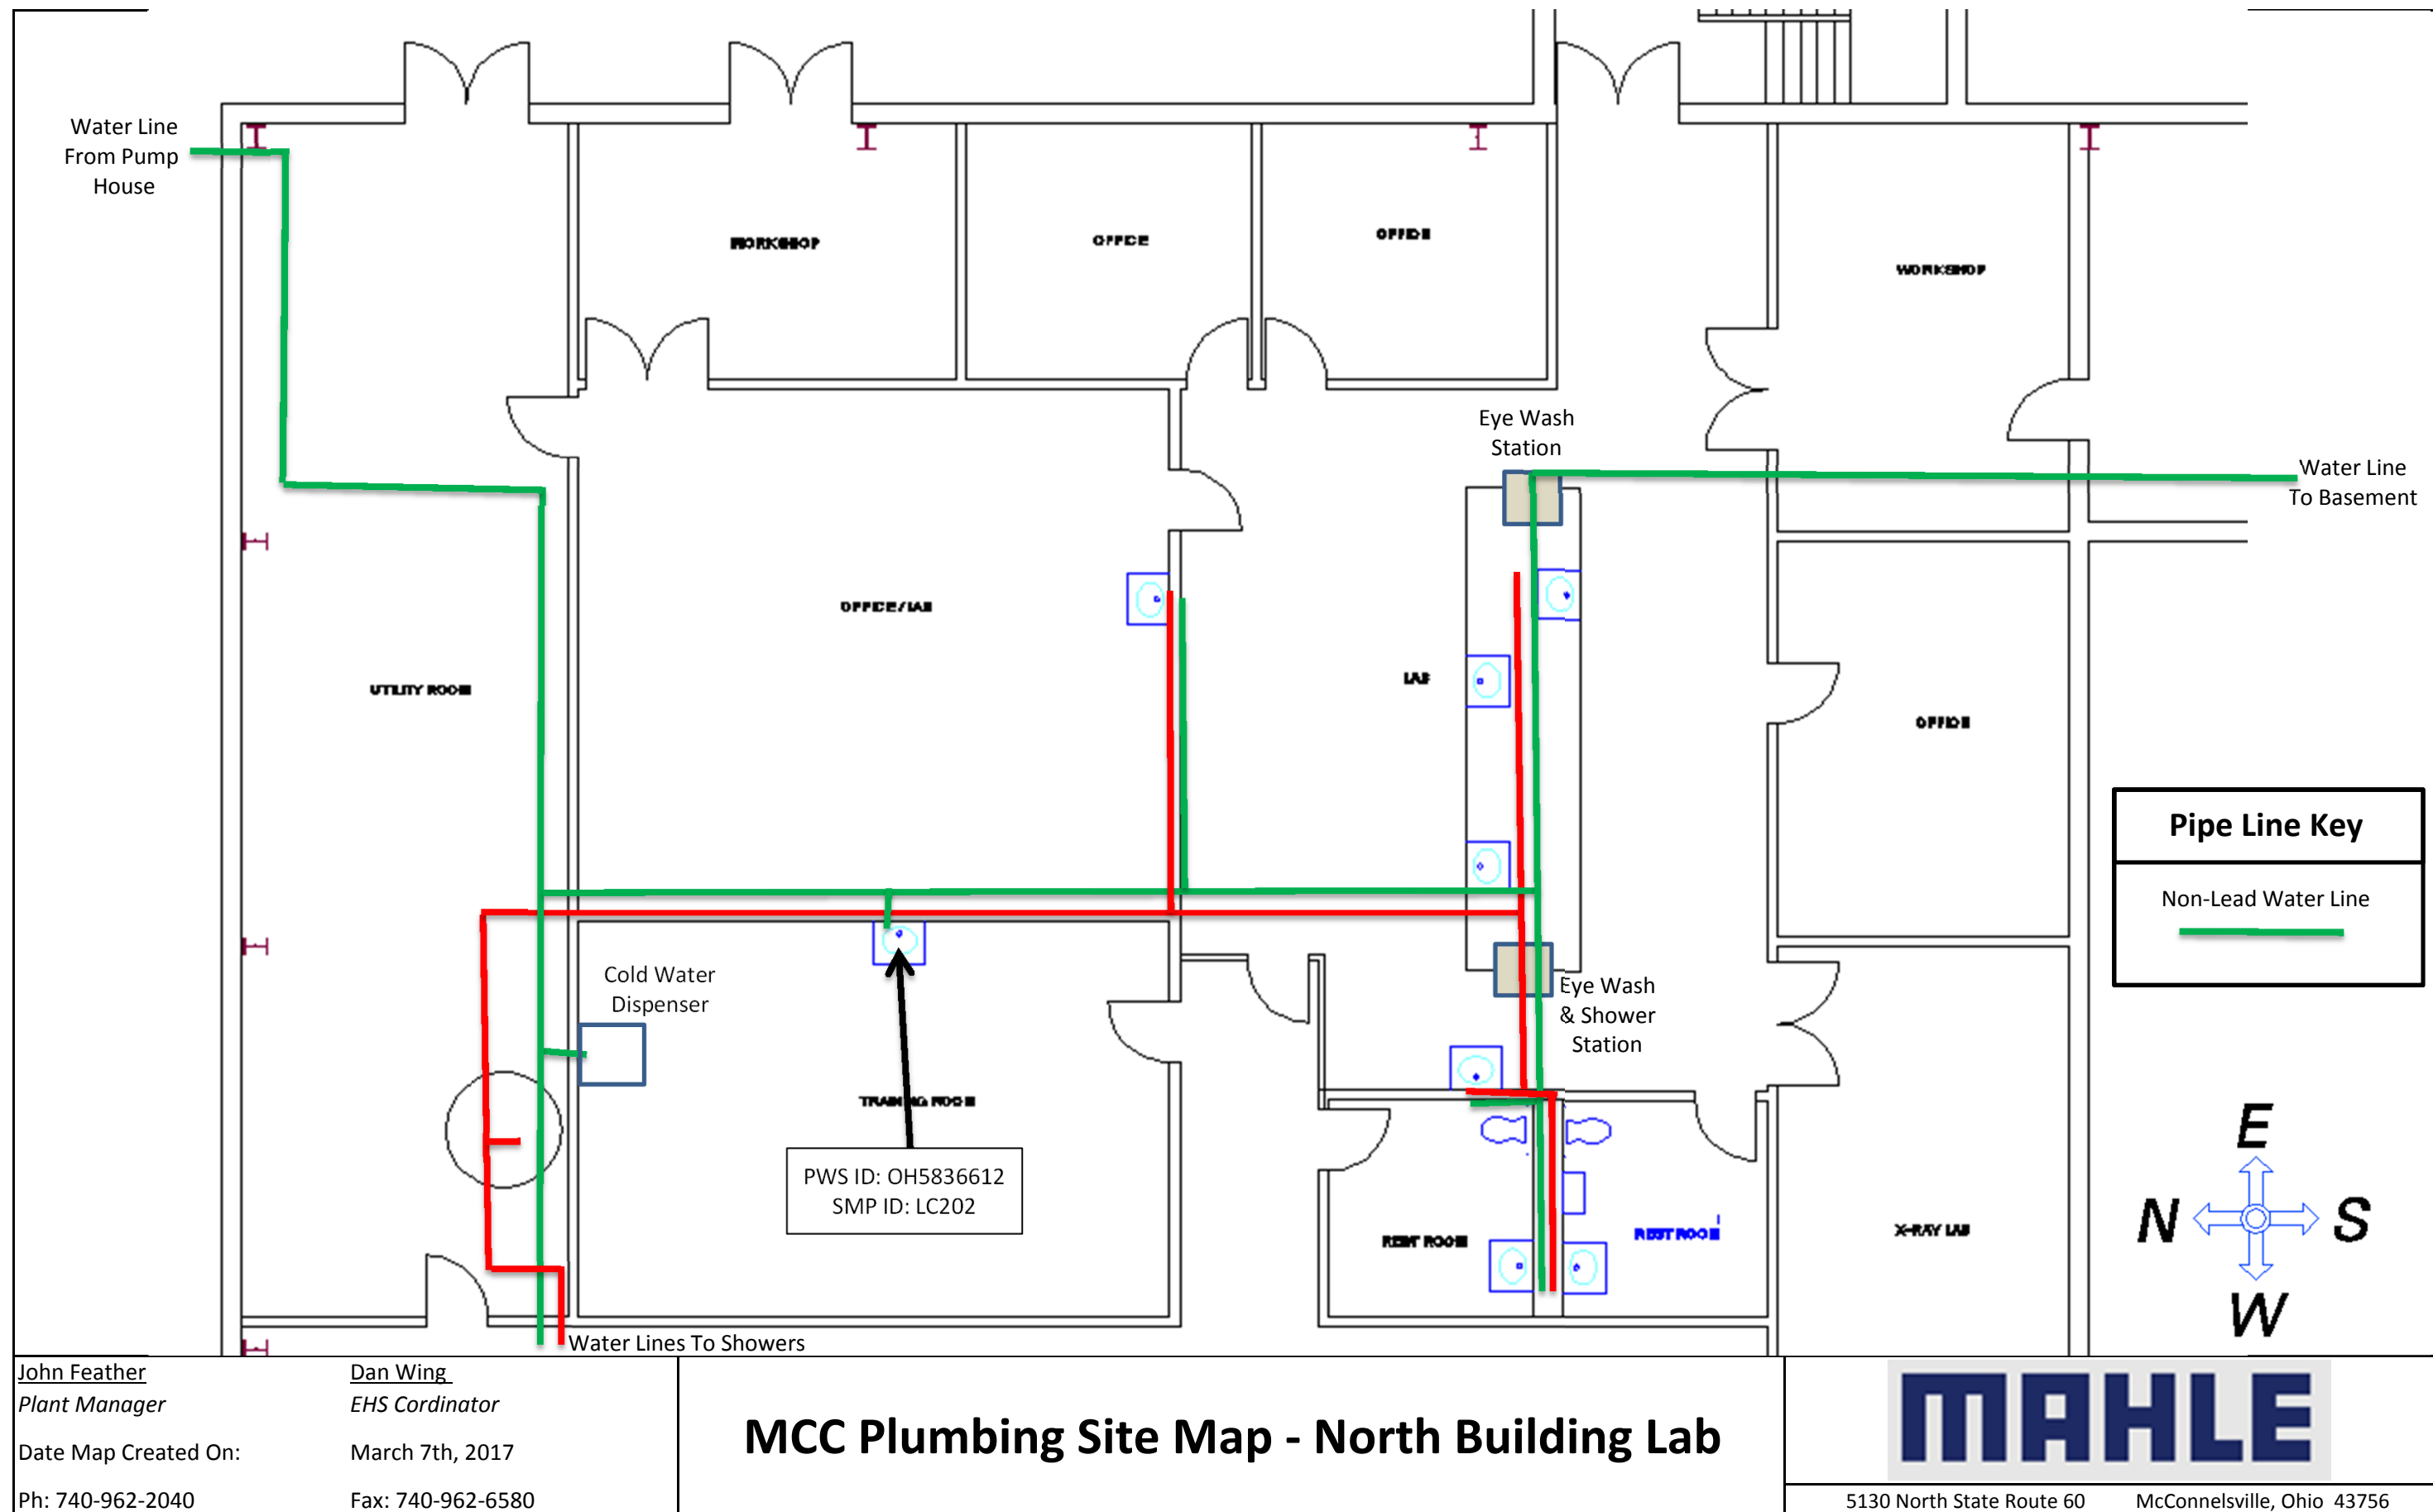


John Feather
Plant Manager

Dan Wing
EHS Coordinator


Date Map Created On: March 7th, 2017

Ph: 740-962-2040 Fax: 740-962-6580

MCC Plumbing Site Map - North Building Lab

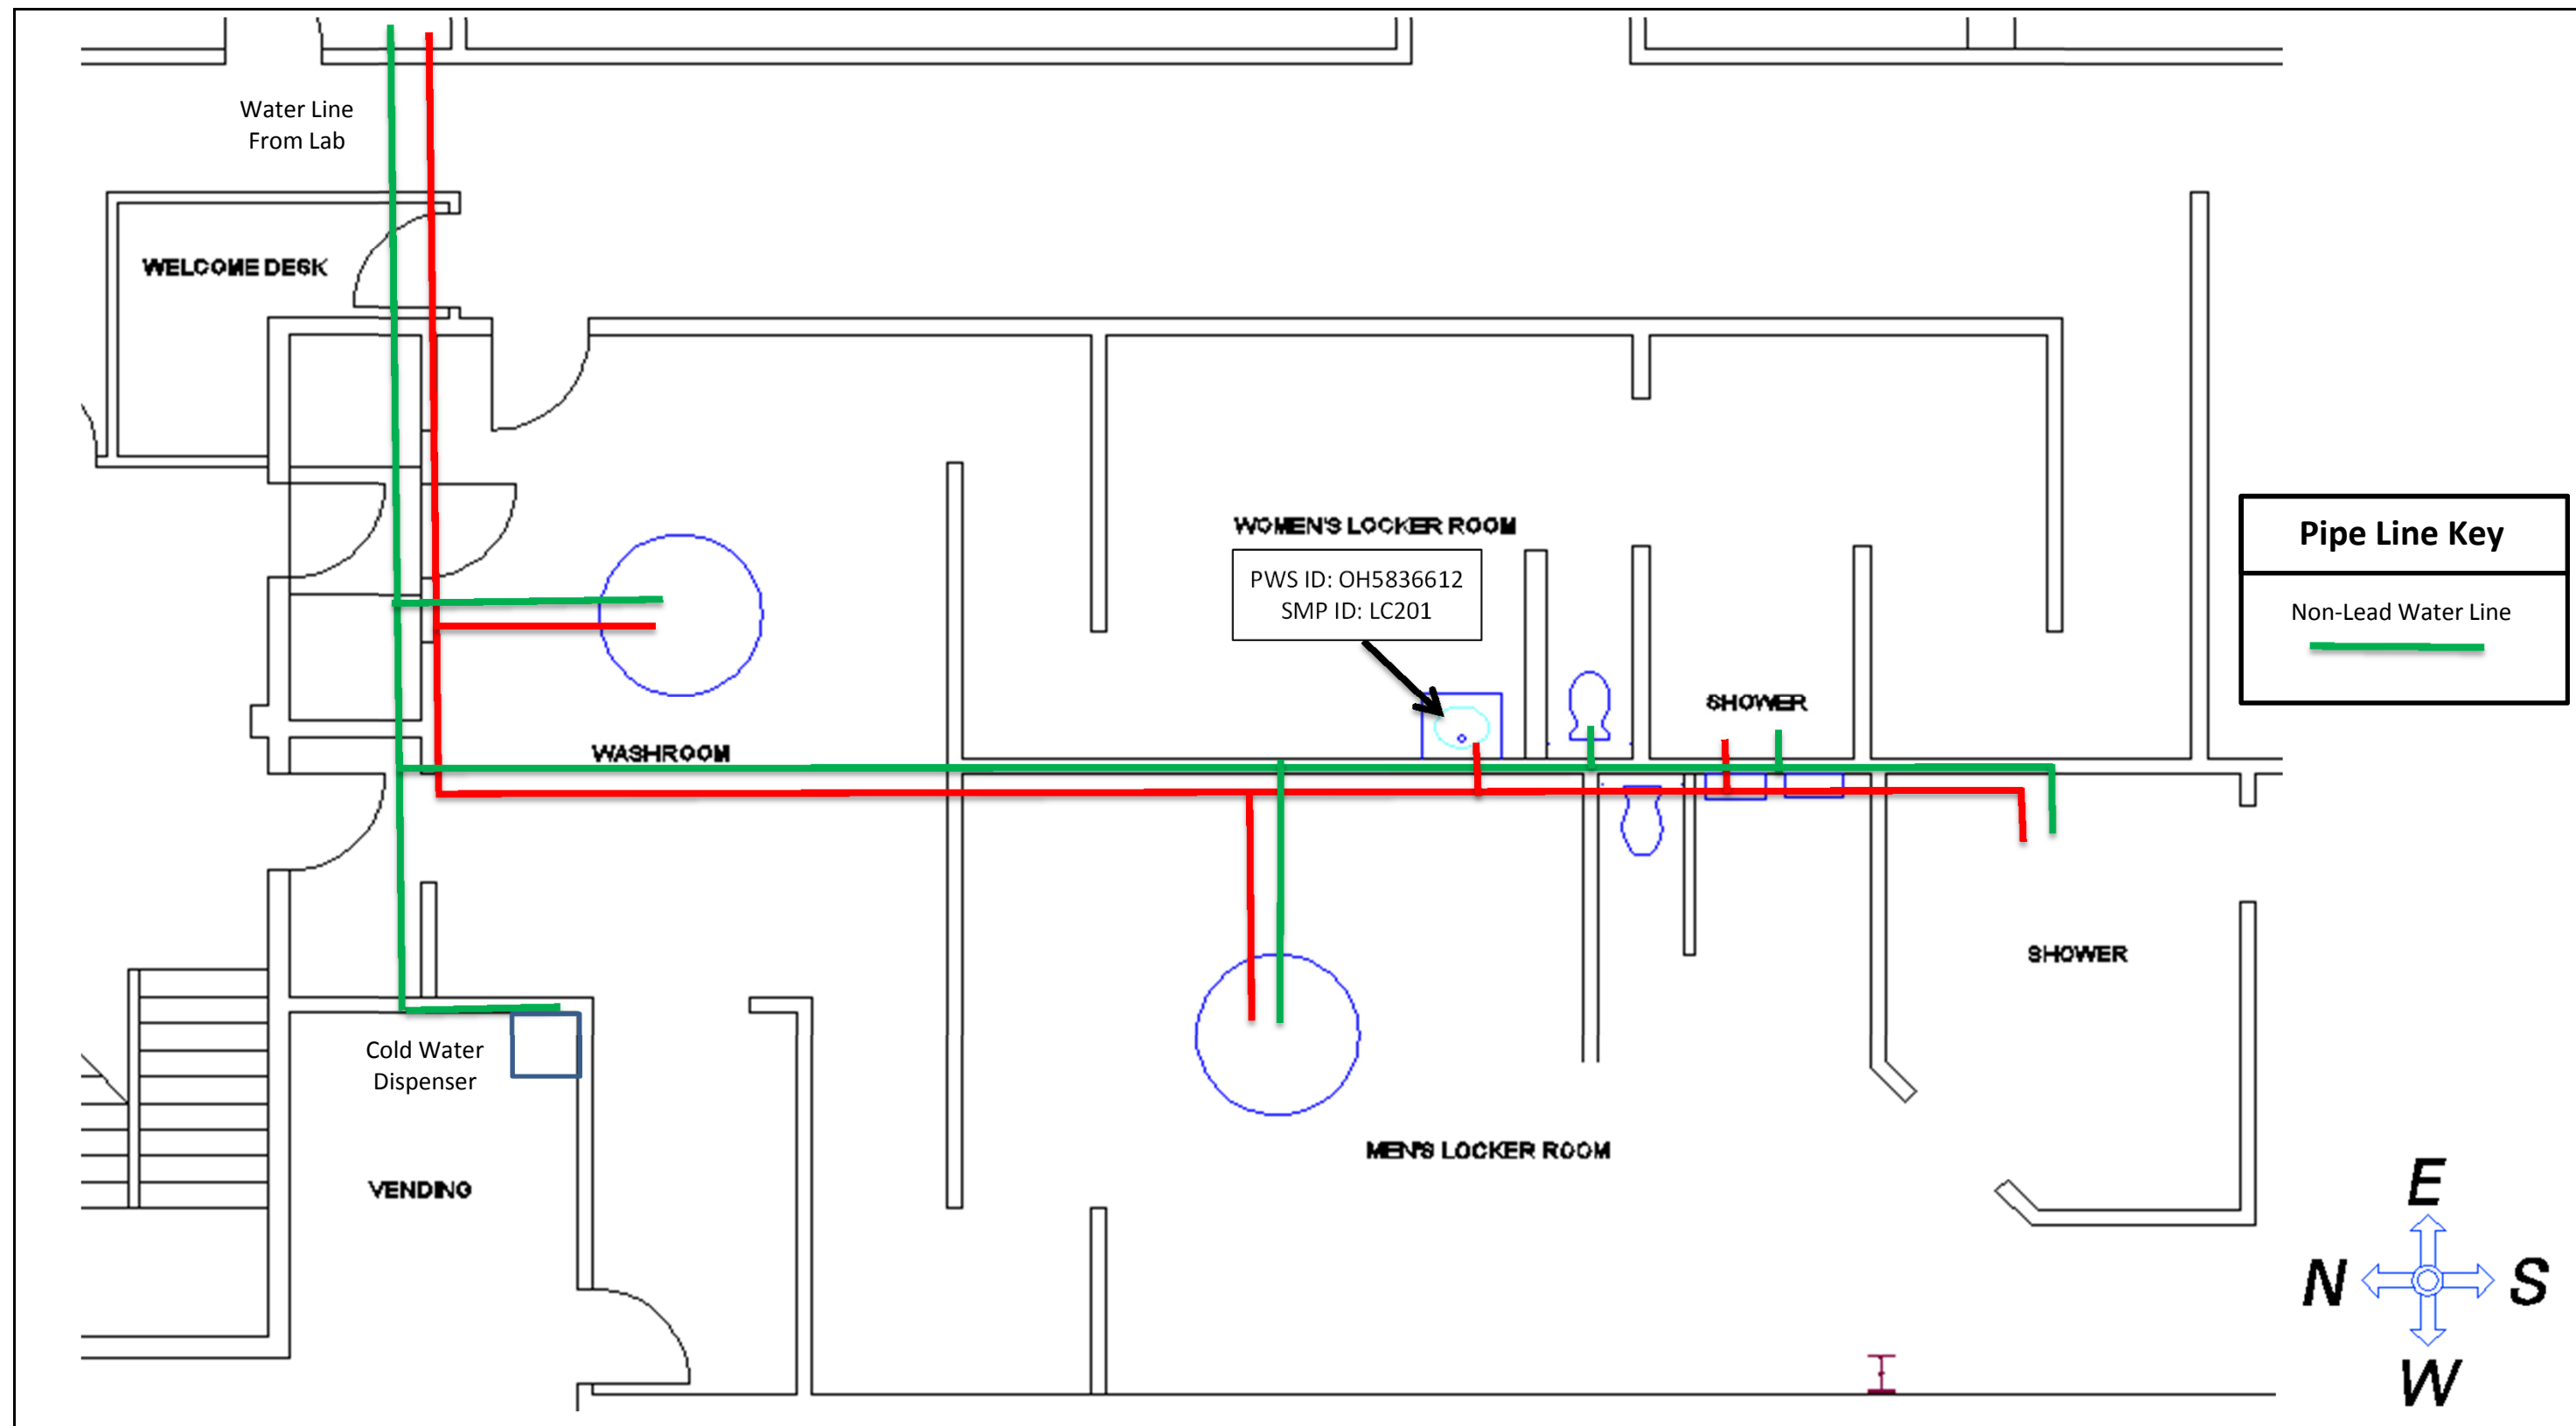

<p>John Feather Plant Manager</p> <p>Date Map Created On: Ph: 740-962-2040</p>	<p>Dan Wing EHS Coordinator</p> <p>March 7th, 2017 Fax: 740-962-6580</p>	<p>MCC Plumbing Site Map - North Building Showers</p>	<p>MAHLE</p> <p>5130 North State Route 60 McConnsville, Ohio 43756</p>
--	--	--	--

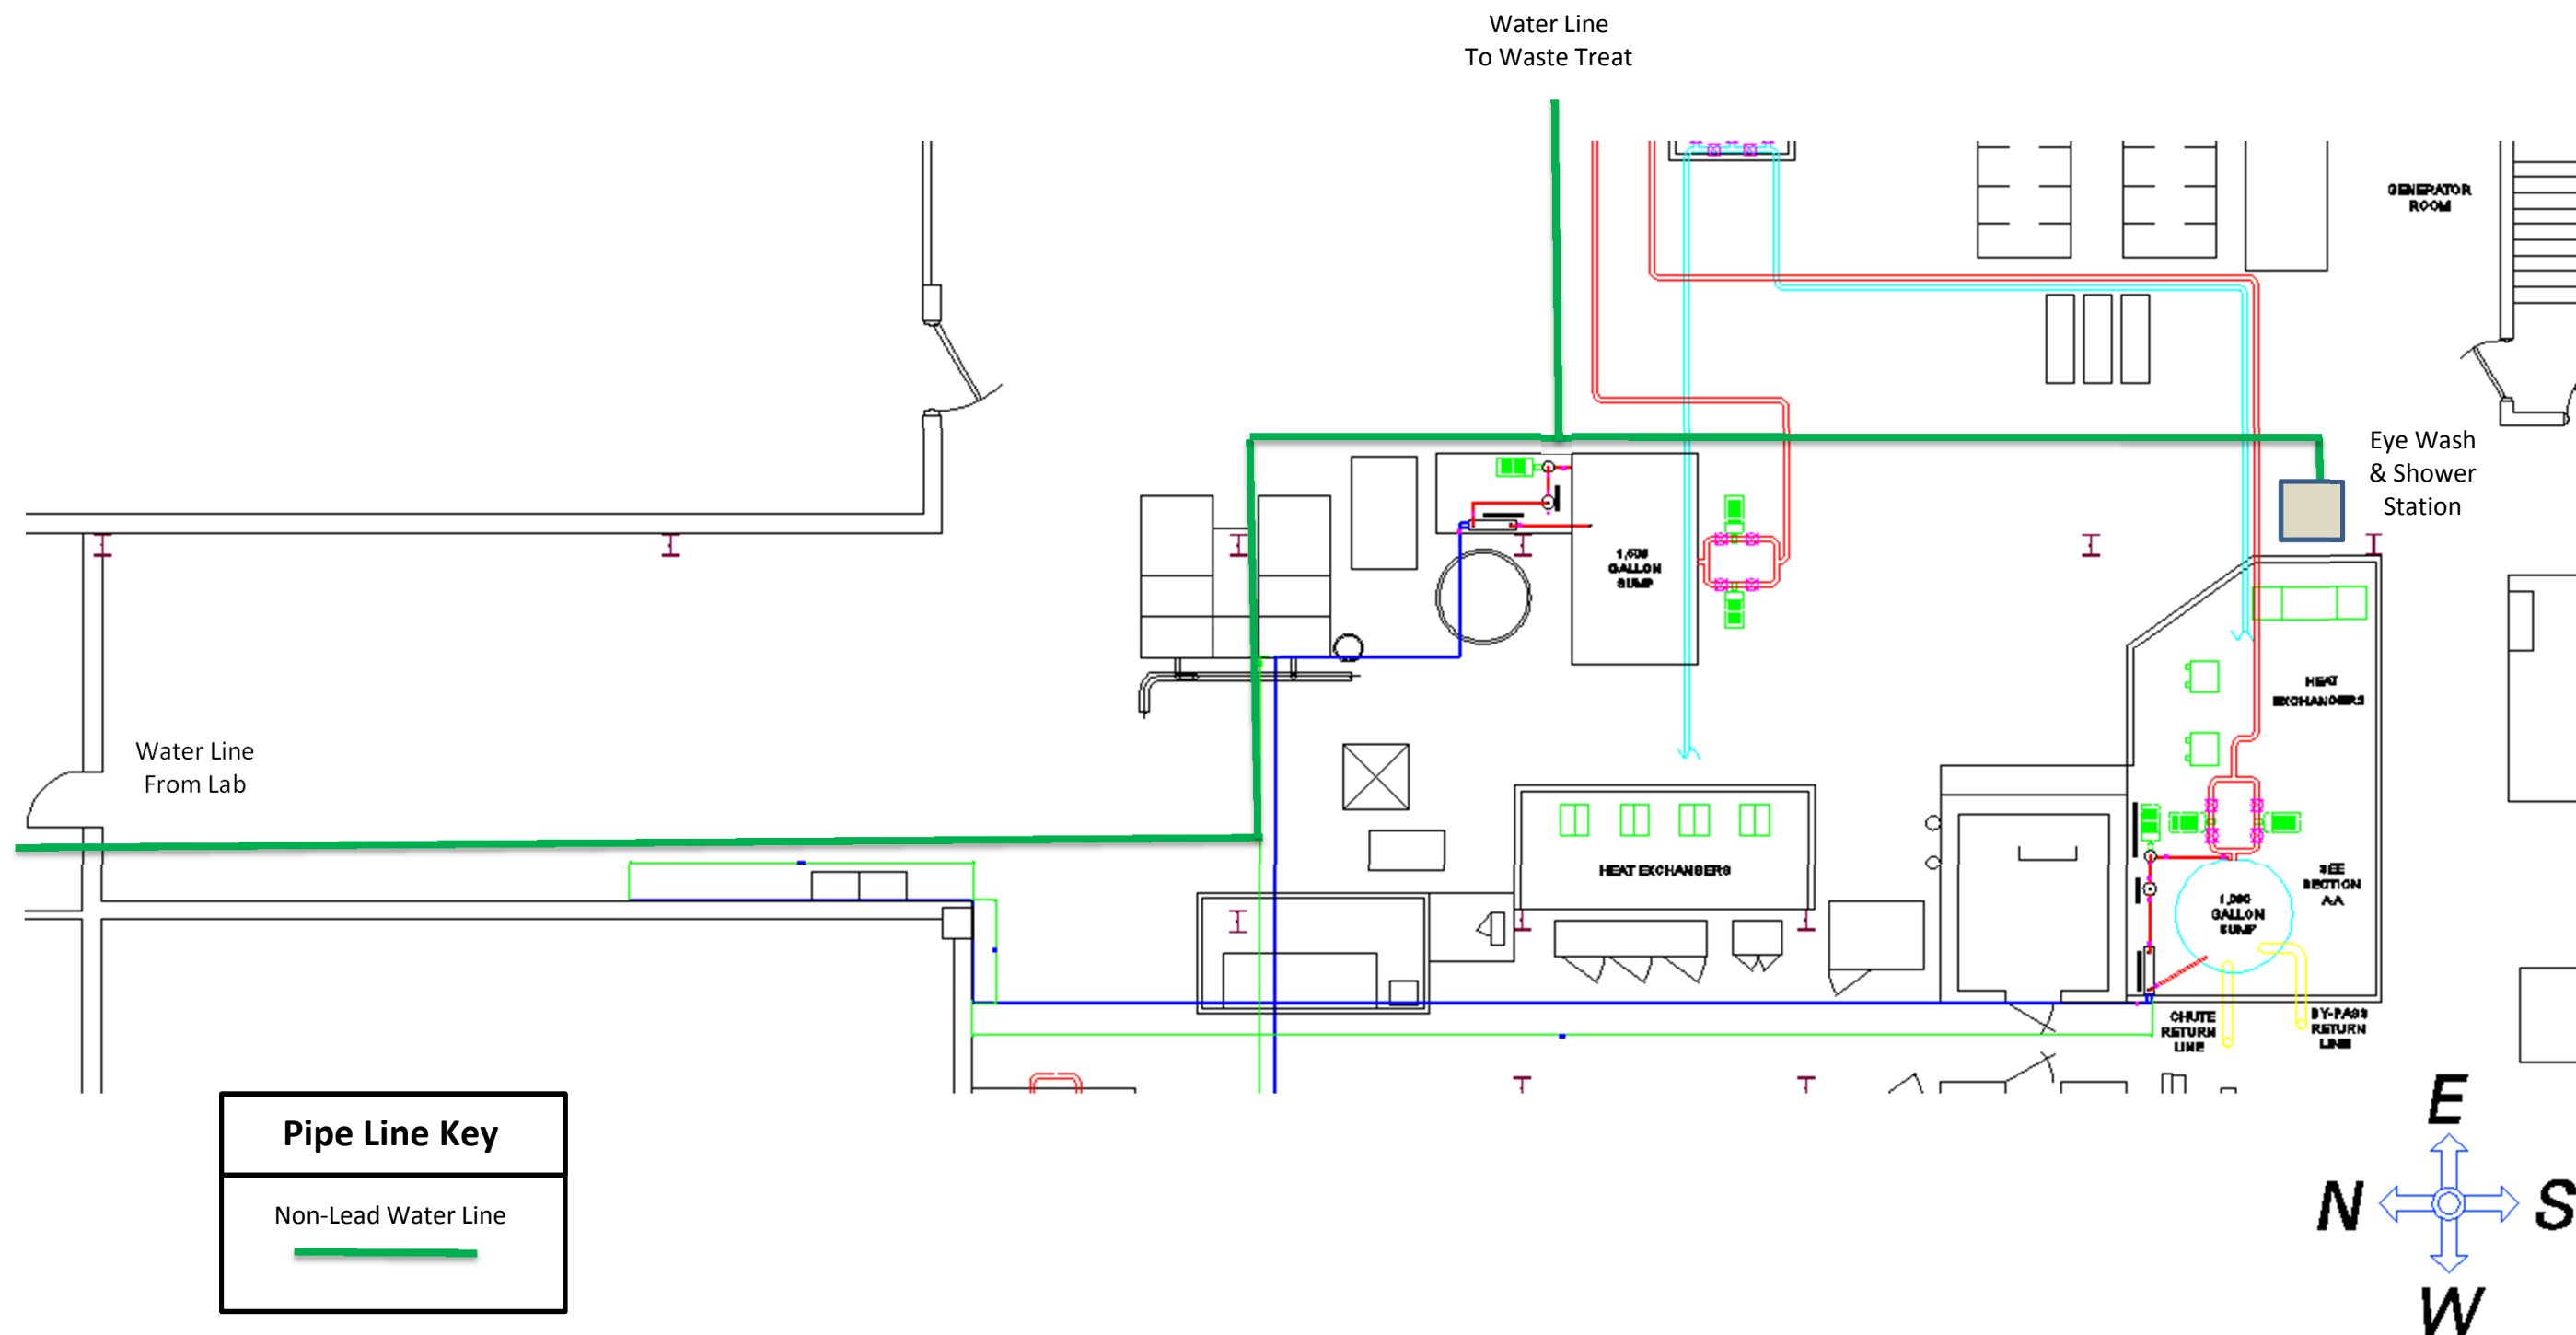

John Feather
Plant Manager

Dan Wing
EHS Coordinator

Date Map Created On:

March 7th, 2017

Ph: 740-962-2040

Fax: 740-962-6580

MCC Plumbing Site Map - North Building Basement

MAHLE

5130 North State Route 60

McConnsville, Ohio 43756