

RECEIVED

MAR 07 2017

OHIO EPA NEDO

PM ESTATES PWS OH6700612 drinking water distribution mains consist of Plastic and Poly pipe. The service lines, hardware and meters are a combination of Plastic, and Brass, including corporation stops. No lead service lines are known at the time of this writing, on the public the repair of distribution system is inconclusive,. The above-mentioned systems major renovation and or obsolescent programs have well been underway to remove old existing Mobiles home with brand new units conforming to new lead and copper rules. To avoid any questions, we are sampling from only the oldest homes, to assure that lead and copper analytical results are a true representation of the worst case scenario, to provide assurance and integrity, that the health and welfare of our most precious commodities, our consumers is not compromised.


Because it is practically impossible to determine lead content of an installed fixture, fitting or pipe, it should be assumed that the manufacture or installation date is the primary indicator of the lead content. Therefore, the characteristics would be buildings and piping solder or fixtures would be buildings in Ohio built prior to 1998 or that use plumbing material or solder manufactured before 1998 may have materials with greater than 8% lead and are at a higher risk of contributing lead to the drinking water than materials manufactured after 1998. In addition, buildings built and plumbing materials manufactured after 2014 were required to have less than 0.25% lead by weight and have the lowest risk for contributing lead to the drinking water. It should be noted however that, although prohibited, some use of leaded solder or leaded components may have occurred after the prohibitions became effective.

Eugene F. Davis

Chief Operator

Efdavis2 & Associates LLC

Entity: Modern Management - PM Estates  
Doc Type: REPORT  
Doc Subtype: \_\_\_\_\_  
Program: DPASW  
County: Pataskala  
Secondary ID: OH6700612

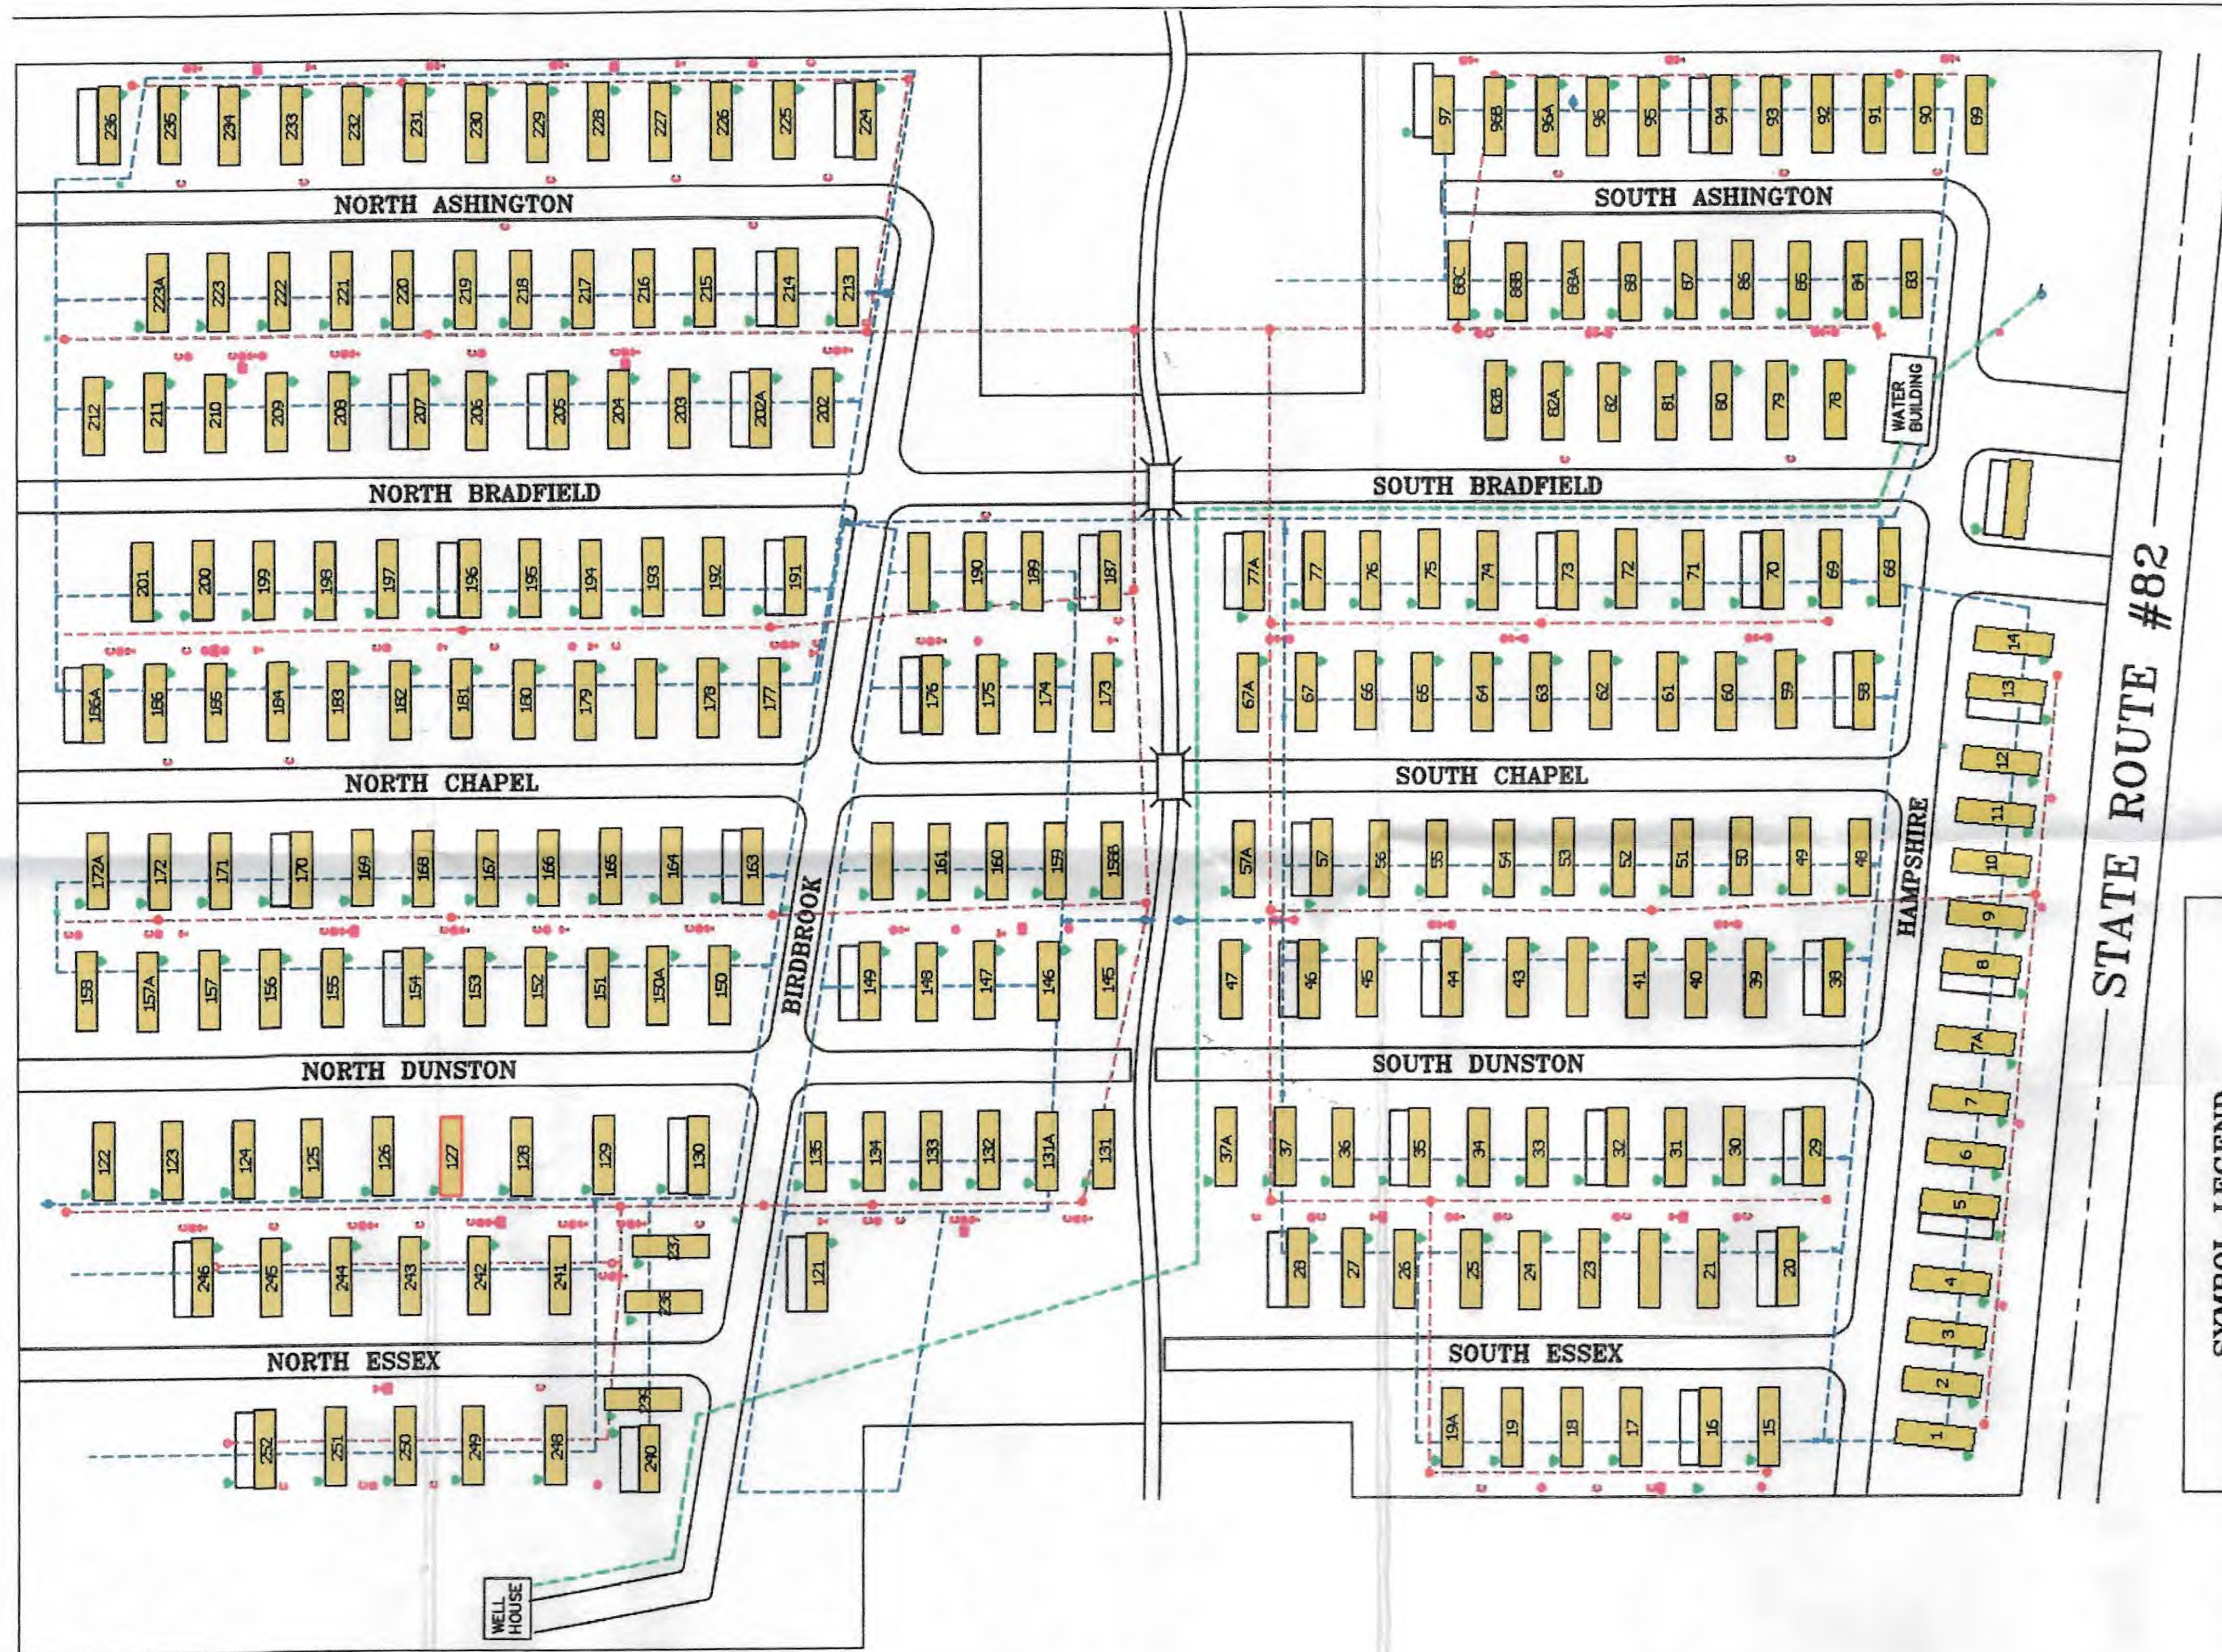

LC 201 9116 HAMPSHIRE  
 LC 202 9897 SO. DUNSTON  
 LC 203 9921 SO. CHAPEL  
 LC 204 9912 SO. BRADFORD  
 LC 205 9982 W. CHAPEL

MAINS PVC / PLASTIC  
 SERVICE LINES METERS  
 INTERIOR WATER TREATMENT PLAN  
 CW, Pbs 2 & 3

SYMBOL LEGEND	
	ELECTRICAL METERS
	ELECTRIC TRANSFORMER
	WATER SHUT-OFF VALVE
	FLUSHING HYDRANT
	WATER SUPPLY LINE
	GAS SHUT-OFF VALVE
	GAS METER
	TELEPHONE BOX
	CABLE BOX
	SANITARY MAN HOLE
	SANITARY LINE
	CLEANOUT
	W.R.T. LINE

STATE ROUTE #82