



- #1 LC201
- #2 LC202
- #3 LC204
- #4 LC203
- #5 LC205


SERVICE BUILDING WATER SUPPLY DIAGRAM

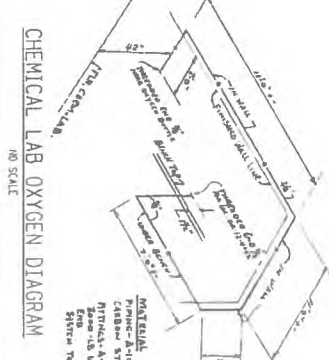

CHEMICAL LAB OXYGEN DIAGRAM

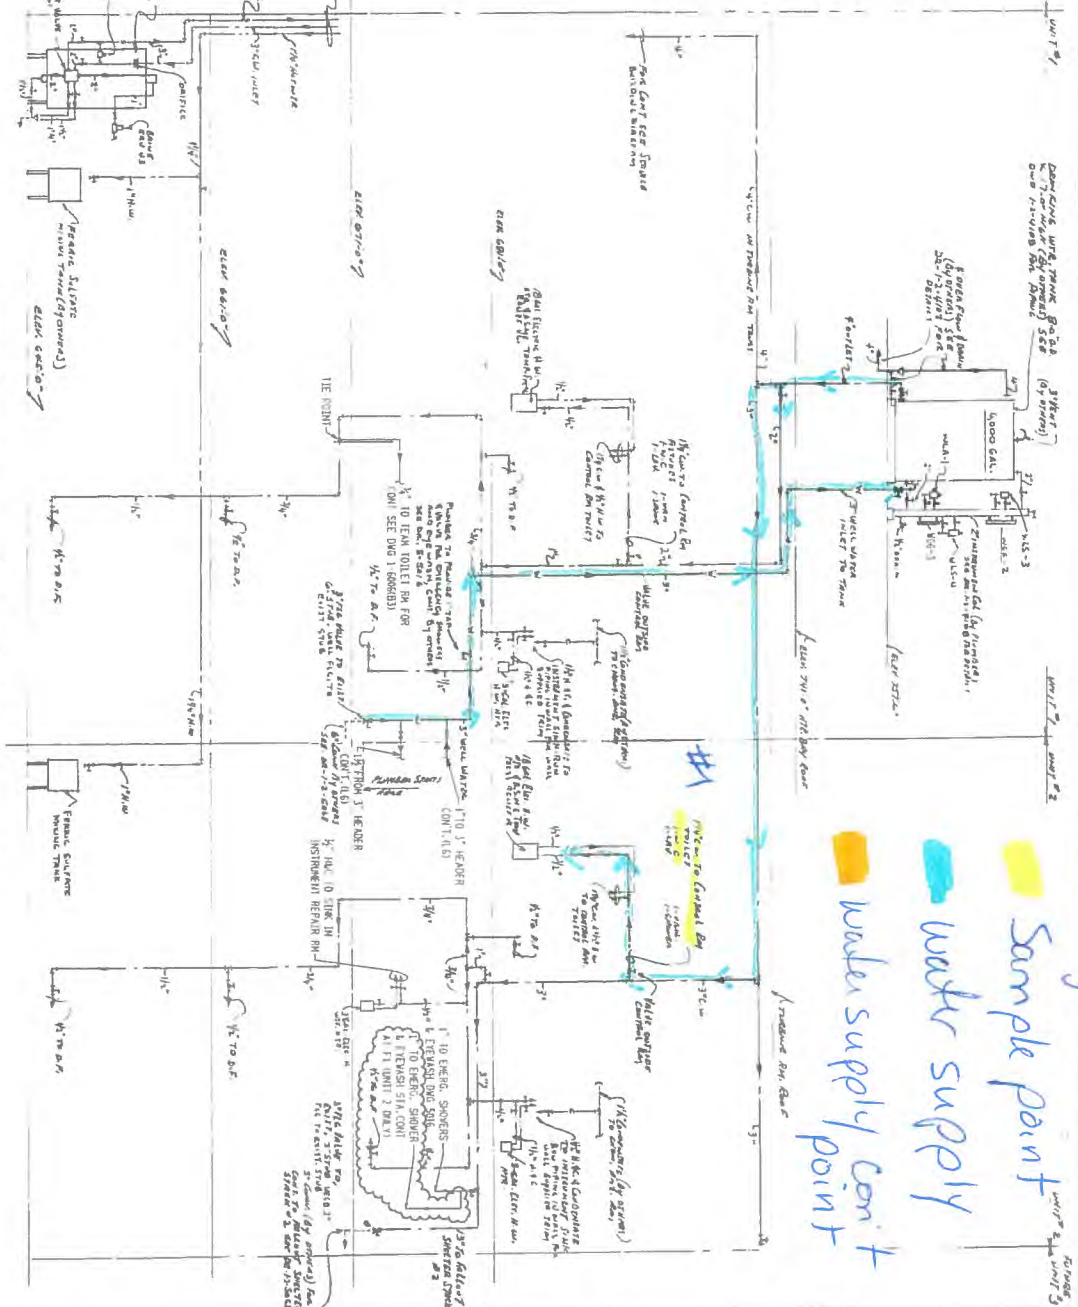

POWER PLANT UNITS 1&2 WATER SUPPLY DIAGRAM

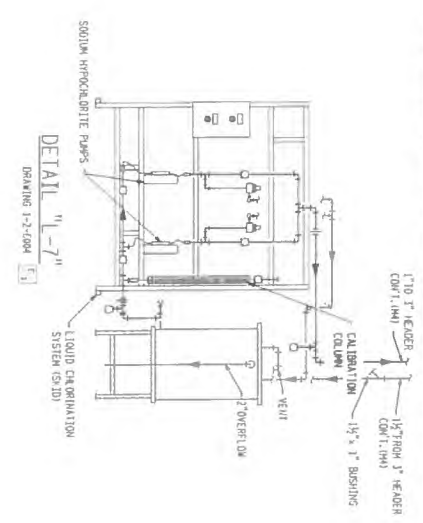

SODIUM HYPOCHLORITE PIPING

diagram name
 Sample point
 water supply
 water supply cont
 water supply point

Diagram name
 Sample point U2 Control room
 POSS PD 044130912

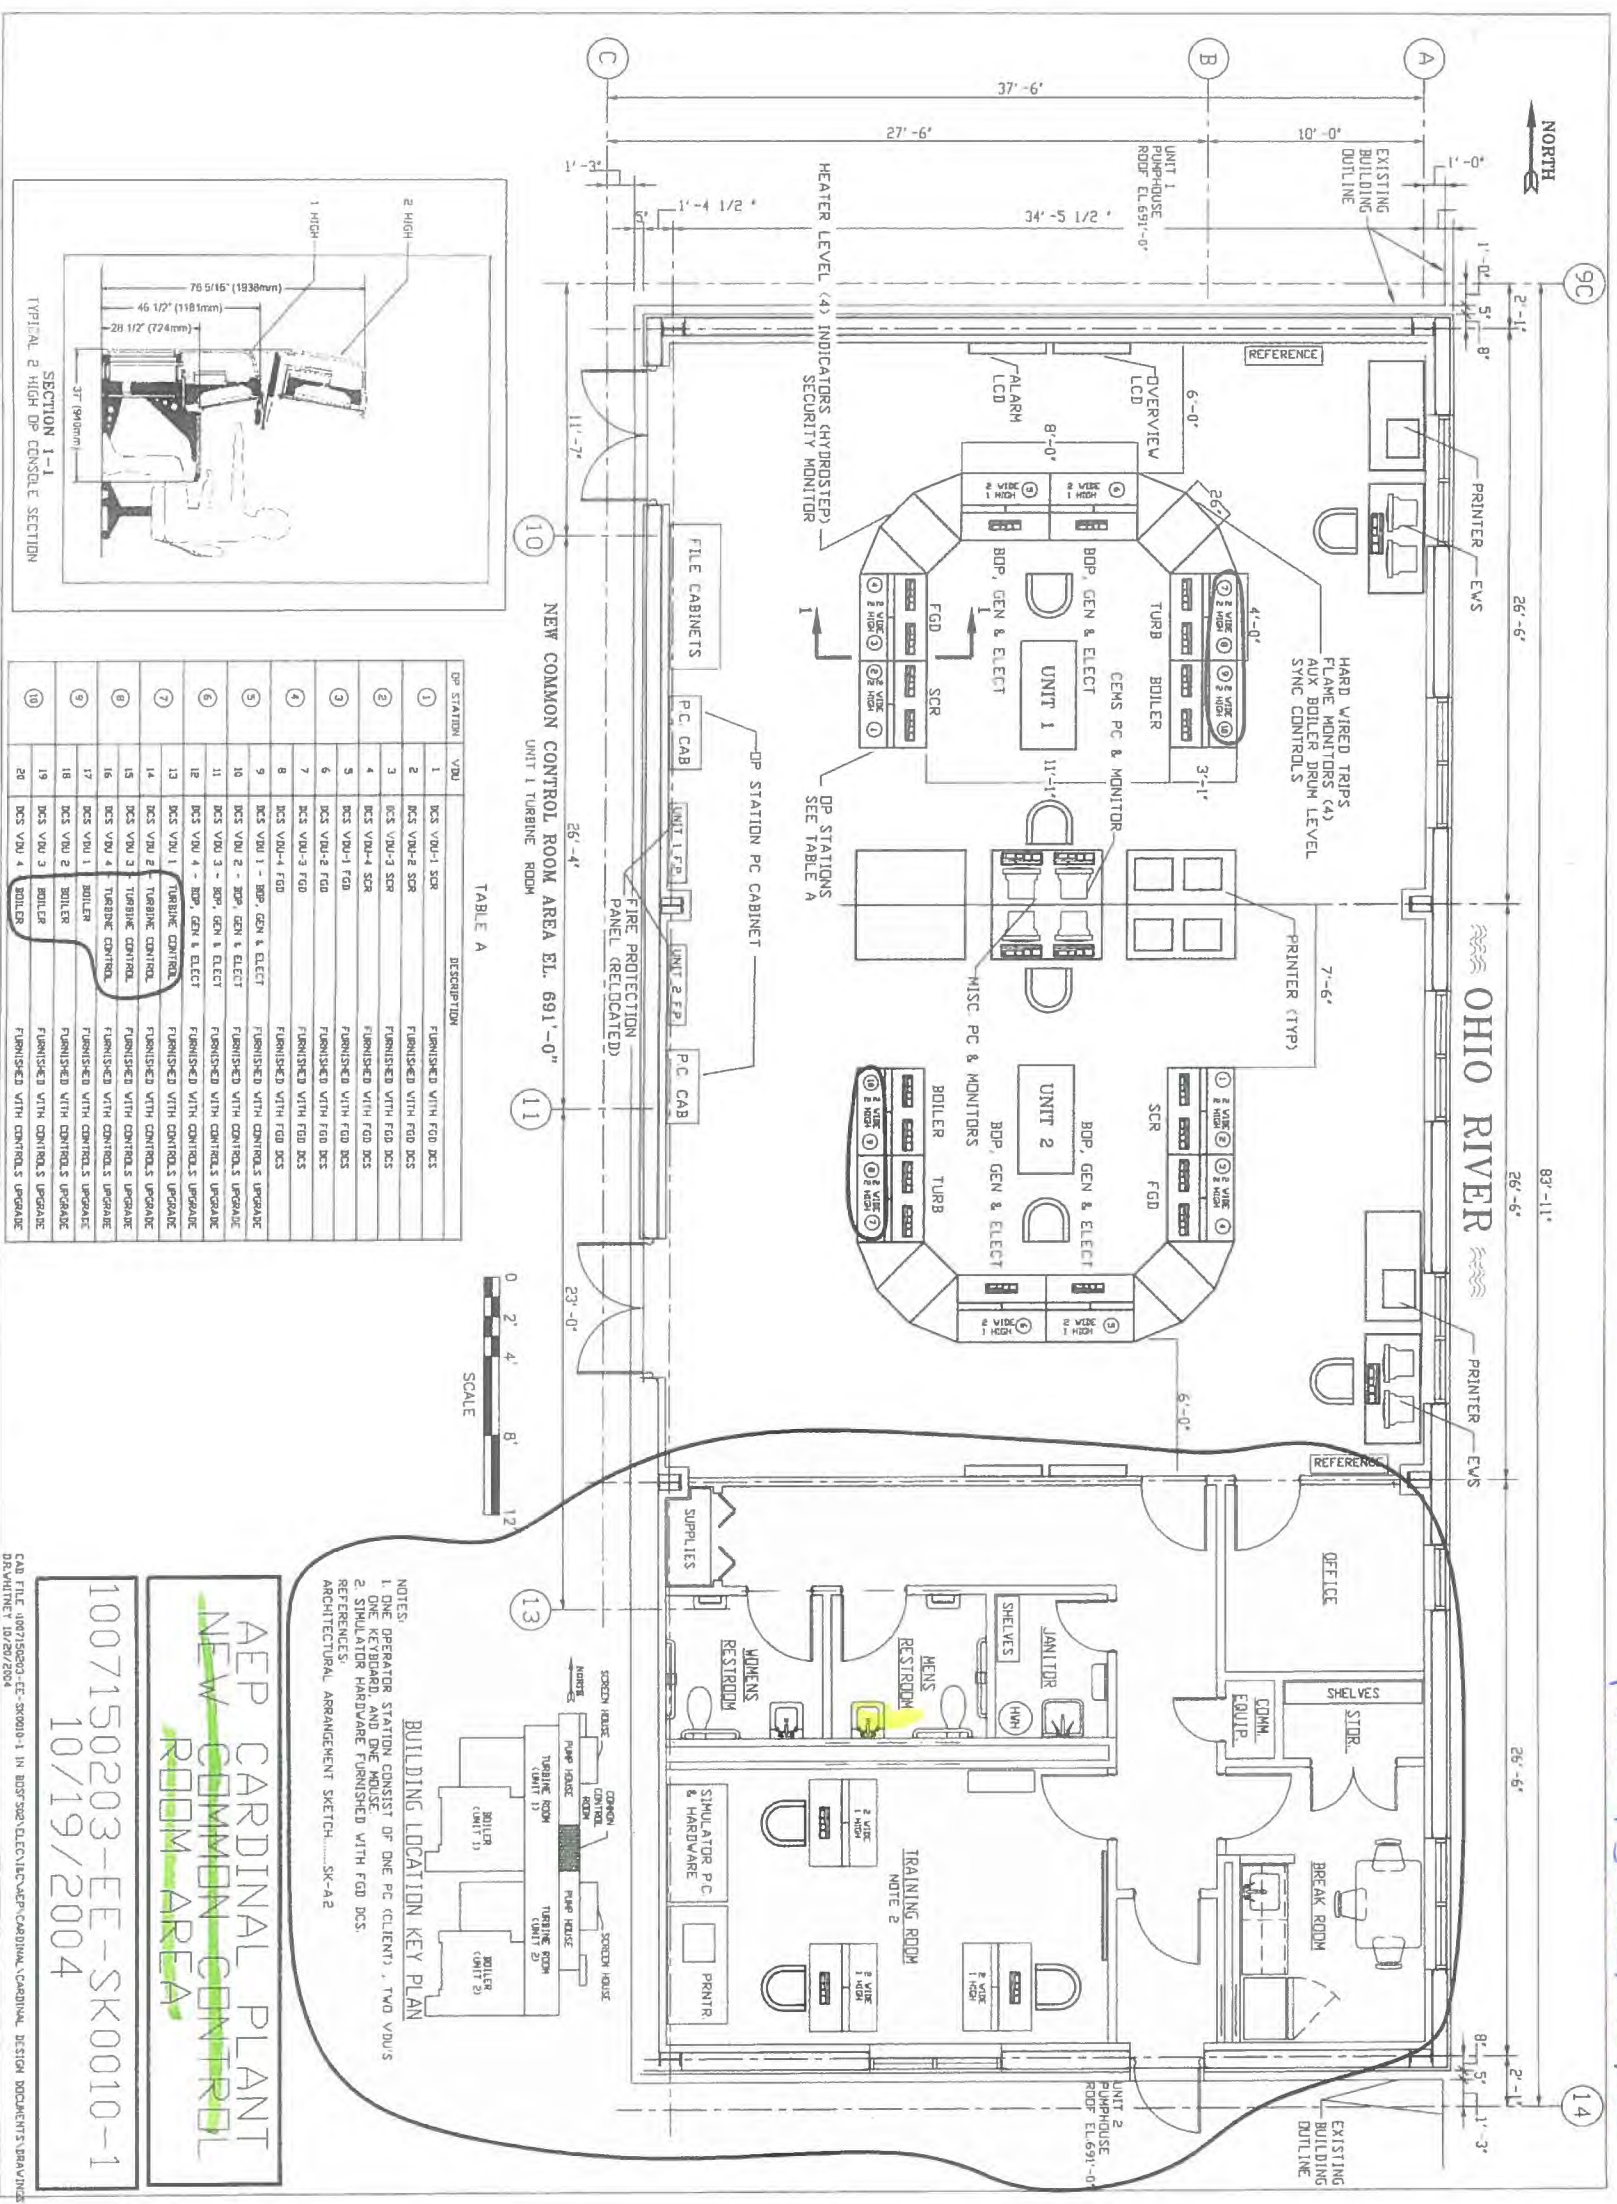


TABLE A

DP STATION	VDU	DESCRIPTION
1	DCS VDU-1 SCR	FURNISHED WITH FGD DCS
2	DCS VDU-2 SCR	FURNISHED WITH FGD DCS
3	DCS VDU-3 SCR	FURNISHED WITH FGD DCS
4	DCS VDU-4 SCR	FURNISHED WITH FGD DCS
5	DCS VDU-1 FGD	FURNISHED WITH FGD DCS
6	DCS VDU-2 FGD	FURNISHED WITH FGD DCS
7	DCS VDU-3 FGD	FURNISHED WITH FGD DCS
8	DCS VDU-4 FGD	FURNISHED WITH FGD DCS
9	DCS VDU 1 - BOP, GEN & ELECT	FURNISHED WITH CONTROLS UPGRADE
10	DCS VDU 2 - BOP, GEN & ELECT	FURNISHED WITH CONTROLS UPGRADE
11	DCS VDU 3 - BOP, GEN & ELECT	FURNISHED WITH CONTROLS UPGRADE
12	DCS VDU 4 - BOP, GEN & ELECT	FURNISHED WITH CONTROLS UPGRADE
13	DCS VDU 1 - TURBINE CONTROL	FURNISHED WITH CONTROLS UPGRADE
14	DCS VDU 2 - TURBINE CONTROL	FURNISHED WITH CONTROLS UPGRADE
15	DCS VDU 3 - TURBINE CONTROL	FURNISHED WITH CONTROLS UPGRADE
16	DCS VDU 4 - TURBINE CONTROL	FURNISHED WITH CONTROLS UPGRADE
17	DCS VDU 1 - BOILER	FURNISHED WITH CONTROLS UPGRADE
18	DCS VDU 2 - BOILER	FURNISHED WITH CONTROLS UPGRADE
19	DCS VDU 3 - BOILER	FURNISHED WITH CONTROLS UPGRADE
20	DCS VDU 4 - BOILER	FURNISHED WITH CONTROLS UPGRADE

NOTES:
 1. ONE OPERATOR STATION CONSIST OF ONE PC CLIENTS, TWO VDUS AND ONE MONITOR.
 2. SIMULATOR HARDWARE FURNISHED WITH FGD DCS.
 REFERENCES:
 ARCHITECTURAL ARRANGEMENT SKETCH.....SK-A2

BUILDING LOCATION KEY PLAN

1007150203-EE-SK0010-1
 10/19/2004

AEP CARDINAL PLANT
 NEW COMMON CONTROL
 ROOM AREA

FILED: 10/19/2004 10:58:00 AM IN: 1007150203-EE-SK0010-1
 DRAWN BY: 10/20/2004

Plus OH 4130912

Diagram Name

Sample Points Service Buildings
Plus OH 4130912

- #1 CC204
- #2 CC202
- #3 CC203
- #4 CC205







CARDINAL PLANT
OHIO POWER CO.
BUCKETE POWER CO.

Service Building
FLOOR PLAN

DR NO: 4022-7

DATE: 12/12/17

SCALE: 1/8" = 1'-0"

APPROVED BY: [Signature]

AMERICAN ELECTRIC POWER SERVICE COMPANY
2 BROADWAY
NEW YORK