


McCartyville Well Association

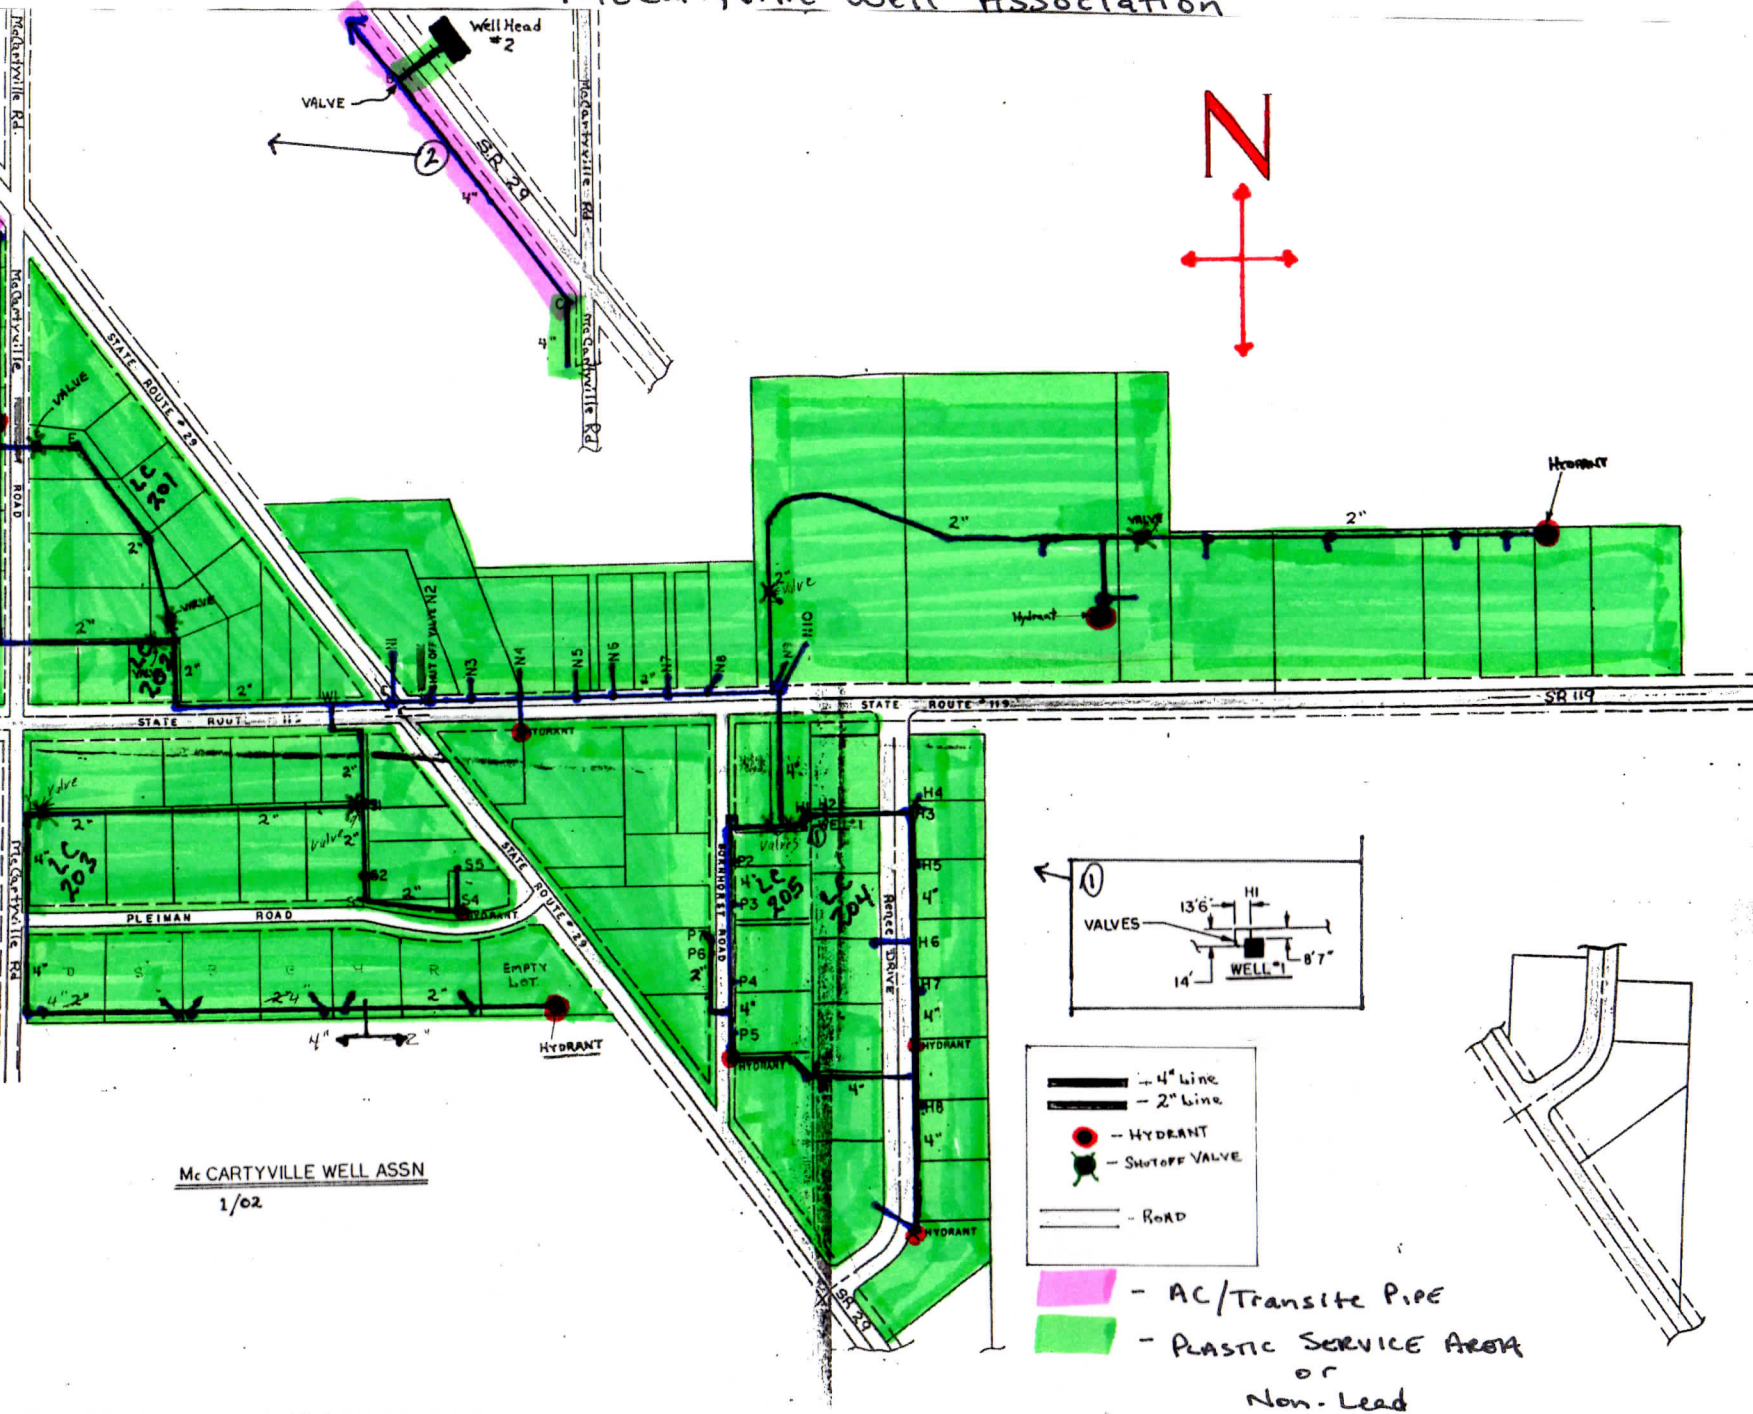


McCartyville Well Association
PWS ID# OH7500812
Lead and Copper Narrative
3/6/2017

To Whom It May Concern,

This narrative includes information pertaining to the Lead and Copper Mapping Requirements of 2017. After reviewing the water lines, it has been determined that the main lines are Plastic and A/C Transite pipe. Service Lines from the main to the residential valve box are plastic, copper or galvanized. Service lines from the valve box in to the homes are an assortment of plastic, copper or galvanized as well. The subdivision was developed prior to 1988 so there is a possibility of lead solder more than 0.2% in the homes. These homes may also contain materials with greater than 8% lead and are at a higher risk of contributing lead to the drinking water. Records and visual inspections verify that the mains are plastic and A/C Transite pipe. Please contact me should you have any questions regarding this matter.

Sincerely,

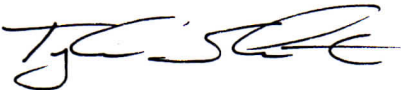

Tyler Shuster
McCartyville Well Association, Operator of Record
Cell: 937-638-5435
Email: tylershuster@yahoo.com

VERIFICATION FORM FOR COMMUNITY PUBLIC WATER SYSTEMS CLAIMING NO LEAD SERVICE LINES

The owner or operator of all community public water systems must identify and map areas of their distribution system that are known or are likely to contain lead service lines. Systems must submit a copy of the applicable map to the Ohio Department of Health and the Ohio Department of Job and Family Services. Systems must also submit a report to the director containing at least both of the following: (1) The applicable map with narrative, and (2) A list of sampling locations used to collect samples as required by Ohio Revised Code (ORC) Section 6109.121 and any rules adopted thereunder, including contact information for the owner and occupant of each sampling site.

Should a water system determine no lead service lines exist in their distribution system, they must provide information stating they reviewed, at the minimum, historical permit records and local ordinances, distribution maintenance records and information pertaining to installation dates or materials for all services lines. This information must be verified below.

I HEREBY CERTIFY THAT THE FOLLOWING METHOD(S) WERE USED TO DETERMINE NO LEAD SERVICE LINES EXIST IN THIS WATER SYSTEM'S DISTRIBUTION SYSTEM, AS REQUIRED BY ORC 6109.121(F):

LEAD SERVICE LINE VERIFICATION

This PWS states they have no lead service lines and has reviewed the following information (select one or more of the following):

- ☐ Historical permit records and/or local ordinances
- ☒ Distribution maintenance records (i.e. meter replacement, waterline break repairs)
- ☒ Information pertaining to installation dates for all service lines (i.e. after 1986 when lead services lines were banned)
- ☒ Service line material of all service lines is known (i.e. all service lines are known to be PVC)

 3-8-17
Signature of Responsible Person Date

TYLER SHUSTER, OPERATOR OF RECORD
Printed Name and Title of Responsible Person

PWS NAME: McCartysville Well Assoc.
PWS ID: OH 7500812
COUNTY: Shelby

For Ohio EPA use only:

Date Verification Rec'd: _____