



Planet Earth
 Preschool
 4129 St. Rt. 14
 Ravenna OH 44266
 330-325-7342
 PWS 678-4012

OHIO EPA NEDO

MAR 09 2017

RECEIVED

Entity: Planet Earth
 Doc Type: Report
 Doc Subtype: _____
 Program: NDAGW
 County: Portage
 Secondary ID: OH 6784012

3-5-17

Sink
Unknown
Fixture
Type

Sink
Unknown
Fixture
Type

Pre School
class

Kitchen



Planet
Earth
Pre School
4129 st. Rt 14
Ravenna OH
44266
330-325-7342
3-5-17

Infant
class

Toddler
class

Wash
Basin
Unknown
Fixture
Type

PWS
678-4012

Sink
Unknown
Fixture
Type

Sink
Unknown
Fixture
Type

Bathroom

OHIO EPA NEDO

MAR 09 2017

RECEIVED


Sink
Unknown
Fixture
Type

Toilet Toilet

First Floor - NTS -

Entry
Point

- No Lead
- Pre 1987
- Post 1987

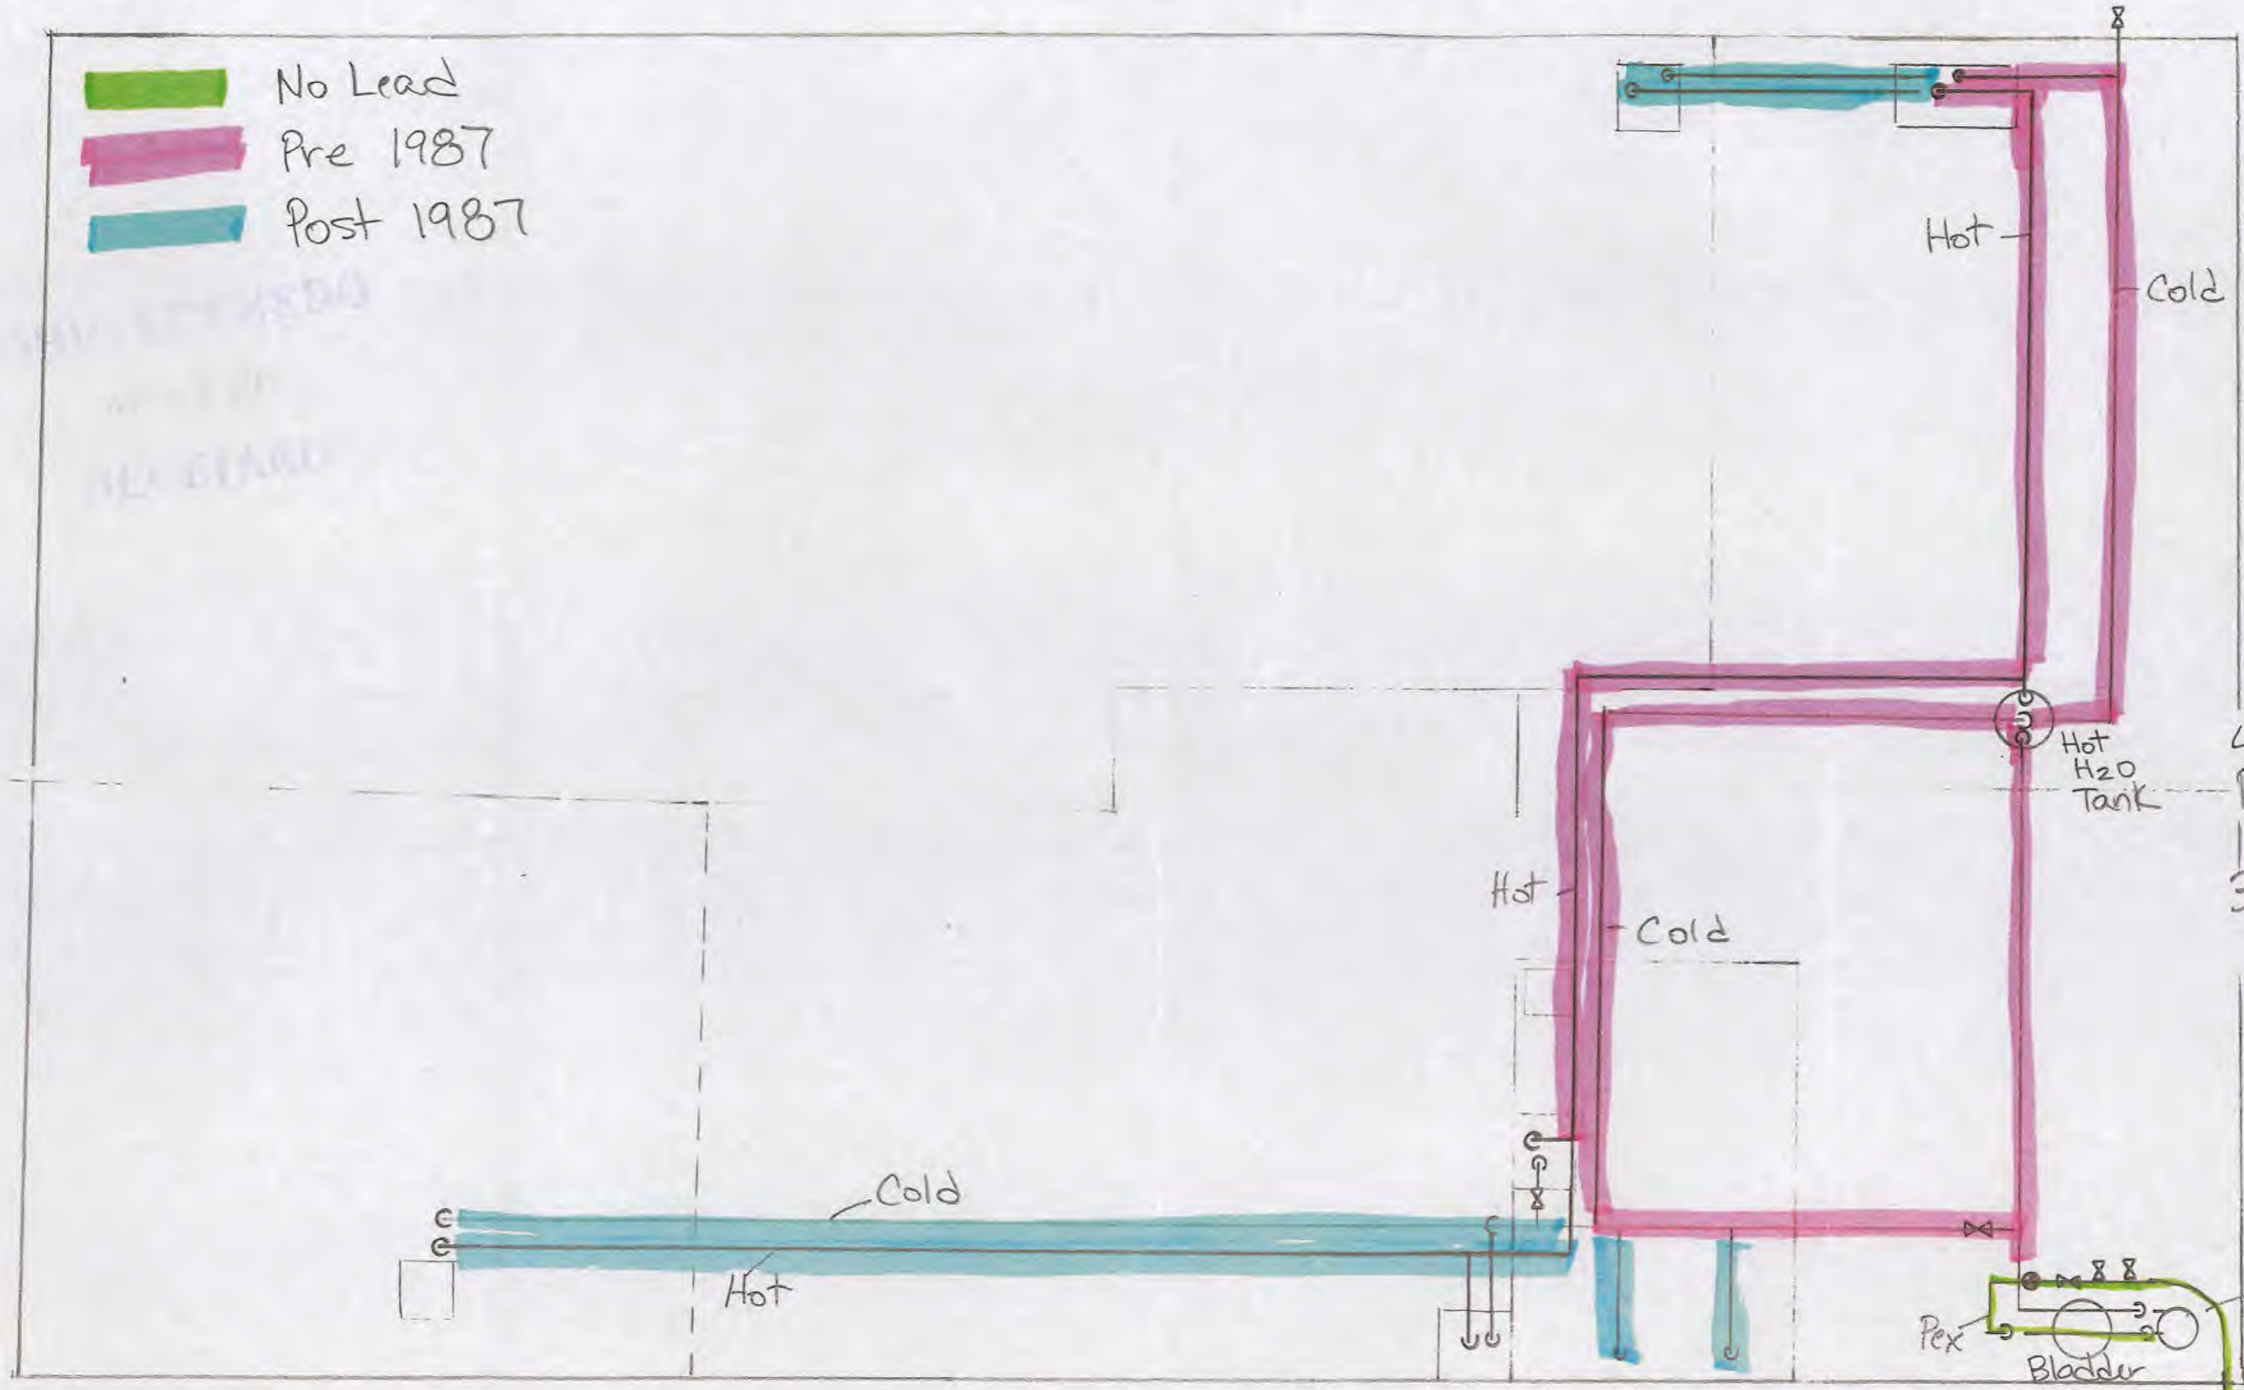

Planet Earth
 PreSchool
 4129 St. Rt. 14
 Ravenna OH
 44266
 330-325-731
 3-5-17
 PWS
 678-4012

Basement -NTS-

Entry Point