

WOODRIDGE INTERMEDIATE SCHOOL
1930 BRONSON AVE.
PENINSULA, OHIO 44264
Ph: 330-657-2351

VOINOVICH COMPANIES
Architects
2450 Prospect Ave.
Cleveland, Ohio 44115
216 821-0200
216 821-0958 (FAX)

DynaLink
All the right connections
5391 Woodland Blvd Cleveland, Ohio 44146
216-464-4659 Fax 216-464-3217
one of the many service companies within
ENCOMPASS
www.encompass-cv.com

SEAL:

RENOVATIONS TO
WOODRIDGE
INTERMEDIATE
SCHOOL
WOODRIDGE LOCAL
SCHOOL DISTRICT
CUYAHOGA FALLS, OHIO

REVISIONS:

Drawn by: XXX
Checked by: XXX
Job Number: 1578-002

KEY PLAN:


DWG. PHASE: CONSTRUCTION DOCUMENTS

Sheet Title:

SECOND AND
THIRD LEVEL
PRO NET
TECHNOLOGY
PLAN

Sheet Number:

TCX.X
Date: 2-29-96 Te230x

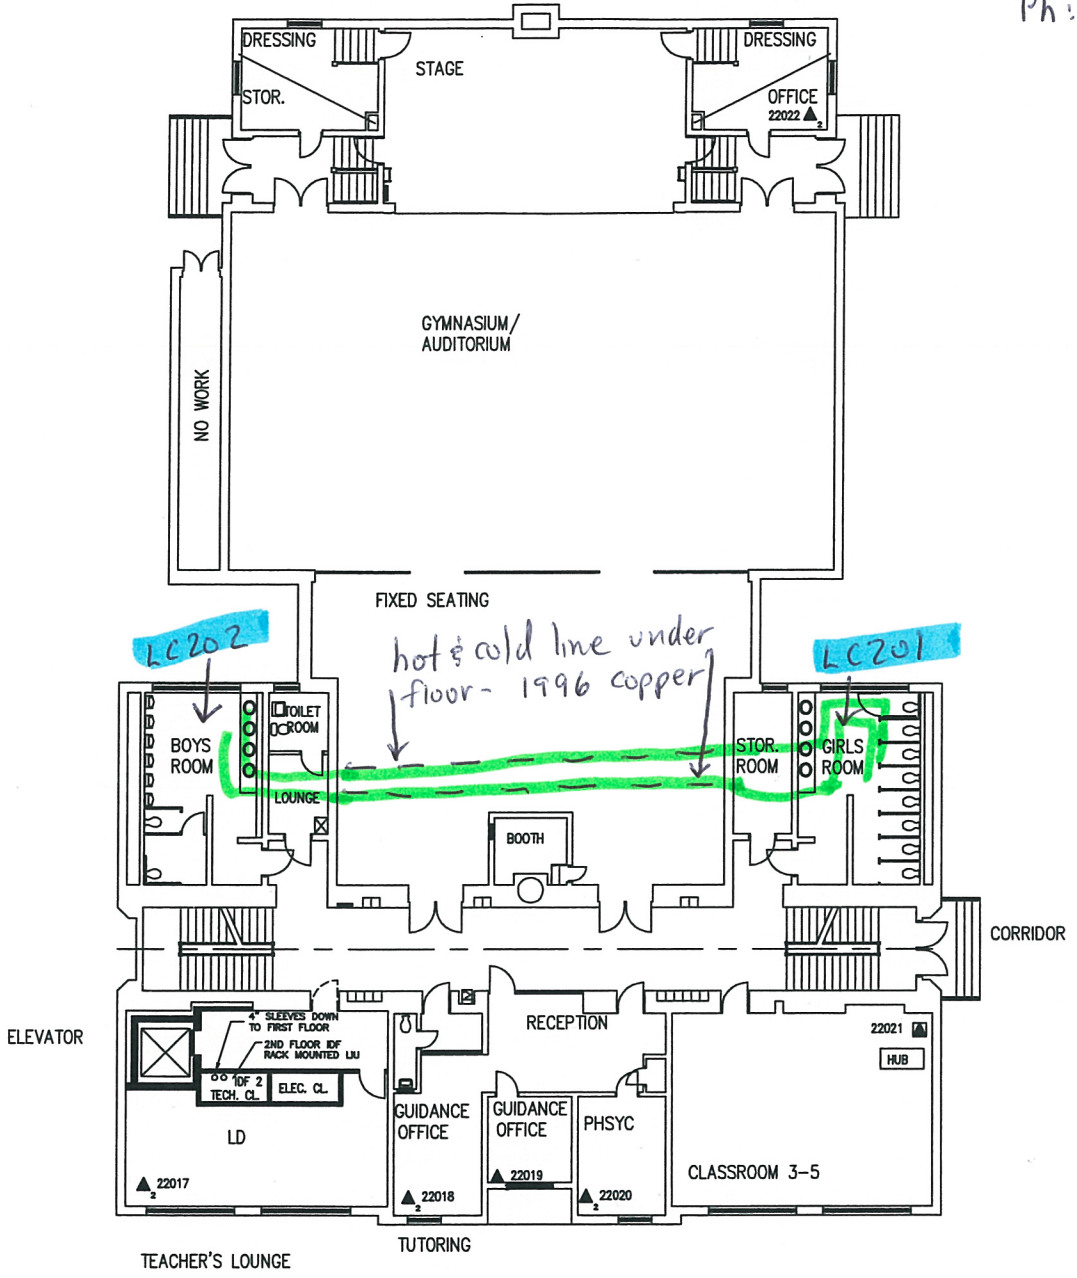


**SECOND LEVEL
TELECOMMUNICATIONS**
1/8" = 1'-0"

Key

FCBNN is the cable number defined on:
C/Floor
Cn Wiring Closet
NNN- Sequence Number

Voice/Data/Video Outlet (School Net)	Base	Future
Dual Outlet Voice/Data Outlet (2 Cat 5 UTP)	FCBNN	FCBNN
Single Outlet Data or Voice	FCBNN	FCBNN
Data Only Outlet Cabling Mounted	FCBNN	FCBNN
Telephone	EXTENSION NUMBER AS INDICATED	

Pb/Cn sampling point (LC 201-LC 205)

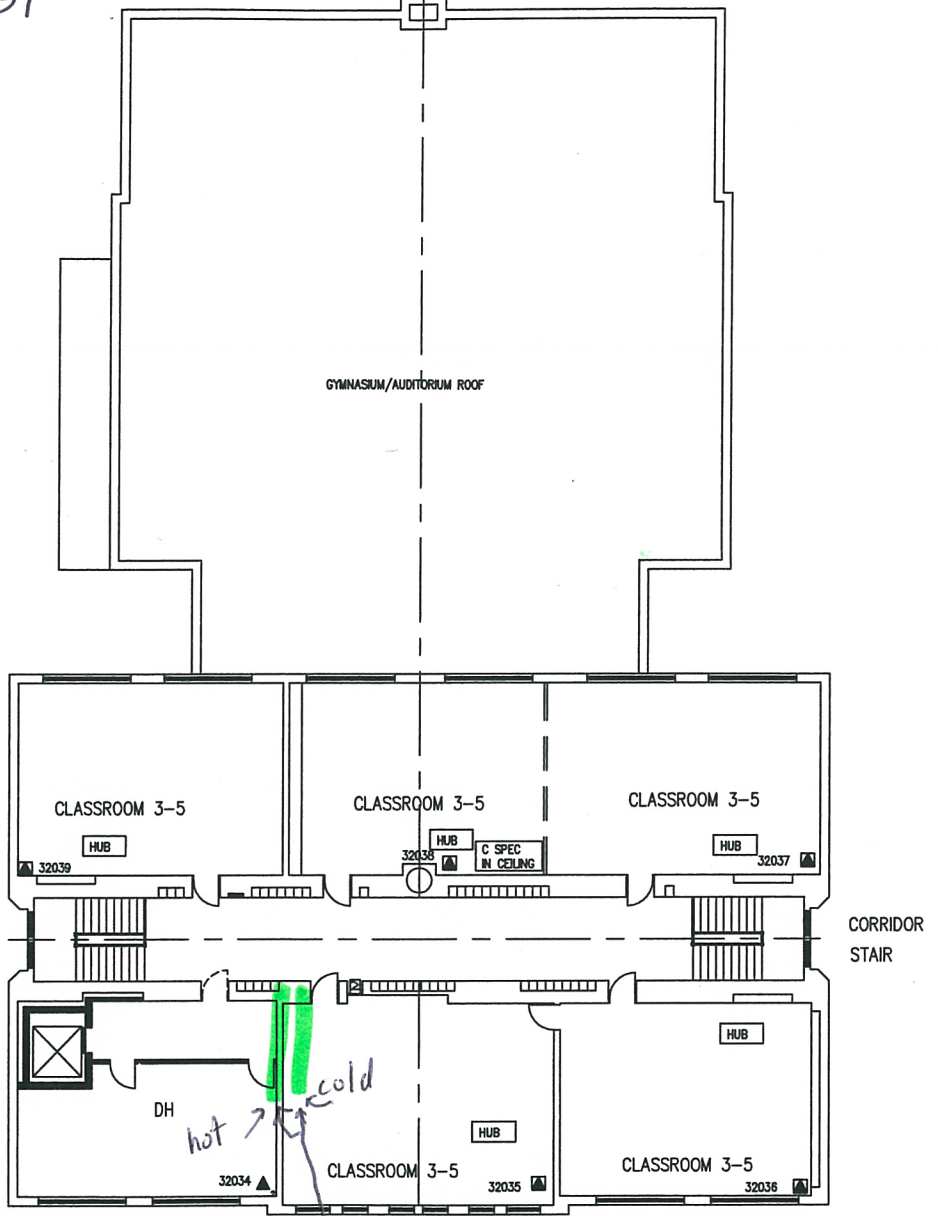

**THIRD LEVEL
TELECOMMUNICATIONS**
1/8" = 1'-0"

D.A.Y. 2017

