

RE: DELTA VILLAGE
Report
Drinking Water Program
Fulton County
PWS ID: OH2600311

Village of Delta

401 Main Street
Delta, Ohio 43515

www.villageofdelta.org

Phone: 419.822.3190
Fax: 419.822.3837

Lead Mapping


"Buildings in Ohio built prior to 1998 or that use plumbing material or solder manufactured before 1998 may have materials with greater than 8% lead and are at a higher risk of contributing lead to the drinking water than materials manufactured after 1998. In addition, buildings built and plumbing materials manufactured after 2014 were required to have less than 0.25% lead by weight and have the lowest risk for contributing lead to the drinking water. It should be noted however that, although prohibited, some use of leaded solder or leaded components may have occurred after the prohibitions became effective."

RECEIVED

MAR 08 2017

419-822-3190

Discover the Difference

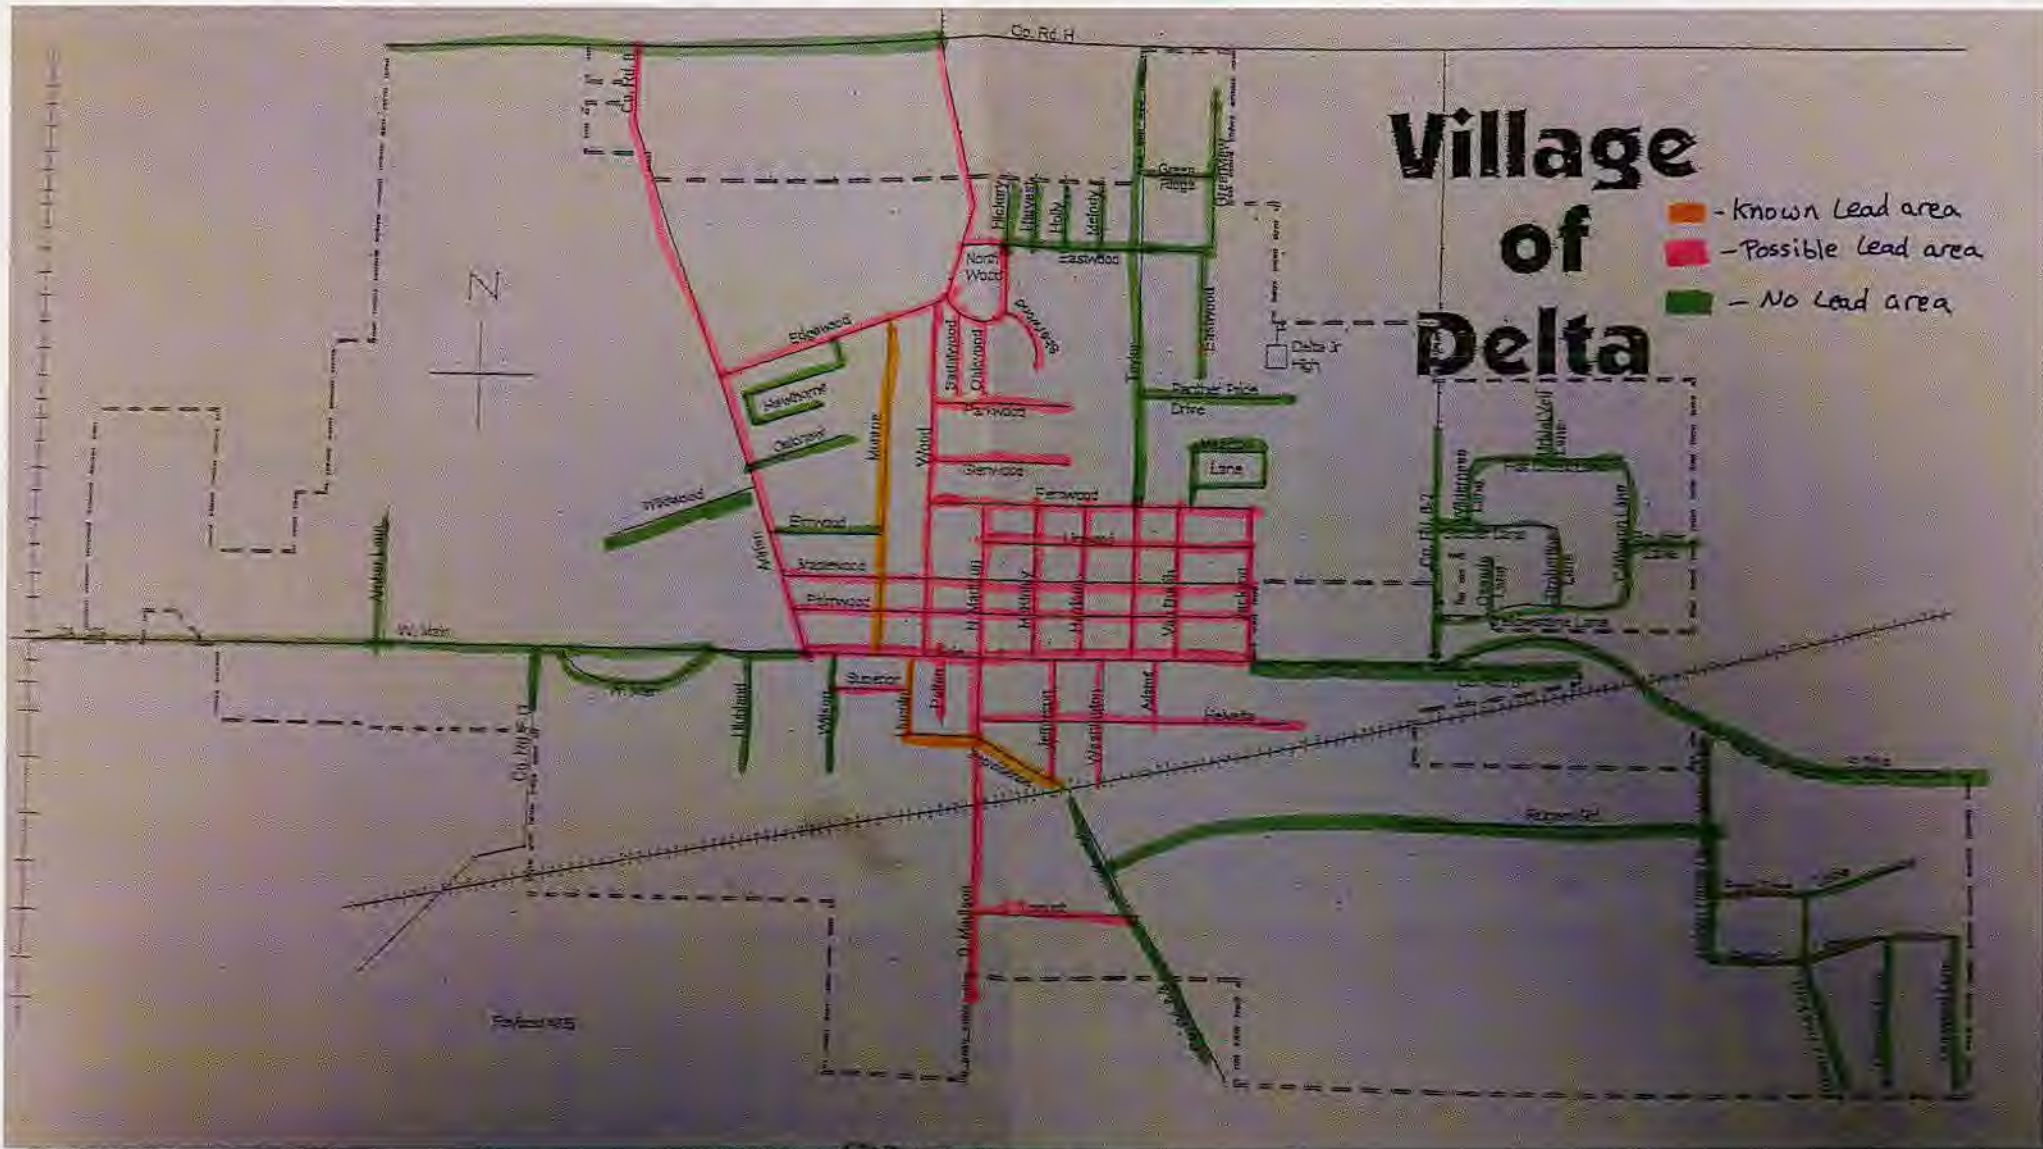

RECEIVED
 MAR 08 2017
 DDAGW - NWDO