

RE: CEDAR CREEK ESTATES  
Report  
Drinking Water Program  
Ottawa County  
PWS ID: OH6204112

Allen Park Mobile Court receives its drinking water from two wells located next to LC 201 on the lead and copper map. Once water is chlorinated and softened it then is ready for distribution. The distribution line starts as a four inch PVC pipe that is 3 foot plus underground. This pipe travels to the 4-line grid then reduces to a two inch PVC pipe where it connects to the grid. The lines then reduce to one inch PVC when it travels to the surface of the ground.

Locations LC 202, LC 203, LC 204, and LC 205 are all trailers that have a non-solder copper lines that start at shut off valve (ground level) and proceed to bottom of the trailers. Copper lines are connected with brass fittings with copper line being flared on both ends. The copper lines at this point are converted to PEX piping to supply water to the kitchen area, bathroom area as well as the hot water tank.

Location LC 201 is the only trailer with copper lines with solder. This location has a full basement unlike the four mentioned above. The water works is located in the northeast corner of this basement. All piping through this trailer are copper lines with solder.

**RECEIVED**

**MAR 08 2017**


**DDAGW - NWDO**

RECEIVED

MAR 08 2017

DDAGW - NWDO

Allen Park Motor Court / Cedar Creek Estates  
PWS# 6204112 24475 W. Reservation Line Rd  
Ottawa Co. Curtice OH 43412

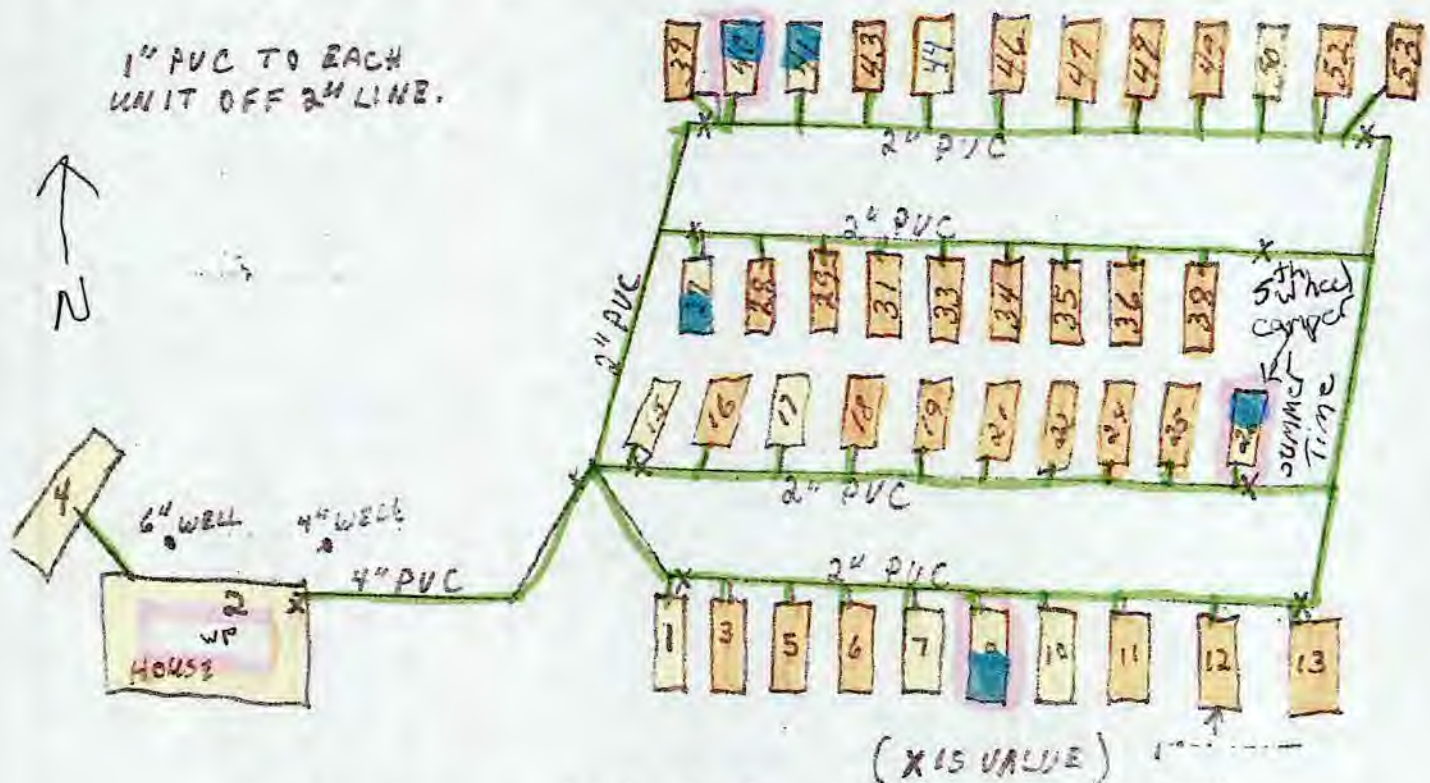

1" PVC TO EACH UNIT OFF 2" LINE.



Mobile homes look to be late 60's early 70's

- No Lead
- EMPTY LOTS
- sample site
- Possible Lead
- occupied